Federal RU 424-6

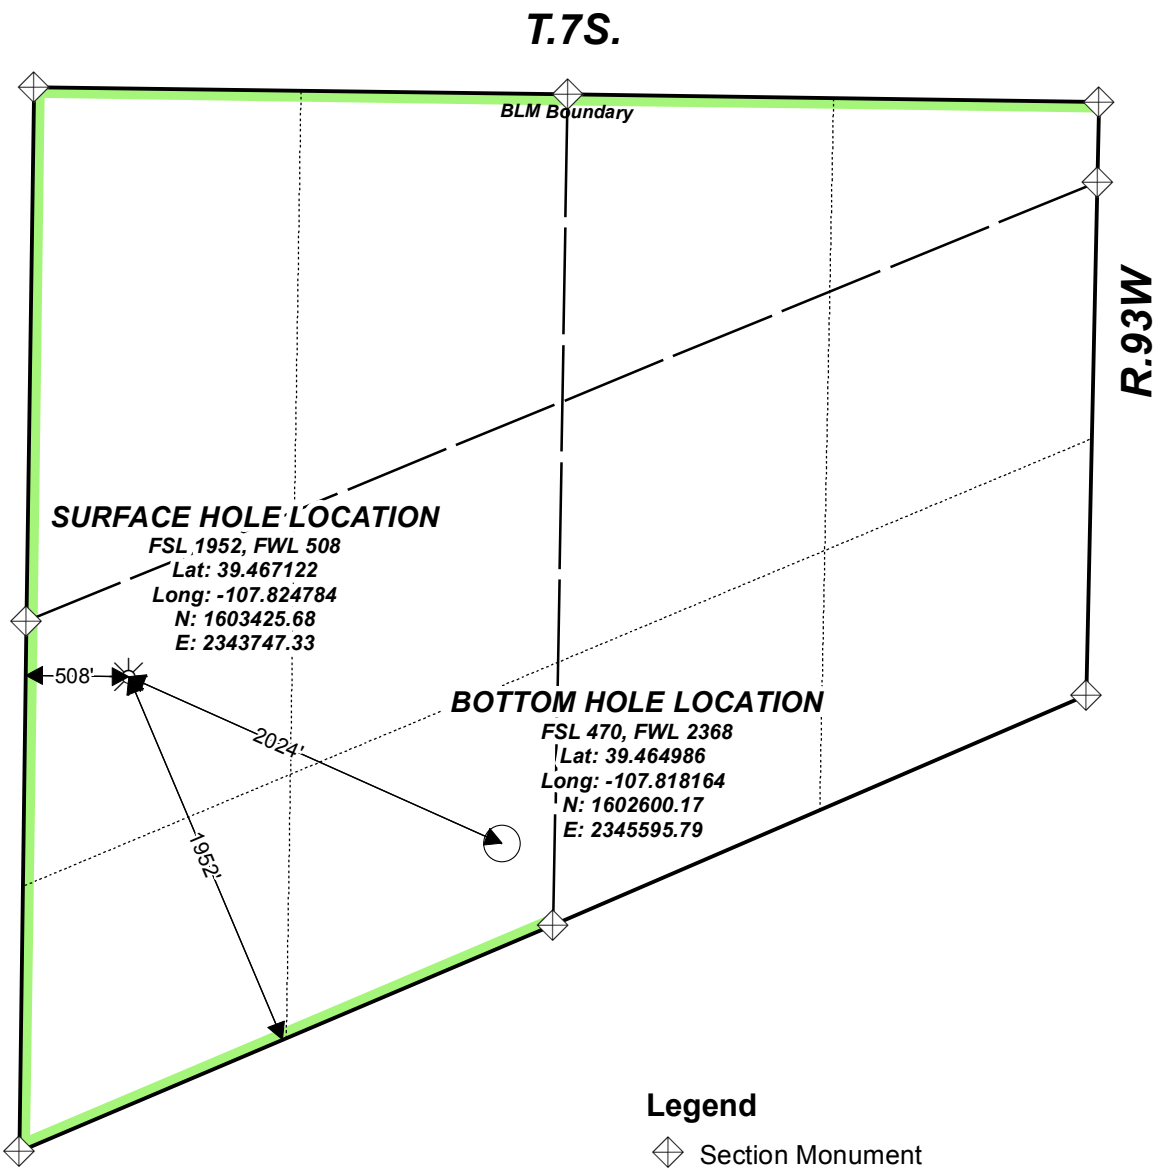

Legend

- Section Monument
- Surface Hole Location
- Bottome Hole Location

N

0 500 1,000 Feet

1 in. = 950 ft.

TERRA ENERGY PARTNERS

Map Date: 9/6/2016	**Well Location Plat** *TEP Rocky Mountain LLC*
Scale: 1 " = 950 '	*NW1/4 SW1/4, SECTION 6,* *T.7S., R.93W, of the 6th. P.M.* *GARFIELD COUNTY, COLORADO*
Page 1 of 1	

T:\Projects\PIC\Rulison\16\0906_RU 13-6_AB-LOC_Plats\RU_424-6_Plat.mxd atankersley 9/6/2016 5:50:03 PM