

Investment Equipment


WELLBORE DIAGRAM AFTER Re-Complete in Lansing

Well / Battery	Prospect Name	Total Depth	Est. Start Date
TRSU 801		4,260'	
SENE	Sec-Twn-Rng	Producing Horizon	County & State
	11-35S-46W	Lansing	Baca

WELLBORE DIAGRAM

General Info

Well History

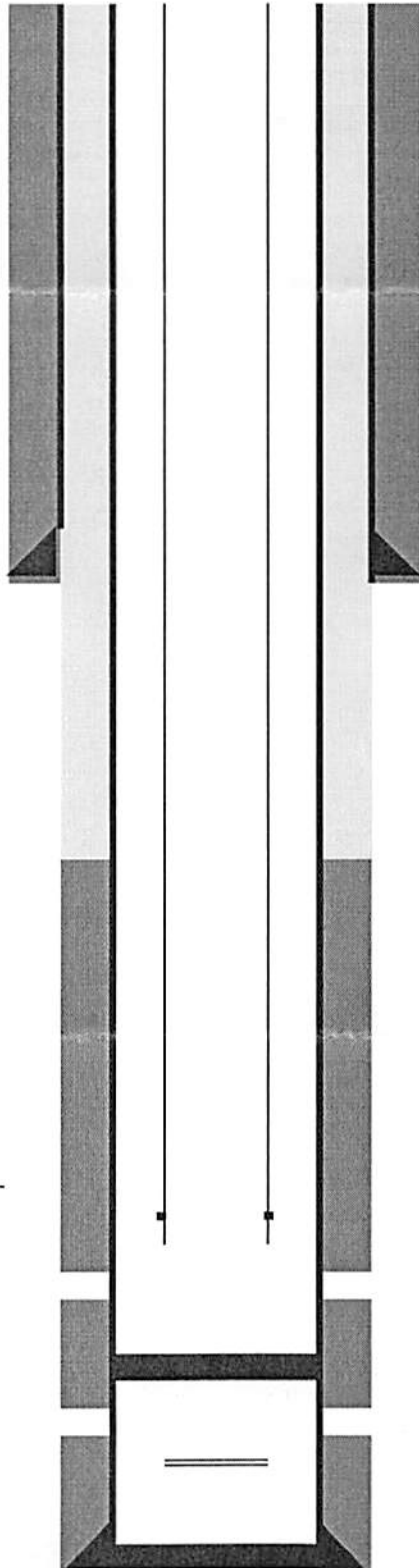

Surface Casing

8-5/8" 24# @ 1,654' in 12-1/4" Hole
650 sxs
TOC @ Surface

Tubing

2 3/8" "J"
at 3,400'

TOC Calculated 3,290'
175 sxs

Perforations

Lansing "A"
3,436' - 3,442'

CIBP @ 3,975'

Perfs @ 4,005' - 4,015'

Production Casing

5 1/2" 15.5 @ 4,269'
175 sxs