





Lat40°, Inc. 6250 W. 10th Street, Unit 2, Greeley, CO 970-515-5294

WELL LOCATION CERTIFICATE

BENNETT 6F-432

SECTION: 6
TOWNSHIP: 6N
RANGE: 64W
6TH. P.M.
WELD COUNTY, CO

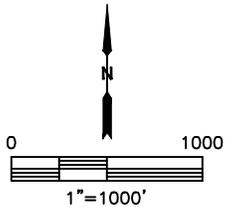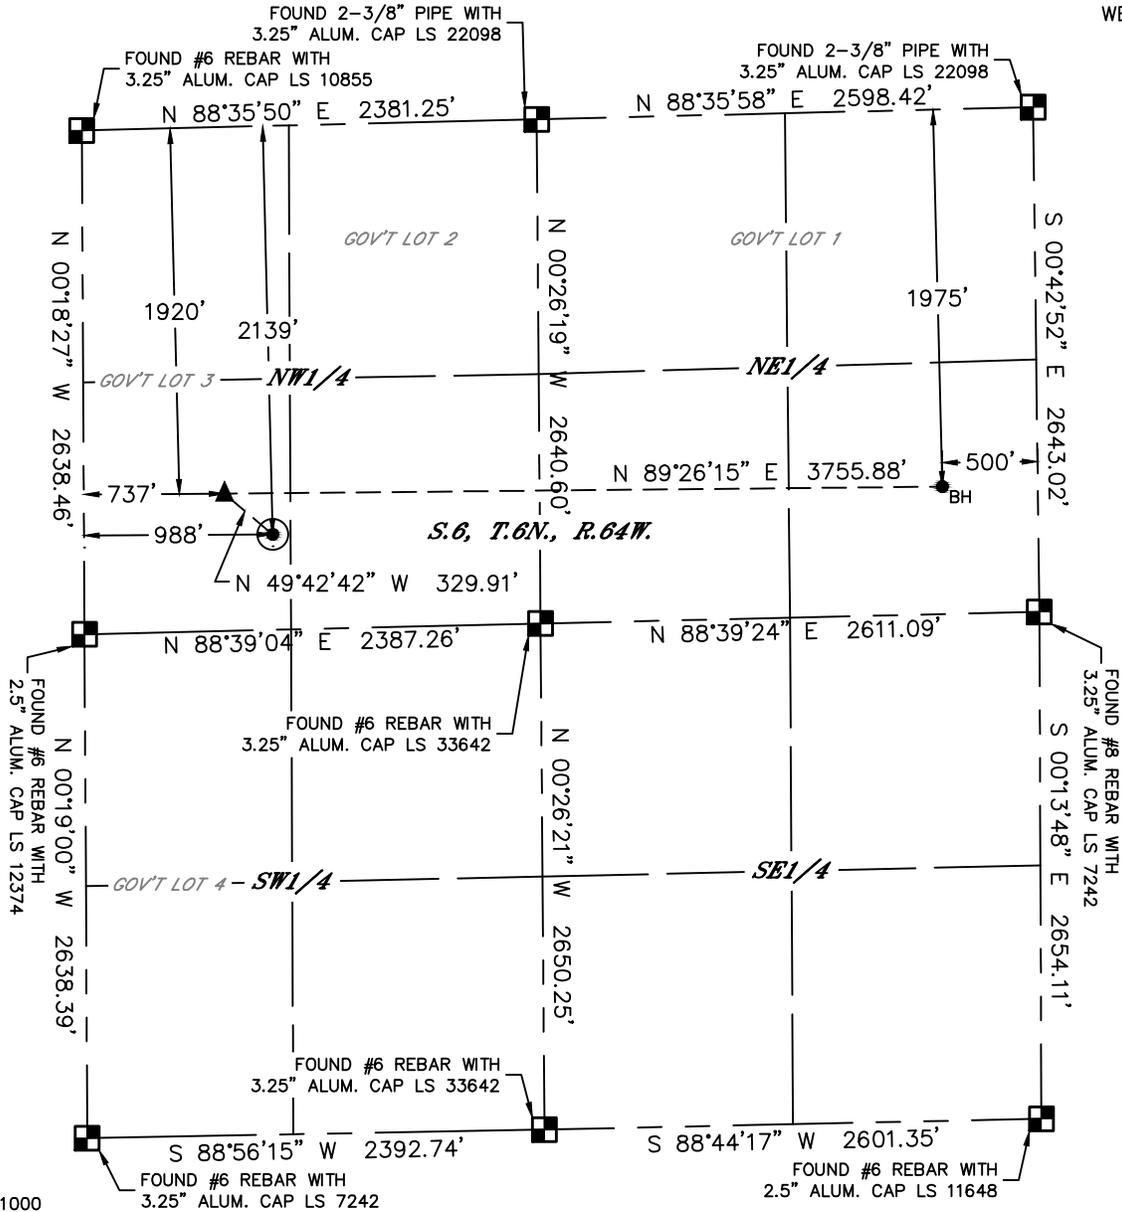

LEGEND

- = ALIQUOT MONUMENT AS DESCRIBED
- = CALCULATED POSITION
- = SURFACE HOLE LOCATION (SHL)
- = ENTRY POINT LOCATION (EP)
- = BOTTOM HOLE LOCATION (BHL)
- = EXISTING WELL
- = ABANDONED WELL

CLIENT: PDC ENERGY				LANDSMAN: MARK ALESSI					
INSTRUMENT OPERATOR: CASEY KOHOUT				SURVEY DATE: 2/3/2016		SURFACE USE: CROP LAND			
SHL FOOTAGE		SHL LAT°	SHL LONG°	SHL PDOP	SHL ELEV	SHL 1/4/1/4	SHL S-T-R		
2139	FNL	988	FWL	40.51627	-104.59802	1.7	4774	SWNW	6-6-64

BHL FOOTAGE		BHL LAT°	BHL LONG°	BHL S-T-R	EP LAT°	EP LONG°	EP S-T-R		
1975	FNL	500	FEL	40.51685	-104.58541	6-6-64	40.51686	-104.59892	6-6-64

NOTE:
 1) Bearings shown are Grid Bearings of the Colorado State Plane Coordinate System, North Zone, North American Datum 1983. The lineal dimensions as contained herein are based upon the "U.S. Survey Foot."
 2) Distances to section lines measured at 90 degrees from said section lines.
 3) Ground elevations are based on an observed GPS elevation (NAVD 1988 DATUM).
 4) Latitude and Longitude shown are (NAD 83 DATUM).
 5) IMPROVEMENTS: See LOCATION DRAWING for all visible improvements within 500' of oil and gas location.
 6) This map does not represent a boundary survey.

NEAREST CULTURAL ITEMS	
BUILDING	±661' W
BUILDING UNIT	±694' NW
HIGH OCCUPANCY BUILDING UNIT	±2925' NE
DESIGNATED OUTSIDE ACTIVITY AREA	5280'+
PUBLIC ROAD (COUNTY ROAD 49)	±977' W
ABOVE GROUND UTILITY	±976' NW
RAILROAD	5280'+
PROPERTY LINE	±231' W



Jason S. Allee—On behalf of Lat40°, Inc.
 Colorado Licensed Professional Land Surveyor No. 38479
 DATE: 8/23/2016
 PROJECT#: 2015157