


LONE MOUNTAIN PRODUCTION COMPANY
 SITE SECURITY DIAGRAM
 TEXAS MOUNTAIN FEDERAL NO. 2
 SECTION 16-T3S-R102W
 RIO BLANCO COUNTY, COLORADO
 LEASE C-0121116-C

Sample #1
 Pit /
 39° 47.108'
 108° 51.213'

#3
 39° 47.102'
 108° 51.219'

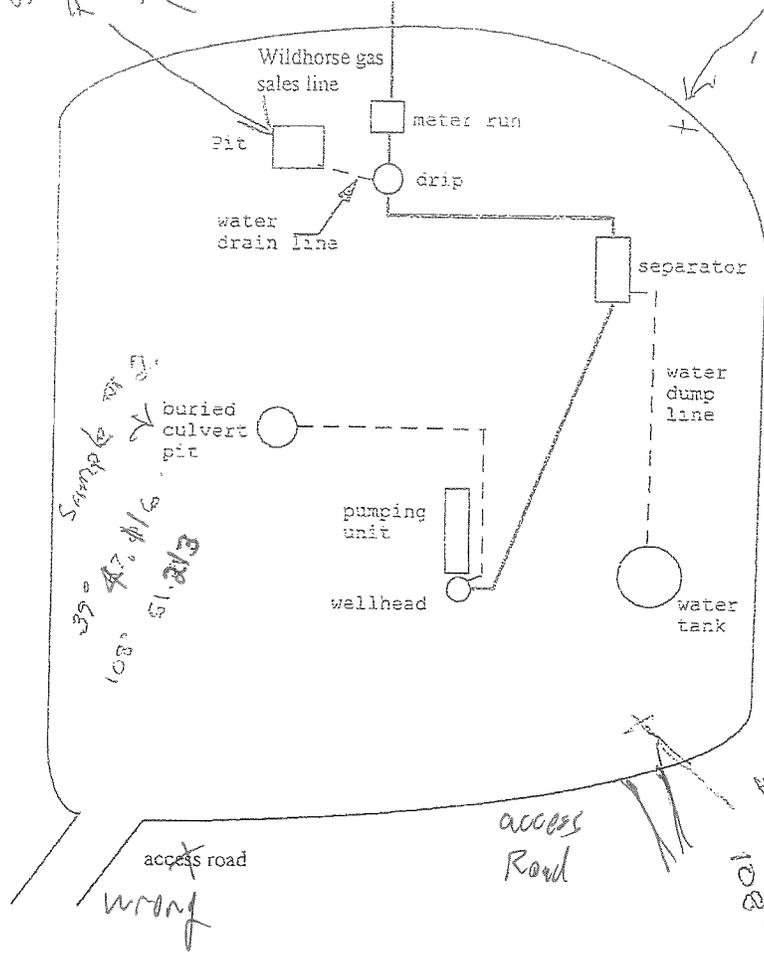

Sample #2
 39° 47.116'
 108° 51.213'

#4
 39° 47.127'
 108° 51.237'

North



Sample No. 4

dry hole marker

sample No. 2

sample No. 1

sample No. 3

99 ft

Texas Mtn No. 2 samples take September 13, 2016


<u>Sample No.</u>	<u>Latitude</u>			<u>longitude</u>			<u>Latitude</u>	<u>longitude</u>
	<u>degrees</u>	<u>minutes</u>	<u>seconds</u>	<u>degrees</u>	<u>minutes</u>	<u>seconds</u>	<u>decimal</u>	<u>decimal</u>
1	39	47	6.48	108	51	12.78	39.785133	108.853550
2	39	47	6.96	108	51	12.78	39.785267	108.853550
3	39	47	6.12	108	51	13.14	39.785033	108.853650
4	39	47	7.62	108	51	13.86	39.785450	108.853850

Sample No. 1 is from pit No. 107470 , taken from approximately 4'-4 1/2' deep.

Sample No. 2 is from pit No. 112693, taken from approximately 4'-4 1/2' deep.

Sample No. 3 is a control sample from the fill side of the location, taken from approximately 4'-4 1/2' deep.

Sample No. 4 is a control sample from the cut side of the location, taken from approximately 1' deep.

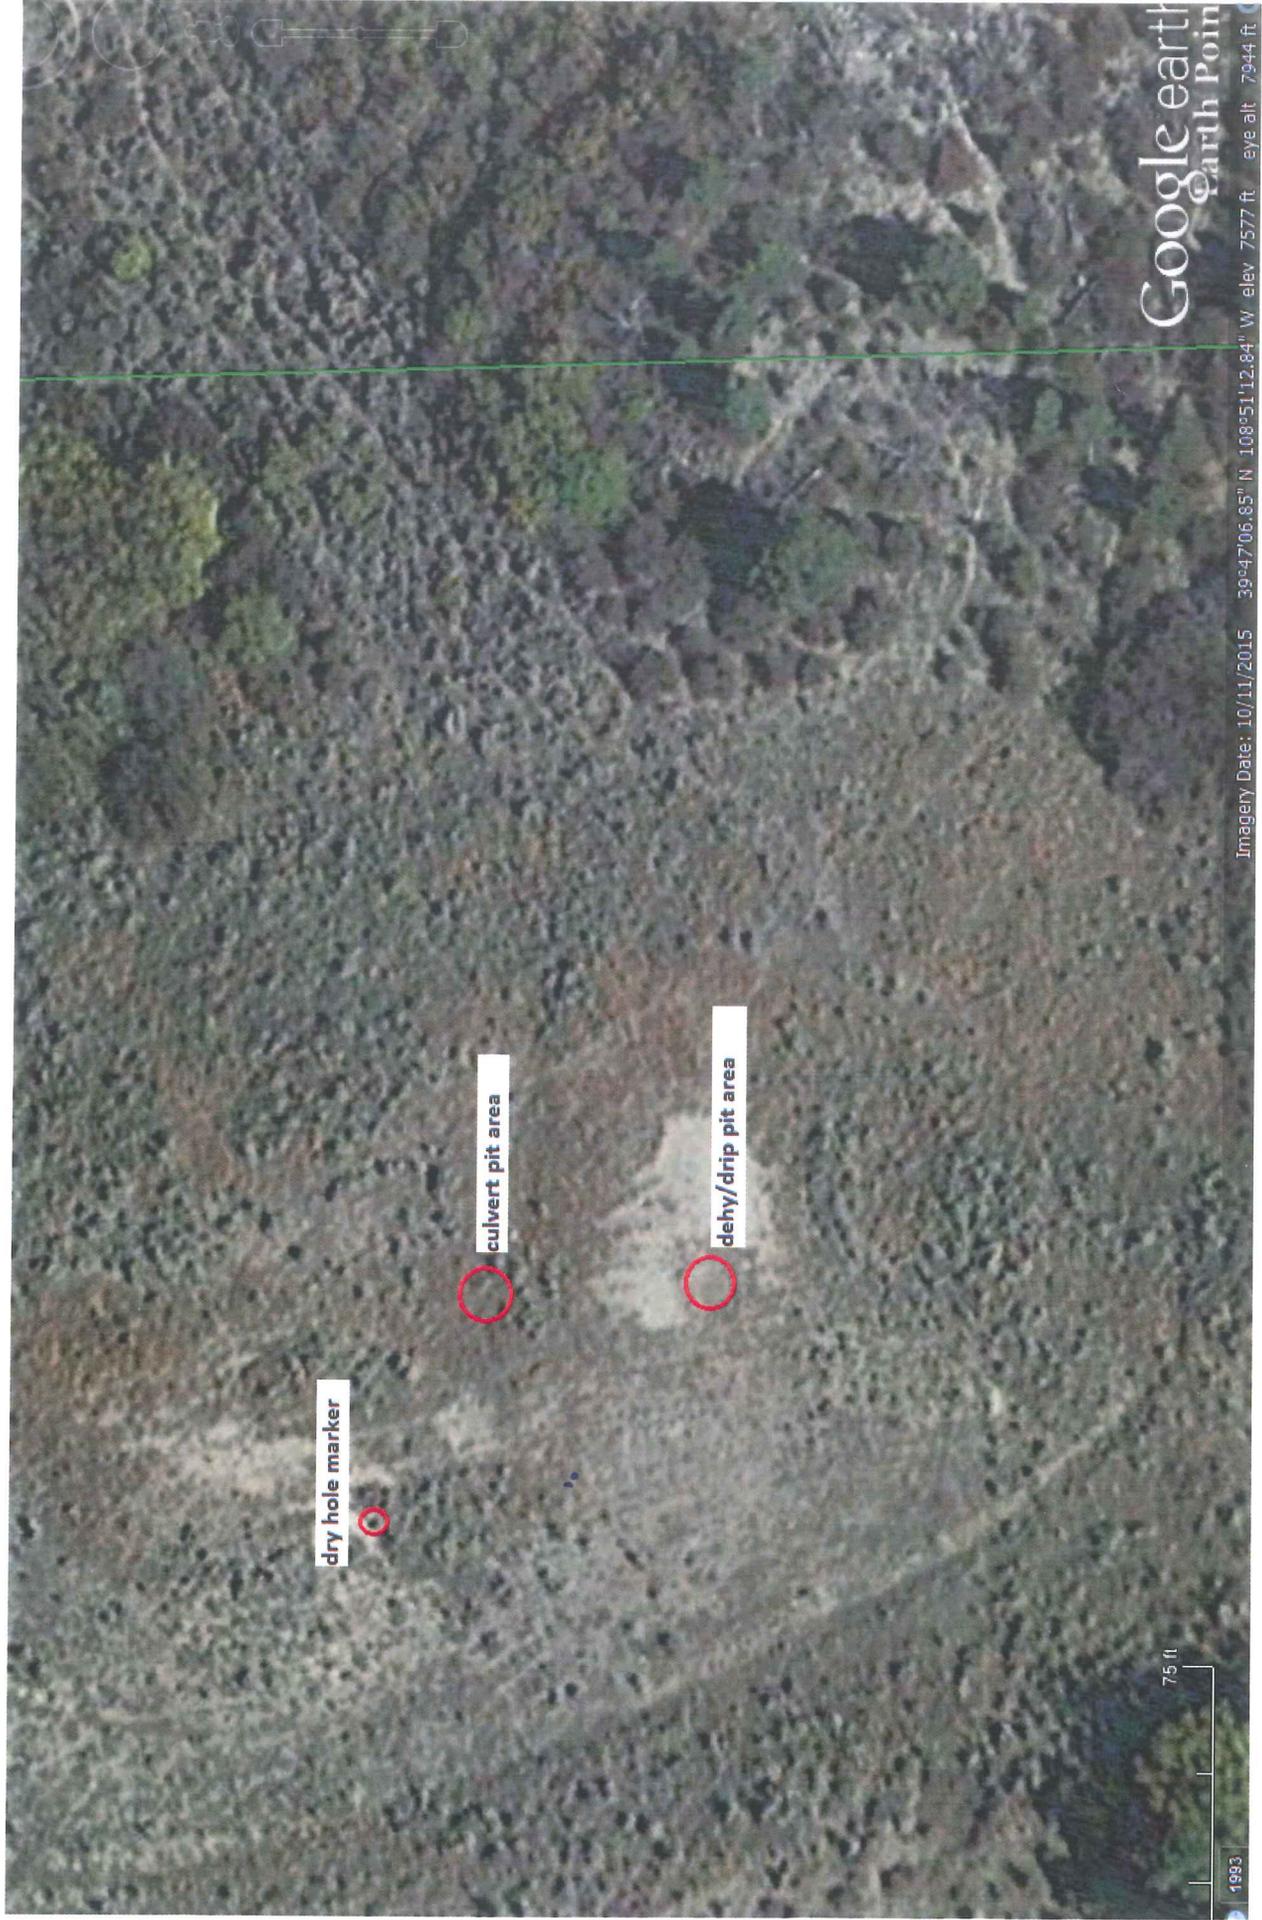

dry hole marker

culvert pit area

dehy/drip pit area

Google earth
Earth Point

Imagery Date: 10/11/2015 39°47'06.85" N 108°51'12.84" W elev 7577 ft eye alt 7944 ft

75 ft

1993