







Topographical Soil Collection Site Map

Filly 44-13 soil collection site map

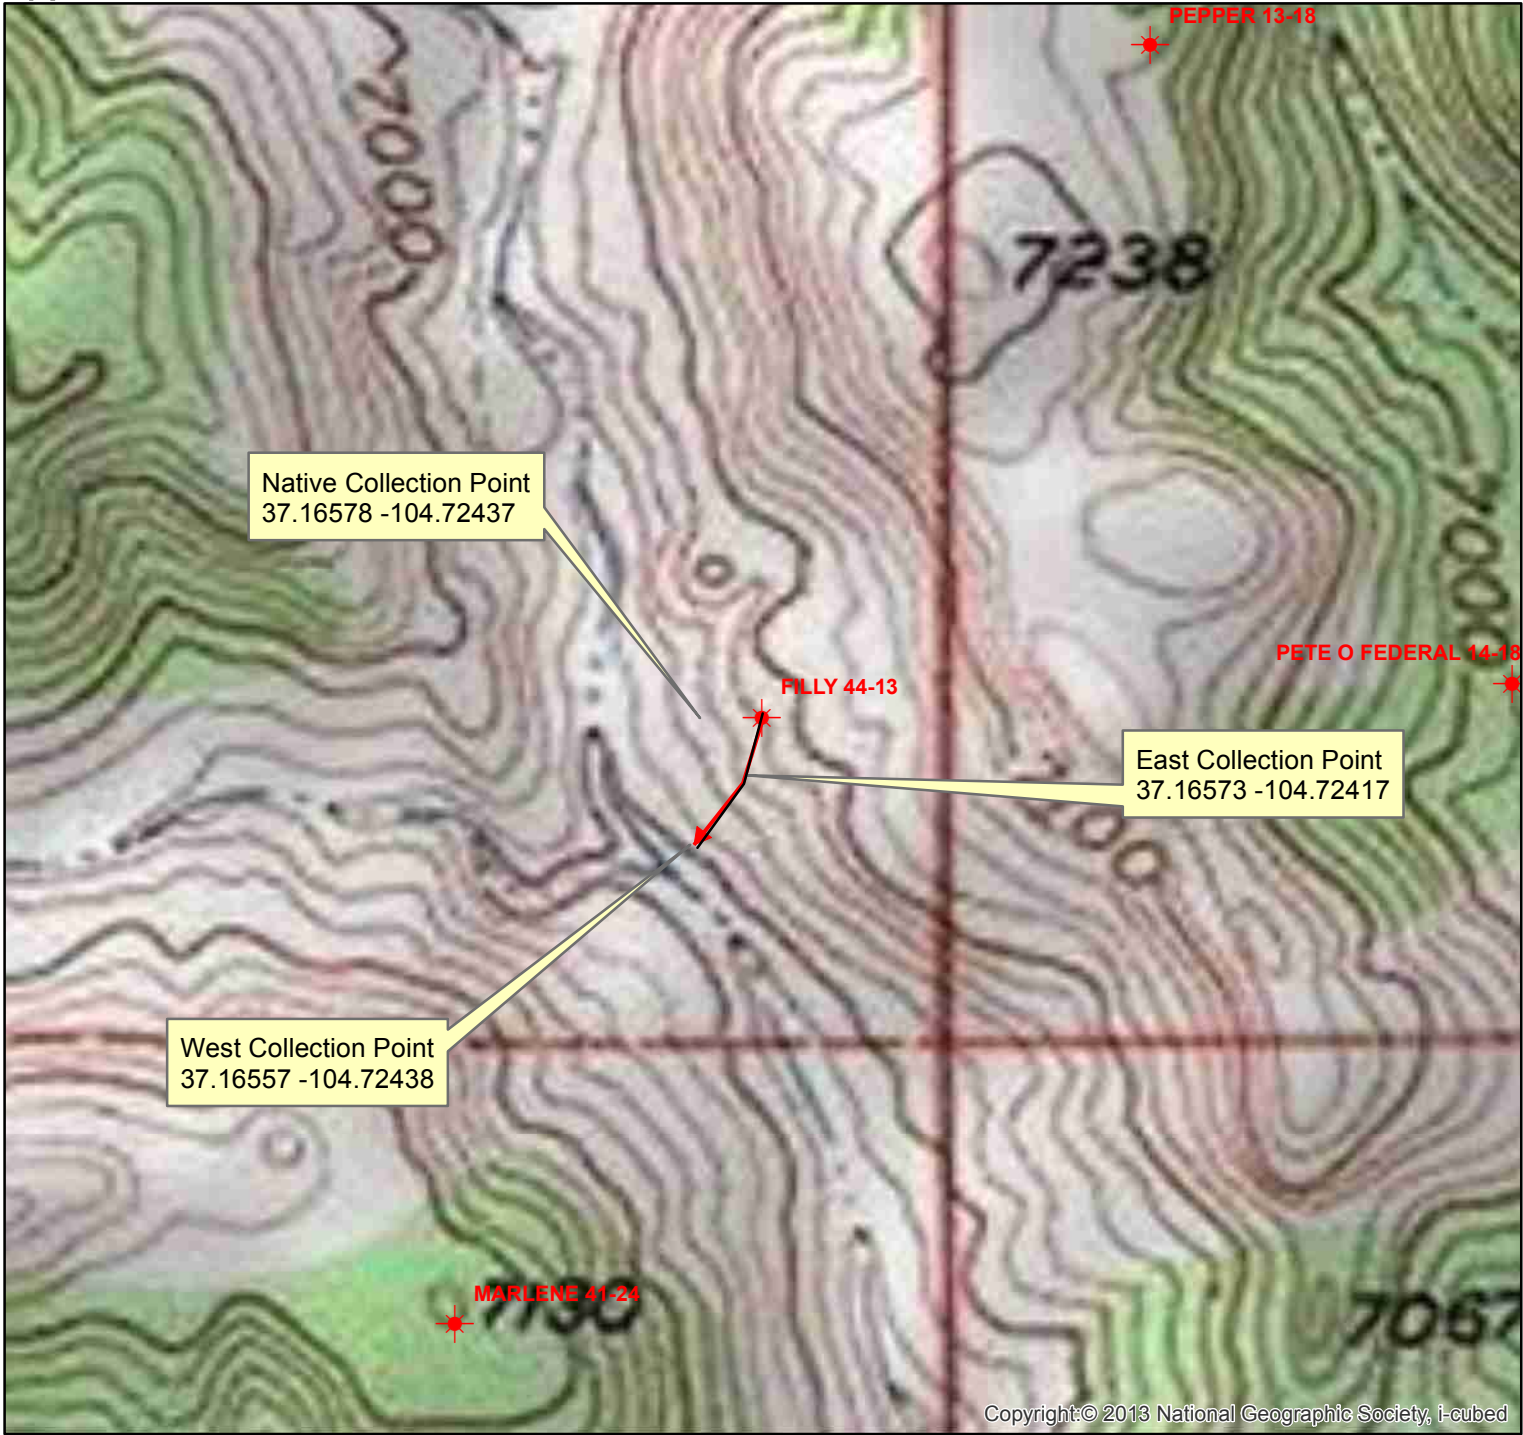

-  Permitted Well
-  Spill on location

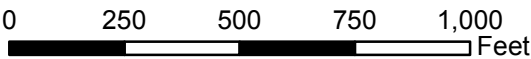

1:5,000