


WELL LOCATION FOR SCHNEIDER ENERGY SERVICES

T 9 N

N87°11'30"E
5315.96'

FOUND NO. 4 REBAR—NO CAP
REPLACED WITH NO. 6 REBAR
WITH 2-1/2" METAL CAP
BY LS 26964

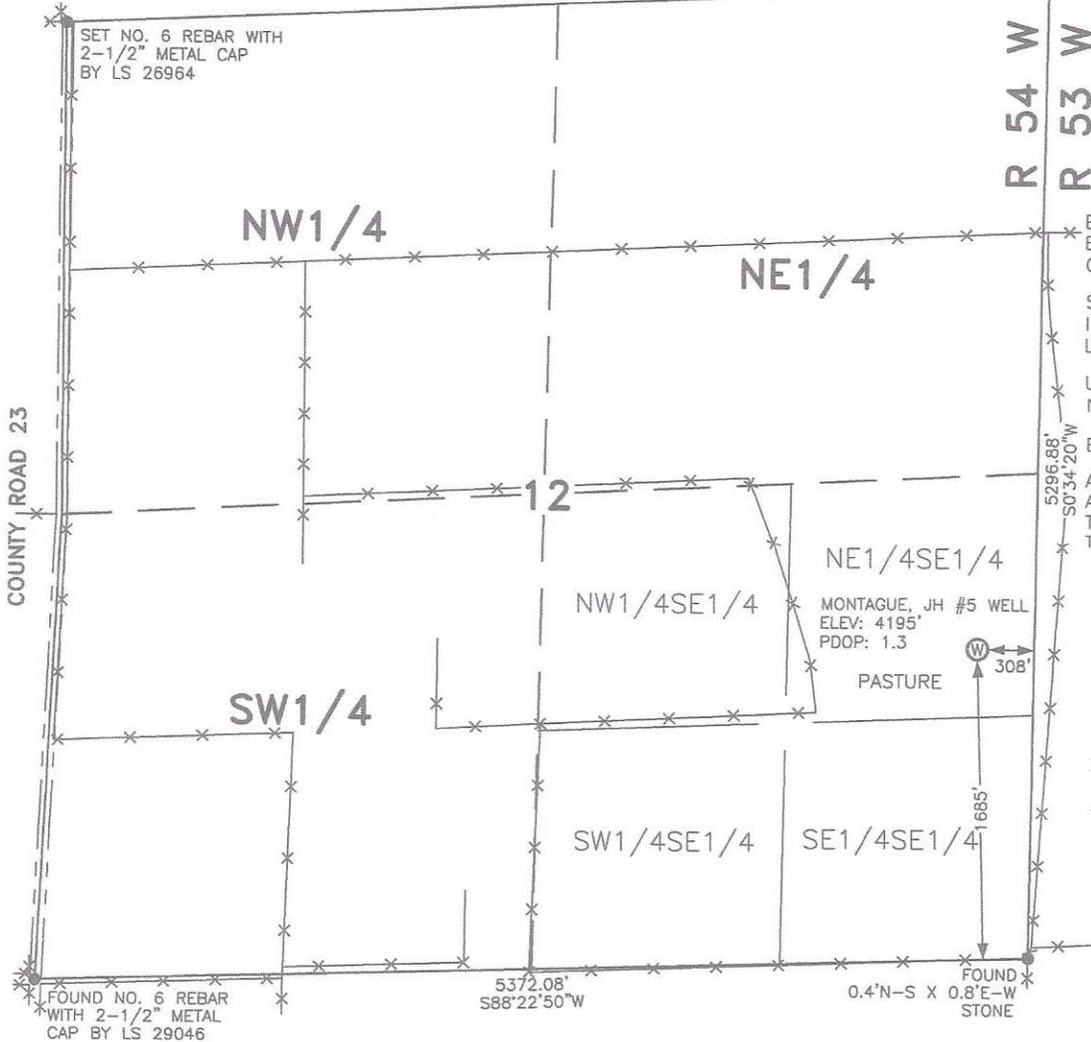


NOTES

- BEARINGS SHOWN HEREON ARE BASED UPON RTK GPS OBSERVATIONS
- SEE IMPROVEMENT PLAT FOR IMPROVEMENTS WITHIN 600' OF LOCATION.
- USGS QUAD MAP: NORTH STERLING RESERVOIR, COLO.
- ELEVATIONS BASED ON NAVD 1988
- ALL DISTANCES TO SECTION LINES ARE MEASURED PERPENDICULAR TO AND ARE AT RIGHT ANGLES TO SAID SECTION LINES.


LEGEND

- FIELD SURVEYED WELL LOCATION
- ROAD
- FENCE

THIS WELL LOCATION PLAT HAS BEEN PREPARED FOR SCHNEIDER ENERGY SERVICES TO LOCATE THE MONTAGUE, JH #5 WELL BEING 308 FEET FROM THE EAST LINE AND 1685 FEET FROM THE SOUTH LINE IN THE NE1/4SE1/4 OF SECTION 12, TOWNSHIP 9 NORTH, RANGE 54 WEST OF THE 6TH P.M., LOGAN COUNTY, COLORADO. THE SURFACE ELEVATION AT THIS POINT IS 4195 FEET. THIS IS NOT A LAND SURVEY PLAT.

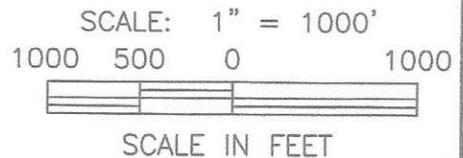

LEIBERT-McATEE & ASSOCIATES, INC.		
P.O. BOX 442		615 SOUTH TENTH AVENUE
STERLING, CO 80751		970-522-1960
FIELD DATE: 6-7-16	DWG DATE: 6-20-16	GPS OPERATOR: DARREN VEAL
MONTAGUE, JH #5	DWG NO. 910-16	SHEET 1 OF 1

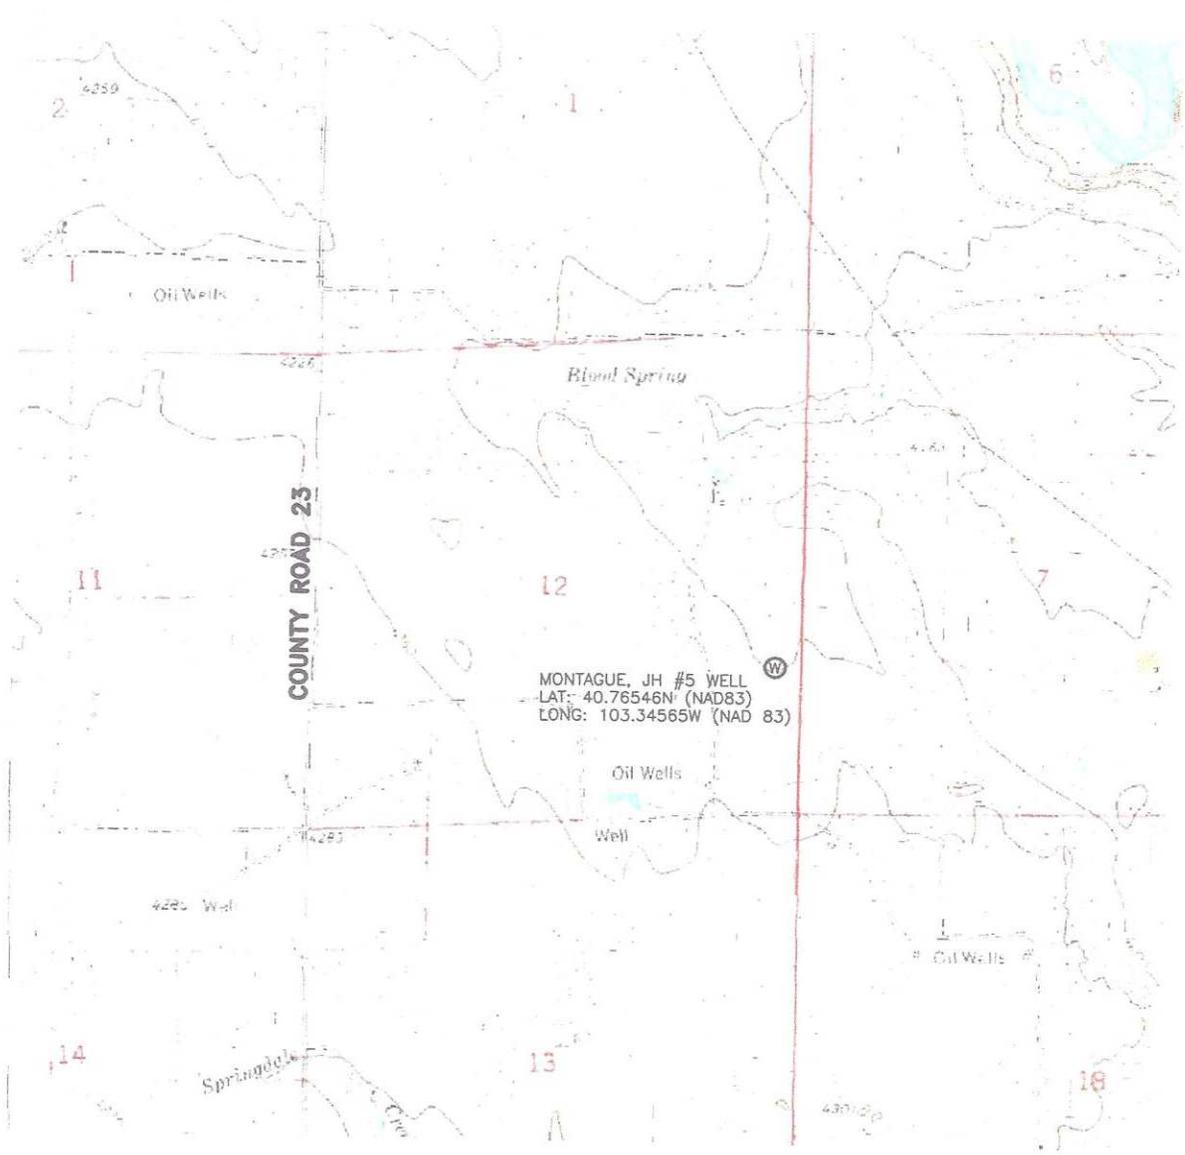

SCALE: 1"=2000'
0 1000 2000

SCALE IN FEET

IMPROVEMENTS



LEGEND


⊙ FIELD SURVEYED WELL LOCATION

— x — x — FENCE



SCALE: 1"=200'

0 100 200

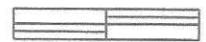

SCALE IN FEET