


Schneider Energy Services

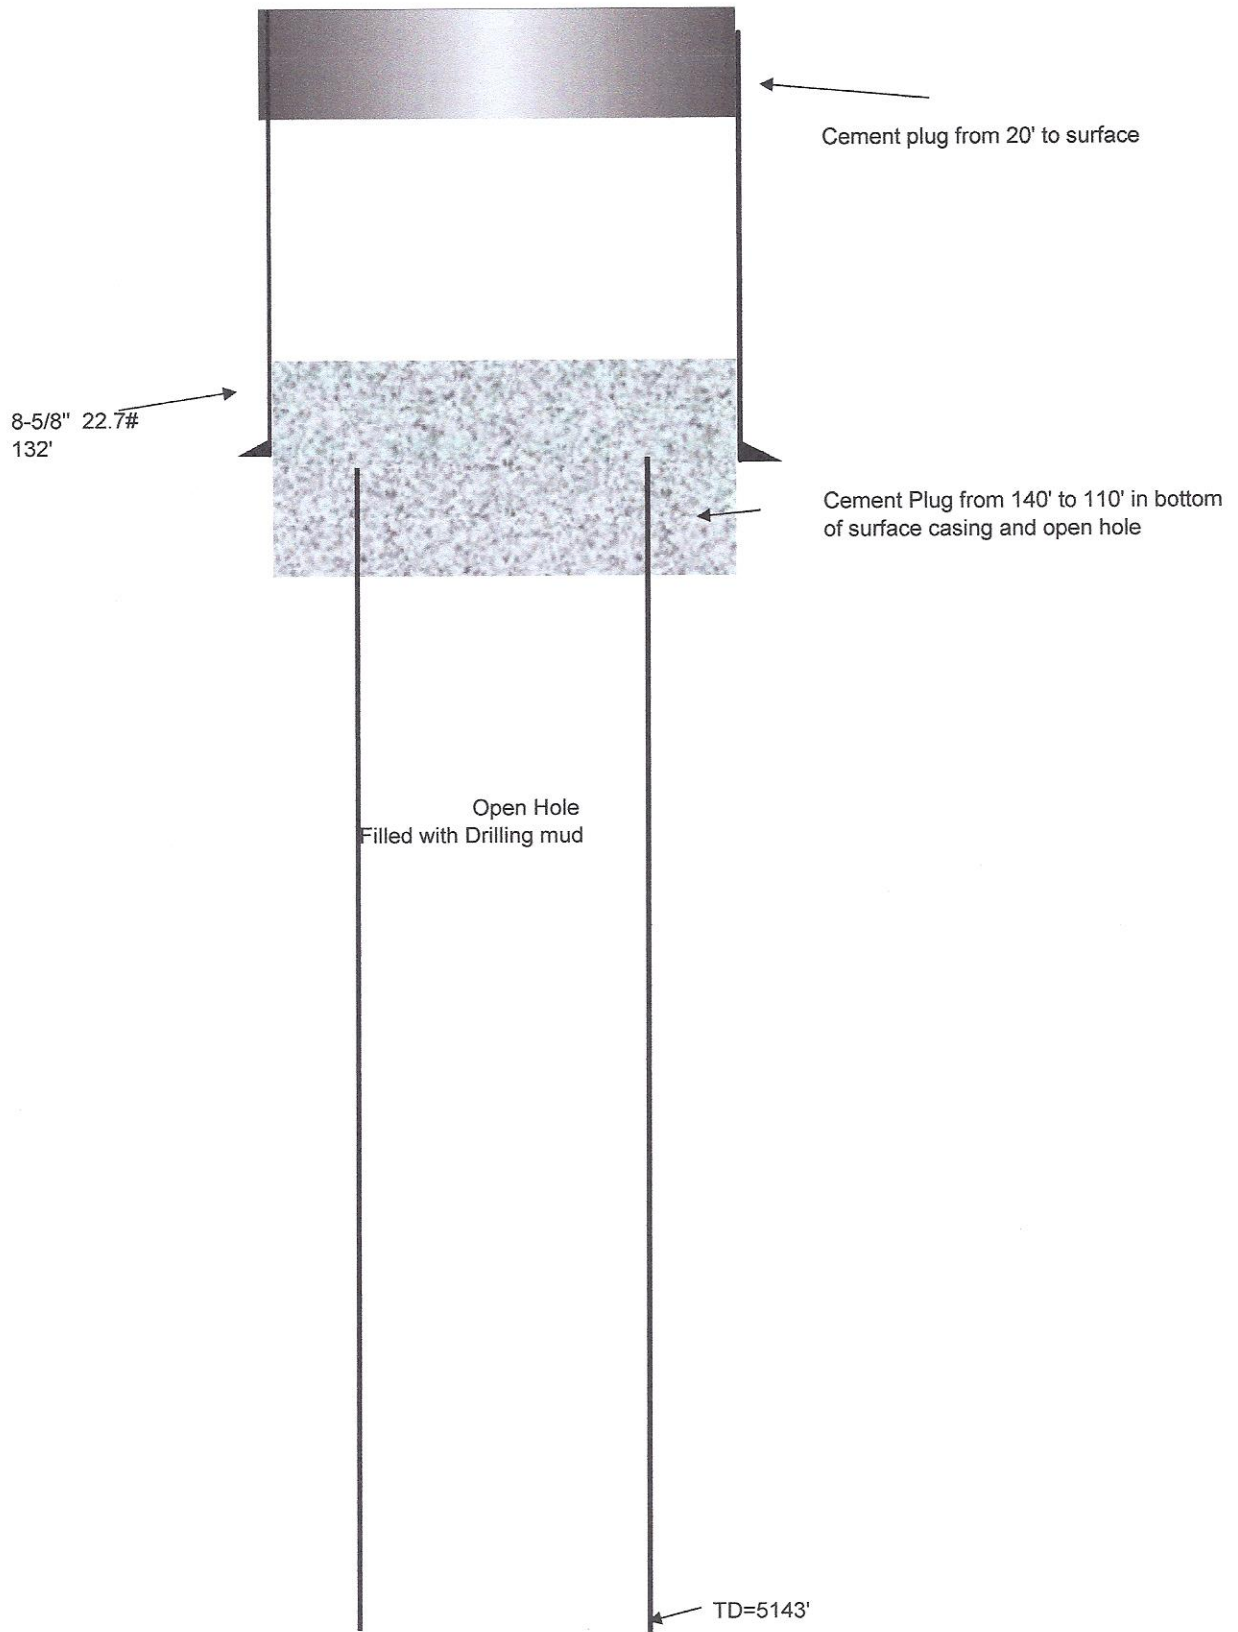

WELL NAME/NUMBER Montague #5	DESCRIPTION P & A		KB =4206' THF = CHF =
FIELD/LEASE/AREA Ceder Creek	PREPARED BY L. Camp	APPROVED/DATE	