



# WELL LOCATION CERTIFICATE

SECTION: 22  
TOWNSHIP: 9N  
RANGE: 59W

**APPROVED**

By Seth Gordon at 2:42 pm, 8/24/15

THIS MAP DOES NOT REPRESENT A BOUNDARY SURVEY

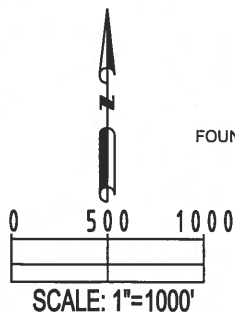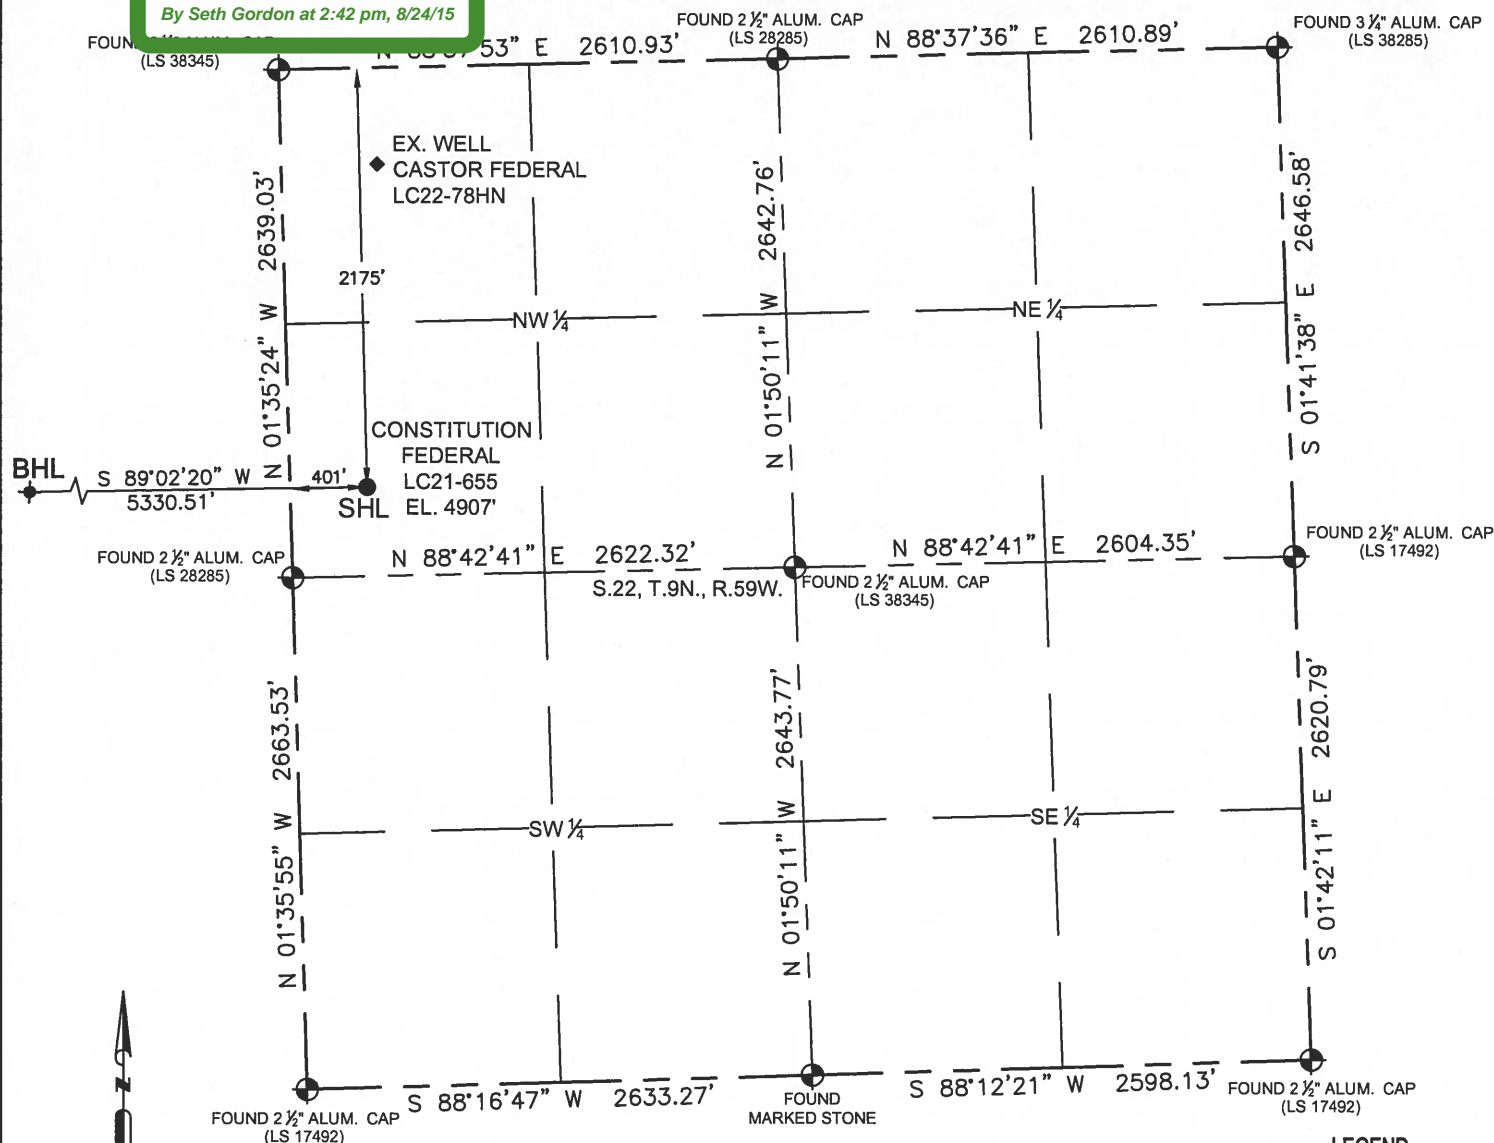

In accordance with a request from Brian James with Noble Energy Inc. Petroleum Field Services, LLC has determined the surface location of the CONSTITUTION FEDERAL LC21-655 to be 2175' from the NORTH line and 401' from the WEST line as measured at right angles from the section line of Section 22, Township 9 North, Range 59 West of the Sixth Principal Meridian, County of WELD, State of Colorado, and the bottom hole to be 2090' from the NORTH line and 330' from the WEST line as measured at right angles from the section line of Section 21, Township 9 North, Range 59 West of the Sixth Principal Meridian, County of WELD, State of Colorado.

I hereby state that this Well Location Certificate was prepared by me, or under my direct supervision, that the fieldwork was completed on 04/22/14 for and on behalf of Noble Energy Inc., that this is not a Land Survey Plat or an Improvement Survey Plat, and that it is not to be relied upon for the establishment of fence, building, or other future improvement lines.

SURFACE LOCATION:  
LATITUDE: 40.73745°N  
LONGITUDE: 103.97212°W  
PDOP: 2.8  
ELEV: 4907'  
¼ ¼: SW¼NW¼

BOTTOM HOLE:  
LATITUDE: 40.73745°N  
LONGITUDE: 103.99136°W

- LEGEND**
- = FOUND MONUMENT
  - = CALCULATED POSITION
  - = PROPOSED WELL
  - ◆ = BOTTOM HOLE
  - ◆ = EXISTING WELL

- Notes:
- 1) Bearings shown are Grid Bearings of the Colorado State Plane Coordinate System, North Zone, North American Datum 1983/2011. The lineal dimensions as shown herein are grid distances based upon the "U.S. Survey Foot." To get ground distances, multiply shown distance by 1.000240741.
  - 2) Ground elevations are based on an observed GPS elevation (NAVD 1988 DATUM).
  - 3) NEAREST EXISTING WELL IN SECTION 22 IS: CASTOR FEDERAL LC22-78HN, 1677' NE
  - 4) IMPROVEMENTS: See LOCATION DRAWING exhibit for all visible improvements within 500' of disturbed area.
  - 5) SURFACE USE: "RANGELAND"
  - 6) INSTRUMENT OPERATOR: TODD BAKEBERG
- Note:
- According to Colorado law, you must commence any legal action based upon any defect in this W.L.C. within three years after you first discover such defect. In no event, may any action based upon any defect in this survey be commenced more than ten years after the date of this certification shown hereon. (13-80-105 C.R.S.)
- NEAREST CULTURAL ITEMS:  
BUILDING 4465' NW  
BUILDING UNIT 4365' NW  
HIGH OCCUPANCY BUILDING UNIT 5280'+  
DESIGNATED OUTSIDE ACTIVITY AREA 5280'+  
PUBLIC ROAD 2164' N  
ABOVE GROUND UTILITY 434' W  
RAILROAD 5280'+  
PROPERTY LINE 401' W


SHEET 1 OF 2

FIELD DATE:  
04-22-14

DRAWING DATE:  
06-11-15

DRAWN BY:  
MDCL



CHECKED BY:  
CSG

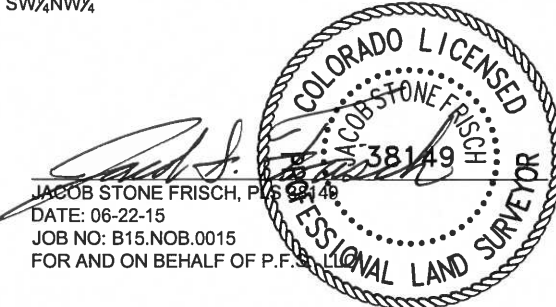

# WELL LOCATION CERTIFICATE

THIS MAP DOES NOT REPRESENT A BOUNDARY SURVEY

SECTION: 22  
TOWNSHIP: 9N  
RANGE: 59W

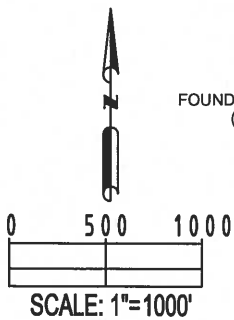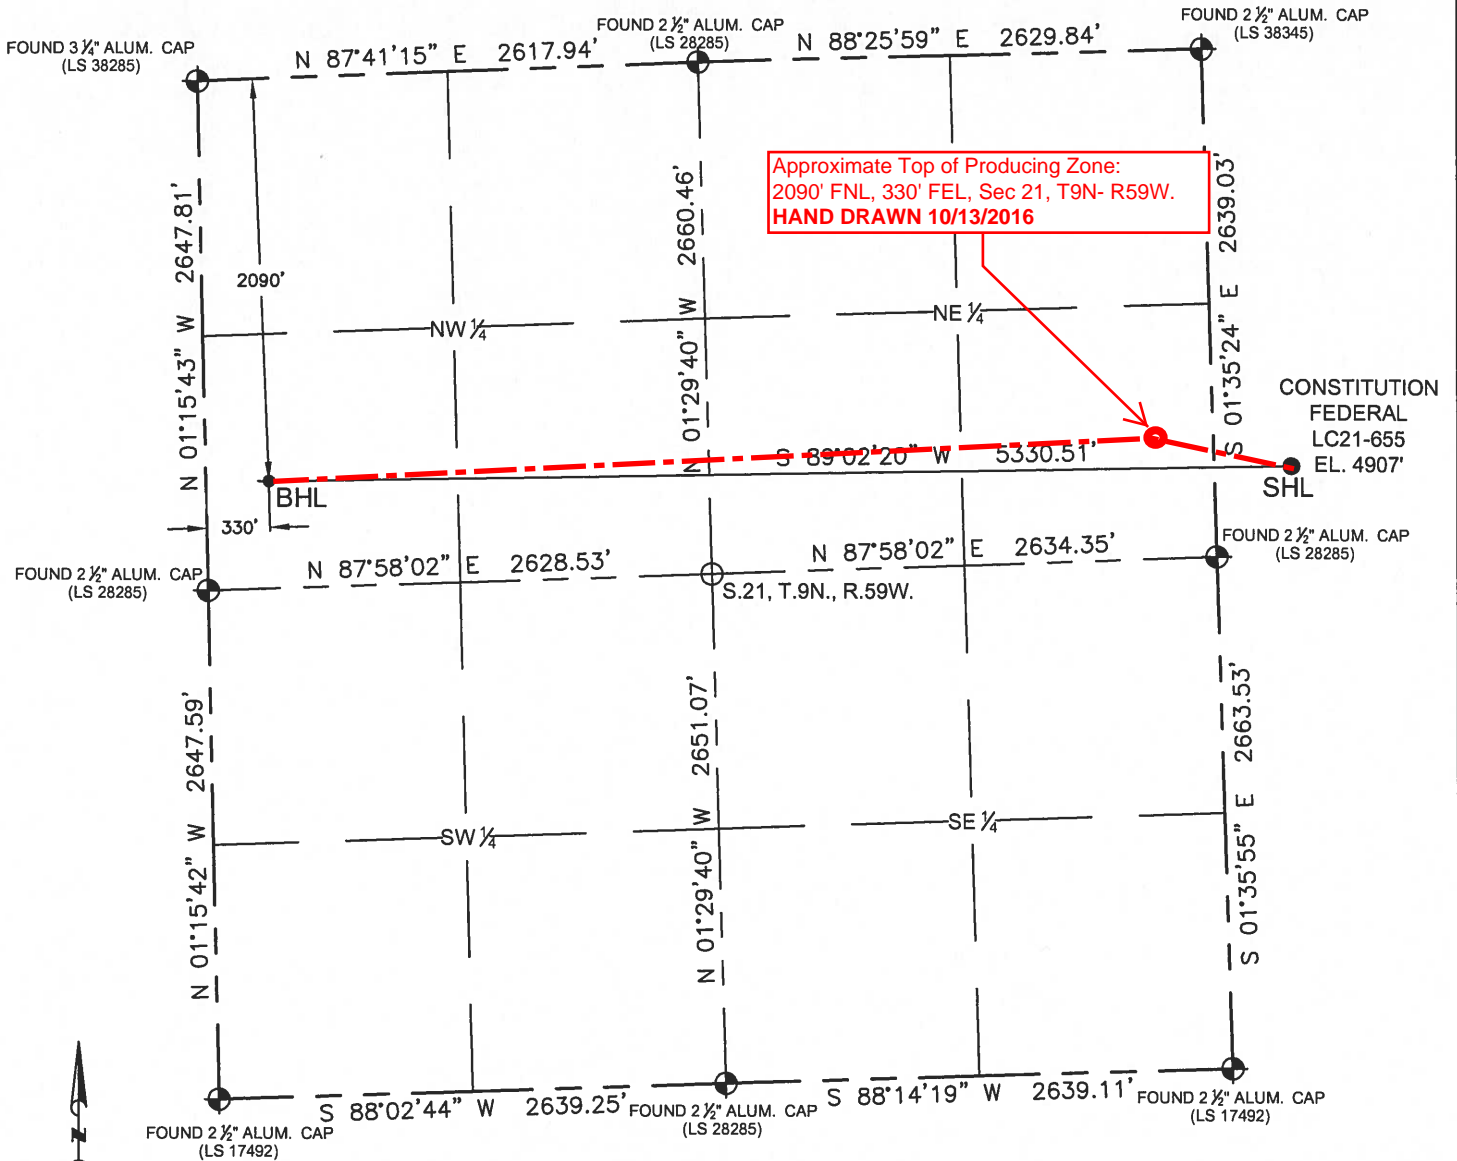

## LEGEND

- = FOUND MONUMENT
- = CALCULATED POINT
- = PROPOSED WELL
- ◆ = BOTTOM HOLE
- ◆ = EXISTING WELL

Note:  
According to Colorado law, you must commence any legal action based upon any defect in this W.L.C. within three years after you first discover such defect. In no event, may any action based upon any defect in this survey be commenced more than ten years after the date of this certification shown hereon. (13-80-105 C.R.S.)

SHEET 2 OF 2

FIELD  
DATE:  
04-22-14

DRAWING  
DATE:  
06-11-15

DRAWN BY:  
MDCL

CHECKED BY:  
CSG

JACOB STONE FRISCH, P.S. 38149  
DATE: 06-22-15  
JOB NO: B15.NOB.0015  
FOR AND ON BEHALF OF P.F.S. LLC

