


Wellbore Schematic Input Report

Well Name: MCKENNEY 13-21

VERTICAL - ORIGINAL HOLE, 11/5/2016 11:03:39 AM

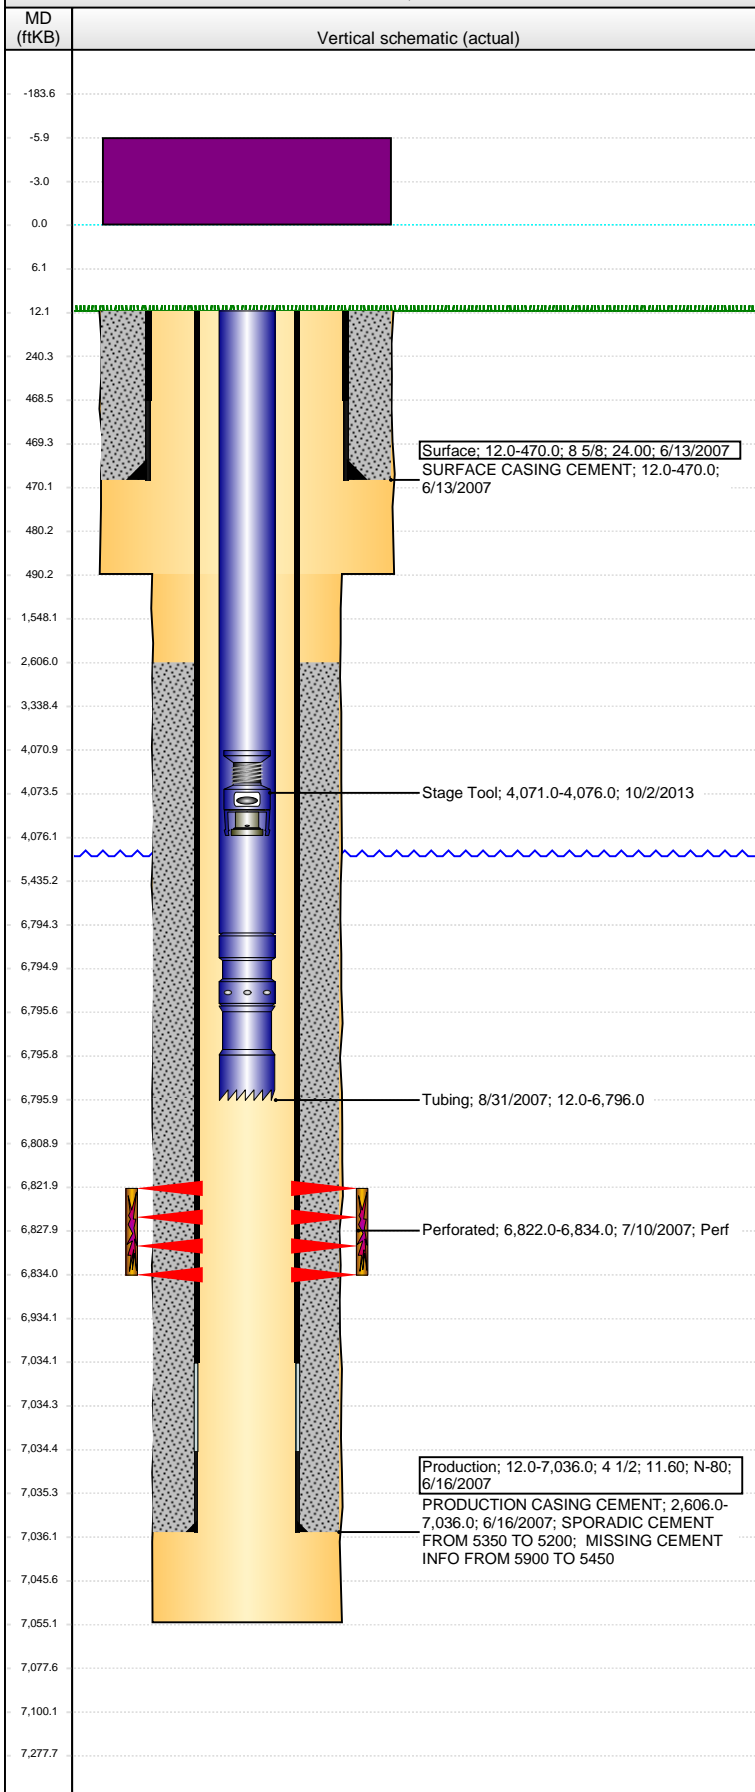

Well Header

API 05-123-25292	Business Unit DJ BASIN	District 15	Well Config VERTICAL
Original KB Elevation (ft) 4,681	KB - GL / MSL (ftKB) 12.00	Spud Date 6/12/2007	P & A Date

Comment

DISCREPANCY: LATEST PBTD DEEPER THAN TD

Directions To Well

Congressional Location

Quarter 3 NE	Quarter 4 NW	Section 13	Township 6	Twonship N/S Dir N	Range 64	Range E/W Dir W
-----------------	-----------------	---------------	---------------	-----------------------	-------------	--------------------

Bottom Hole Location

North-South Distance (ft)	From N or S Line	East-West Distance (ft)	From E or W Line
---------------------------	------------------	-------------------------	------------------

Plug Back Total Depths

Date	Depth (ftKB)	Method	Com
6/16/2007	7,021.0	TAG	FLOAT SHOE W/ BAFFLE
7/13/2007	6,989.0	CASED HOLE LOG	DEPTH LOGGER ON CBL
8/17/2007	7,100.0	TAG	CLEAN OUT TO LAND TUBING

Wellbore Sections

Section Des	Size (in)	Act Top, MD (ftKB)	Act Btm, MD (ftKB)
SURFACE	12 1/4	12	490
PRODUCTION	7 7/8	490	7,055

Zone Statuses

Zone Name	Status Date	Status	Fluid Type	Job	Prod Method
CODELL	7/30/2007	PR		DRILLING/CO...	
CODELL	4/24/2010	PR	Water		Flowing
CODELL	3/22/2016	PR			

Casing Strings

Surface, 470.0ftKB

Casing Description	Run Date	OD (in)	Wt/Len (l...)	Grade	Top, MD (ft...)	MD (ftKB)
Surface	6/13/2007	8 5/8	24.00		12.0	470.0

Production, 7,036.0ftKB

Casing Description	Run Date	OD (in)	Wt/Len (l...)	Grade	Top, MD (ft...)	MD (ftKB)
Production	6/16/2007	4 1/2	11.60	N-80	12.0	7,036.0

Cement

Description	Top Depth (ftKB)	Bottom Depth (ftKB)
SURFACE CASING CEMENT	12.0	470.0
Description	Top Depth (ftKB)	Bottom Depth (ftKB)
PRODUCTION CASING CEMENT	2,606.0	7,036.0

Tubing Strings

Tubing Description	Run Date	String...	ID (in)	Wt (lb/ft)	Grade	Len (ft)	Set De...
Tubing	8/31/2007	2 3/8				6,784.00	

Tubing Components

Item Des	OD (in)	Wt (lb/ft)	Grade	Jts	Len (ft)	Btm (ftKB)	Btm (TVD) (ftKB)
Tubing	2 3/8			221	6,782.40	6,794.4	
Seal Nipple	2 3/8			1	1.10	6,795.5	
Notched collar	2 3/8			1	0.50	6,796.0	

Perforation Data

Zone	Bnch/St g	Entered Shot Total	Top (ftKB)	Btm (ftKB)	Date
CODELL, ORIGINAL HOLE		48	6,822.00	6,834.00	7/10/2007

Stimulations & Treatments

Date	Zone	Primary Job Type
7/11/2007	CODELL, ORIGINAL HOLE	DRILLING/COMPLETION - ORIGINAL
Technical Result	Tech Result Details	Tech Result Note

Comment

Other In Hole

Run Date	Des	OD (in)	Top (ftKB)	Btm (ftKB)
10/2/2013	Stage Tool	2	4,071.0	4,076.0

Logs

Date	Type	Top, MD (ftKB)	Btm, MD (ftKB)
6/16/2007	COMPENSATED DENSITY	3,490.0	7,032.0
6/16/2007	INDUCTION	481.0	7,052.0

Well Name: MCKENNEY 13-21

VERTICAL - ORIGINAL HOLE, 11/5/2016 11:03:41 AM

Logs

