

NOBLE ENERGY INC.
MCKENNEY 13-22
NWNW 13-6N-64W
855 FNL & 658 FWL
WELD COUNTY, CO
Wattenberg
CURRENT WELLBORE SCHEMATIC
with PROPOSED P&A
9/29/2016

API: 05-123-24135
COGCC #

GL Elev: 4669'
KB Elev: 4679'

Spud Date:

Surface Casing :


8-5/8" 24# @ 766'
Cement: 330
TOC: Surface

TOC @ 2269'

Nio Top 6502'

Production Casing :

4-1/2" 11.6# M-80 @ 6976'
Cement: 505
TD: 11/30/2006

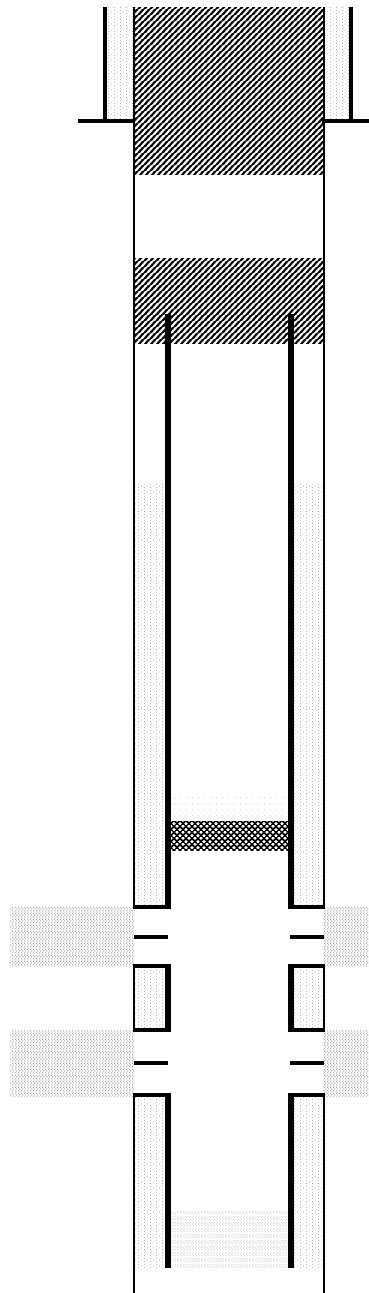

Cut surface casing off 6'-8' below surface.

Pump approx 281 sx shoe plug @ 866'
Will bring cement to surface

Pump 125 sx stub plug where csg was pulled
(TOC @ ~1986)
Cut and pull csg @ 2250'

CIBP @ 6490 ' w/ 2 sx cement on top

Niobrara Perforations: 6540'-6556'; 6644'-
6669'; 6645'-6665'; 6652'-6668';

Codell Perforations: 6823'-6836'

TD: 6976'