


T10N, R58W, 6th P.M.

LEGEND:

- = 90° SYMBOL
- = PROPOSED WELLHEAD.
- = TARGET BOTTOM HOLE.
- = SECTION CORNERS LOCATED.

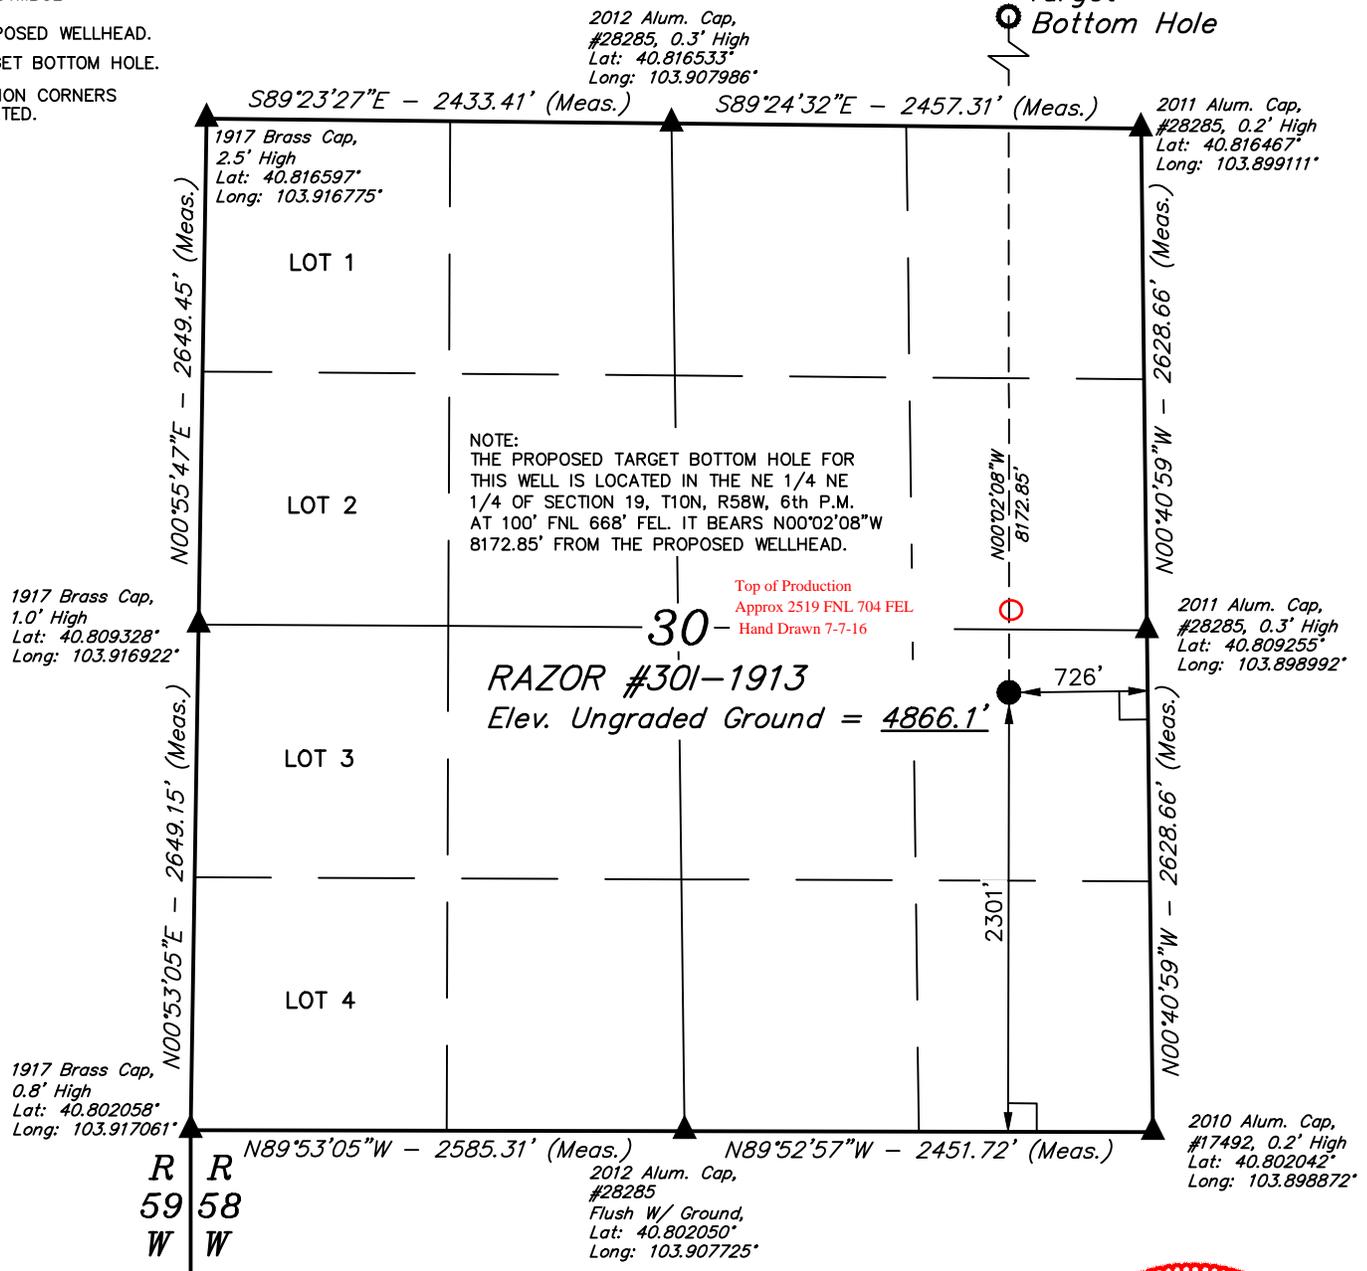

PDOP = 1.4

NAD 83 (SURFACE LOCATION)	
LATITUDE =	40°48'30.09" (40.808358)
LONGITUDE =	103°54'05.76" (103.901600)
NAD 27 (SURFACE LOCATION)	
LATITUDE =	40°48'30.14" (40.808372)
LONGITUDE =	103°54'03.95" (103.901097)



CERTIFICATE

THIS IS TO CERTIFY THAT THE ABOVE PLAT WAS PREPARED FROM FIELD NOTES OF ACTUAL SURVEYS MADE BY ME OR UNDER MY SUPERVISION AND THAT THE SAME ARE TRUE AND CORRECT TO THE BEST OF MY KNOWLEDGE AND BELIEF.

BASIS OF BEARINGS
BASIS OF BEARINGS IS A G.P.S. OBSERVATION

BASIS OF ELEVATION

SPOT ELEVATION LOCATED AT THE NORTHEAST CORNER OF SECTION 15, T9N, R58W, 6th P.M. TAKEN FROM THE GATEHOOK SPRING, QUADRANGLE, COLORADO, WELD COUNTY, 7.5 MINUTE QUAD (TOPOGRAPHIC MAP) PUBLISHED BY THE UNITED STATES DEPARTMENT OF THE INTERIOR, GEOLOGICAL SURVEY. SAID ELEVATION IS MARKED AS BEING 4679 FEET.

WHITING OIL & GAS CORP.

RAZOR #301-1913 (SURFACE LOCATION)
NE 1/4 SE 1/4, SECTION 30, T10N, R58W, 6th P.M.
WELD COUNTY, COLORADO



UELS, LLC
Corporate Office * 85 South 200 East
Vernal, UT 84078 * (435) 789-1017




SURVEYED BY: CHAD MEIERS, C.M.	DATE: 10-20-15
DRAWN BY: J.P.	SCALE: 1" = 1000'
DATE DRAWN: 04-29-14	REVISION: 11-05-15

WELL LOCATION PLAT

T10N, R58W, 6th P.M

LEGEND:

- └─ = 90° SYMBOL
- = PROPOSED WELLHEAD.
- = TARGET BOTTOM HOLE.
- ▲ = SECTION CORNERS LOCATED.

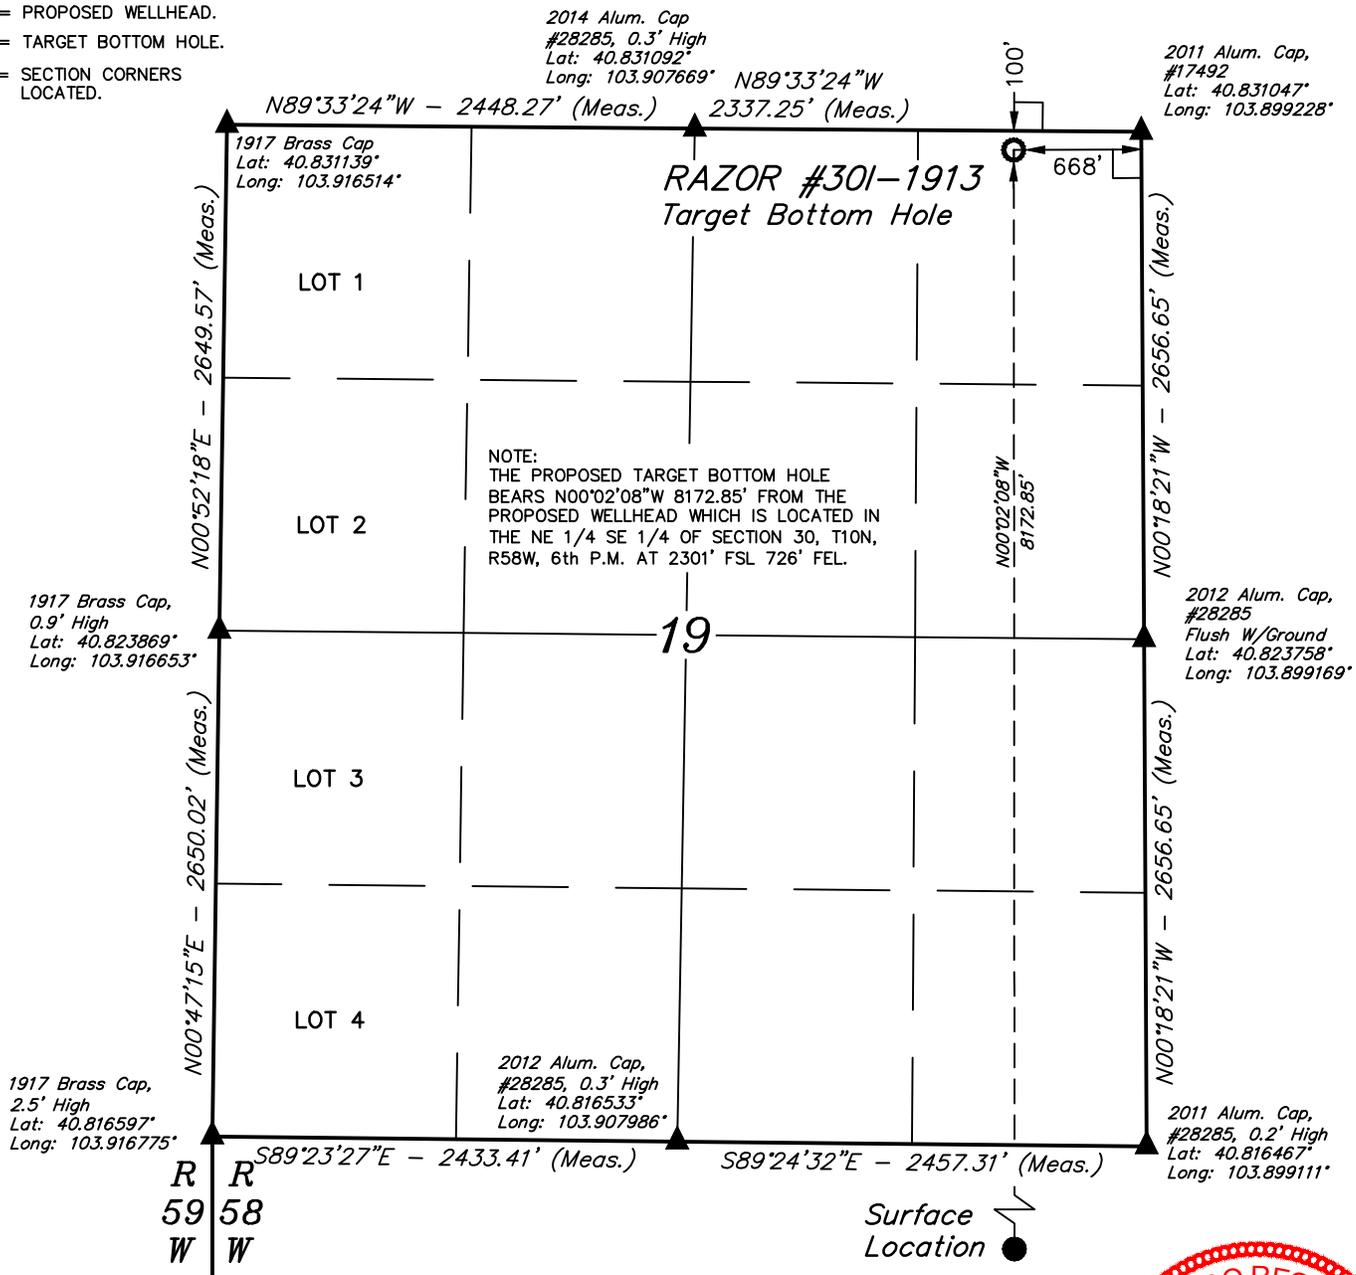

NAD 83 (TARGET BOTTOM HOLE)
LATITUDE = 40°49'50.83" (40.830786)
LONGITUDE = 103°54'05.90" (103.901639)
NAD 27 (TARGET BOTTOM HOLE)
LATITUDE = 40°49'50.88" (40.830800)
LONGITUDE = 103°54'04.09" (103.901136)



CERTIFICATE

THIS IS TO CERTIFY THAT THE ABOVE PLAT WAS PREPARED FROM FIELD NOTES OF ACTUAL SURVEYS MADE BY ME OR UNDER MY SUPERVISION, AND THAT THE SAME ARE TRUE AND CORRECT TO THE BEST OF MY KNOWLEDGE AND BELIEF.



BASIS OF BEARINGS
BASIS OF BEARINGS IS A G.P.S. OBSERVATION

BASIS OF ELEVATION

SPOT ELEVATION LOCATED AT THE NORTHEAST CORNER OF SECTION 15, T9N, R58W, 6th P.M. TAKEN FROM THE GATEHOOK SPRING, QUADRANGLE, COLORADO, WELD COUNTY, 7.5 MINUTE QUAD (TOPOGRAPHIC MAP) PUBLISHED BY THE UNITED STATES DEPARTMENT OF THE INTERIOR, GEOLOGICAL SURVEY. SAID ELEVATION IS MARKED AS BEING 4679 FEET.

WHITING OIL & GAS CORP.

**RAZOR #30I-1913 (TARGET BOTTOM HOLE)
NE 1/4 NE 1/4, SECTION 19, T10N, R58W, 6th P.M.
WELD COUNTY, COLORADO**

SURVEYED BY: CHAD MEIERS, C.M.	DATE: 10-20-15
DRAWN BY: J.P.	SCALE: 1" = 1000'
DATE DRAWN: 04-29-14	REVISION: 11-05-15



UELS, LLC
Corporate Office * 85 South 200 East
Vernal, UT 84078 * (435) 789-1017



WELL LOCATION PLAT