

Well Completion Diagram

API Well No. 05-013-06483



Operator: Blue Chip Oil Inc. Well Name: Leistikow #1

Boulder Valley Field, Boulder County, Colorado

Coordinates: 1801' FWL 2116' FSL NESW Sec. 21-T1N-R68W 6th PM

March 1995

Bore Diameters (inches)

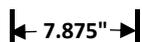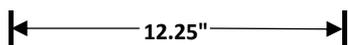

Cement Top 0'

8 5/8" 24# Csg @ 538' KB

Cemented to Surface

Cement Bottom 538' KB



4 1/2" 12.6# Production Casing

Cement top 6546' (bond log)

Codell/Niobrara Perforations 7426' - 7886'

TD = 8050'

4 1/2" 12.6# @ 8029' cemented with 210 s

