

Foundation Energy Management, LLC

Drilling - Completion - Workover - Facilities

DISCUSSION

Well / Battery Newton 33-32	Prospect Name Tri-States	Total Depth 2591	Est. Start Date 1/1/2015
Location NW SE	Sec-Twn-Rng Sec 32 - T2N - R44W	Producing Horizon Niobrara	County & State Yuma, CO

AFE Description
Plug and Abandon

WBD After

Prepared Date: 11/17/2015
Prepared By: Neil Hutton


General Info

API #: 05-125-09535

KB Elevation: 3849
GL Elevation: 3843

Spud Date: 10/13/2005
Completion Date: 10/16/2005

TVD: 2636
MD: 2636
Last PBTD: 2591

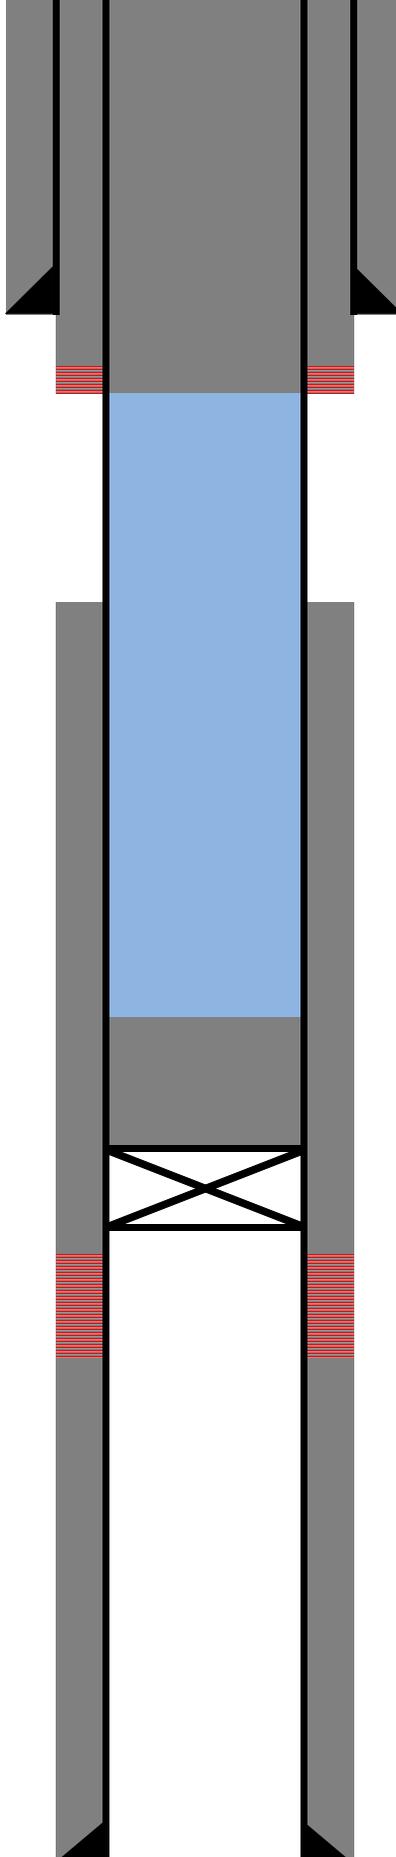

Perfs@445'

Surface Casing

7" inch (OD)
20 # (weight)
J55 grade
386 depth from KB
0 cement top Calculated
148 sacks of cement
9.875 inch (OD) HOLE SIZE

Production Casing

4-1/2 inch (OD)
9.5 # (weight)
J-55 grade
2633 depth from KB
1,050 cement top CBL
160 sacks of cement
6.25 inch (OD) HOLE SIZE

2 sx cement on top of CIBP
CIBP @ 2,417'

Abandoned Perforations

2192' - 2212' (1 SPF)

PBTD: 2361'

Well Notes:

2 sx cement bailed on top of CIBP

32 bbls water spacer

81 sx cement plug from 50' below
Surface Casing to surface