


WELLBORE DIAGRAM  
 EXTRACTION OIL & GAS  
 FRANK CAVANAUGH #1  
 SESW SEC 10 T4S R64W  
 WELD COUNTY  
 05-005-05054

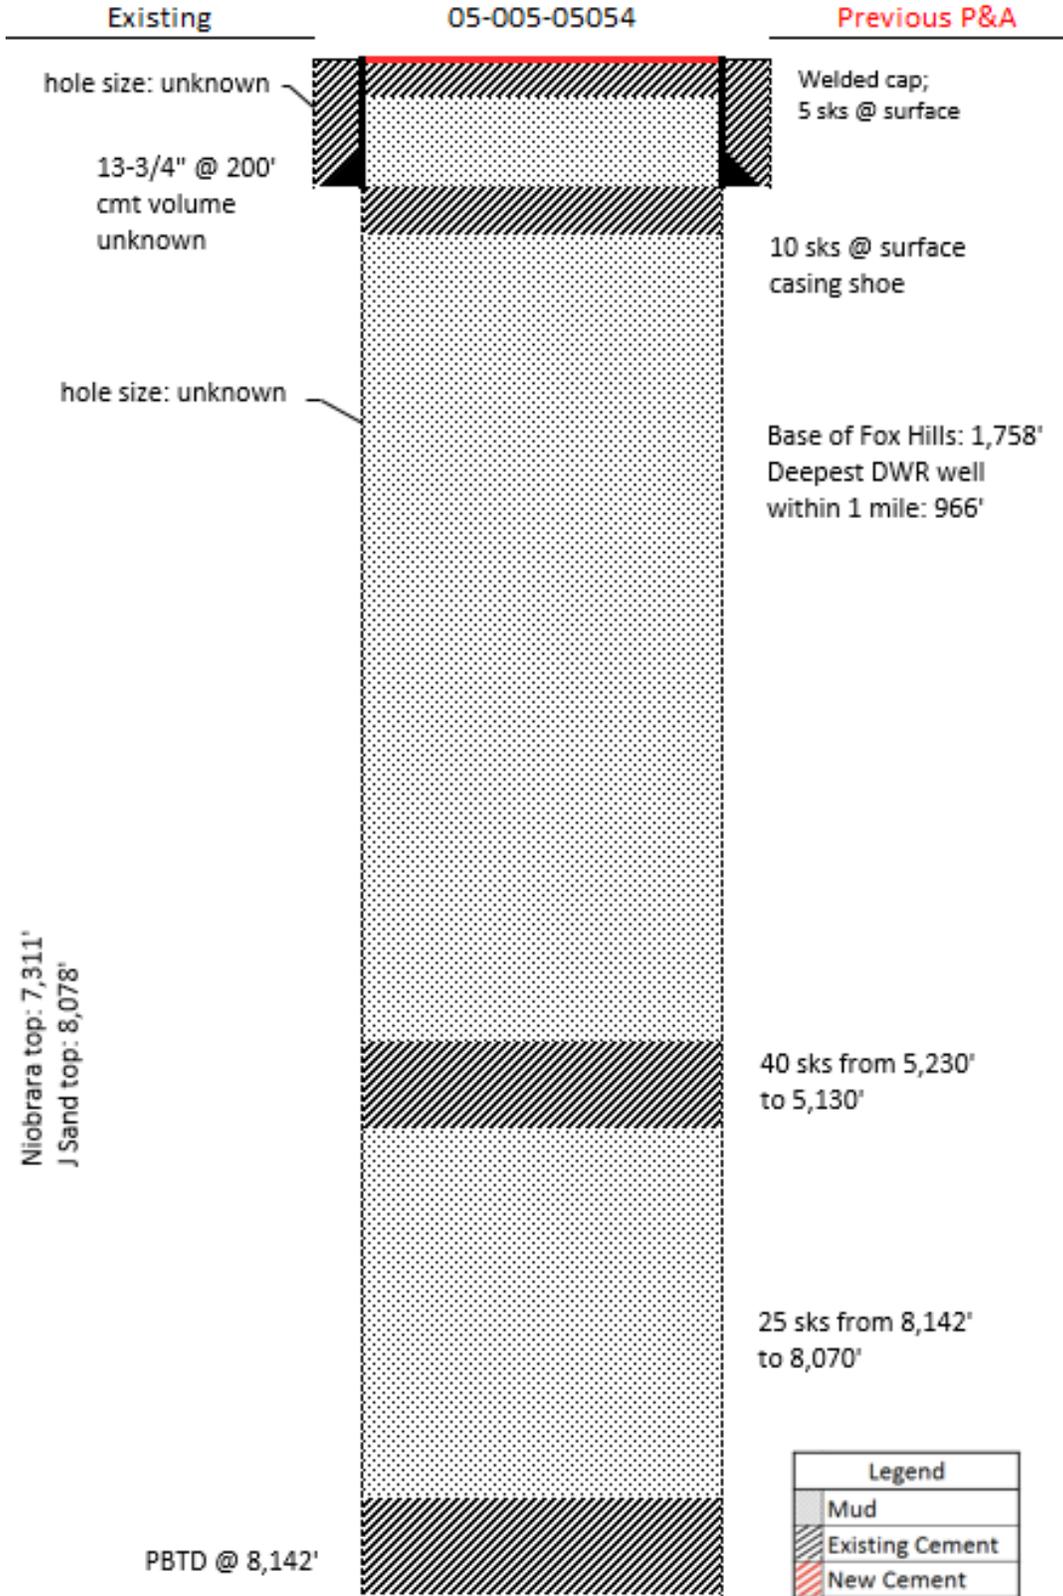

Legend	
	Mud
	Existing Cement
	New Cement