



## Exploration and Production Set Plug to Produce

Wellname **W 8-4**  
Location **SWNW 34-6S-95W**  
Field **Parachute**  
County **Garfield, CO**  
API **05-045-06513**  
ELEV **5306'**  
Footages **1978 FNL 744 FWL**

Prepared By: Will Greathouse  
office phone: 832-726-1197  
cell phone: 817-709-3949

Revision Date:  
11/29/2016

Casing: 8-5/8" 24#, - 276-ft  
4-1/2" 10.5#, J-55, - 3,196-ft  
Current Top of Cement: 660-ft CBL (Gearhart 04/09/86)


**Purpose: MIT & Set Plug**

Zone: **All Perforations**

Existing Perforations:	<u>Depth</u>	<u>Holes</u>
	1554' - 1702'	29
		29 total

### Actual Procedure

- 1 Notify COGCC 10 days prior via electronic Form 42
- 2 RIH and set 4-1/2" RBP at 1,512'.
- 3 Pressure test casing to 565 psi and held for 15 minutes with COGCC witness. Test good
- 4 POOH with 4-1/2" RBP
- 5 RIH and set 4-1/2" CIBP at 1,680' and bail 2 sx cement on top.
- 6 Rig down wireline truck
- 7 RIH with 2-3/8" tbg and land at 1,577'
- 8 RDMO

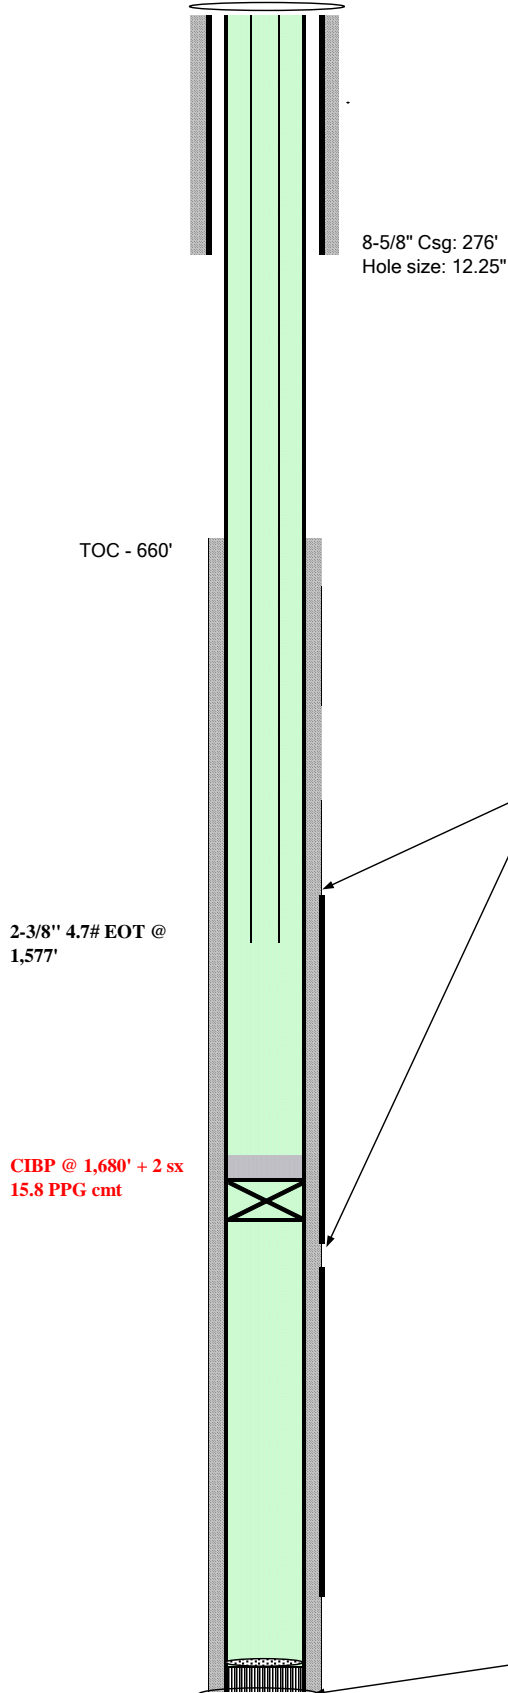

Well Name **W 8-4**  
 Location **SWNW 34-6S-95W**  
 Field **Parachute**  
 County **Garfield, CO**  
 API **05-045-06513**  
 ELEV **5306'**  
 Footages **1978 FNL 744 FWL**

## Spud 10/21/1985

Conductor  
 Casing **276'** **8-5/8" 24#**  
 Cement **250 sx**  
 Casing **3196'** **4-1/2" 10.5# J-55**  
 Cement **475 sx**

## Tubing Detail

2-3/8" 4.7# @ 1,577'

## Formation Tops

Wasatch **1554'**

## TOC - Bond Log 660'

## Completed Intervals

	<u>Depth</u>	<u># Holes</u>	<u>Producing</u>
<u>Wasatch</u>	1,554'-1,597'	21	Yes
	1,606'-1,618'	6	Yes
	1,699'	1	No
	1,702'	1	No

3196', 4-1/2" Csg, Hole Size, 7-7/8"