

38

Location _____ Date 5/16/12

Project / Client Eaton Tatonken


12:46 on-site. 02K, C. Cr. 100m
 Roadway Culvert ^{well}
 T7 94W SW/4 15

40.5270 / -107.93759

- Built partial location. w/ in 2 am
 disturbance. where closer just
 push dirt.

0516131515 collected sample in 3" diameter
 lowest portion of pit. Dry: sand.

A. "14" pipe diameter soil
 pile ~20'. Roadway covered
 w/ skid steer.

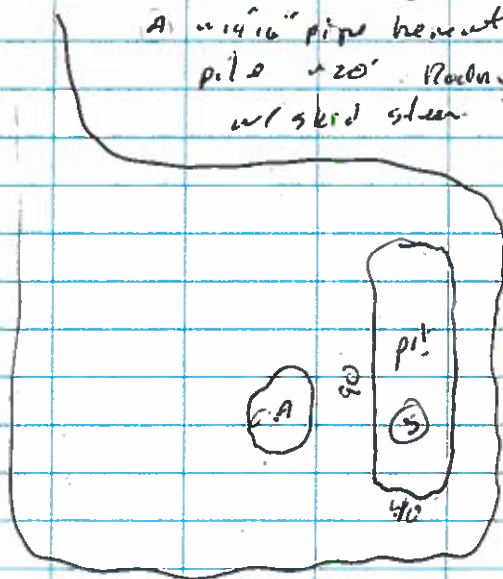

Mike Hanson