


# T2N, R68W

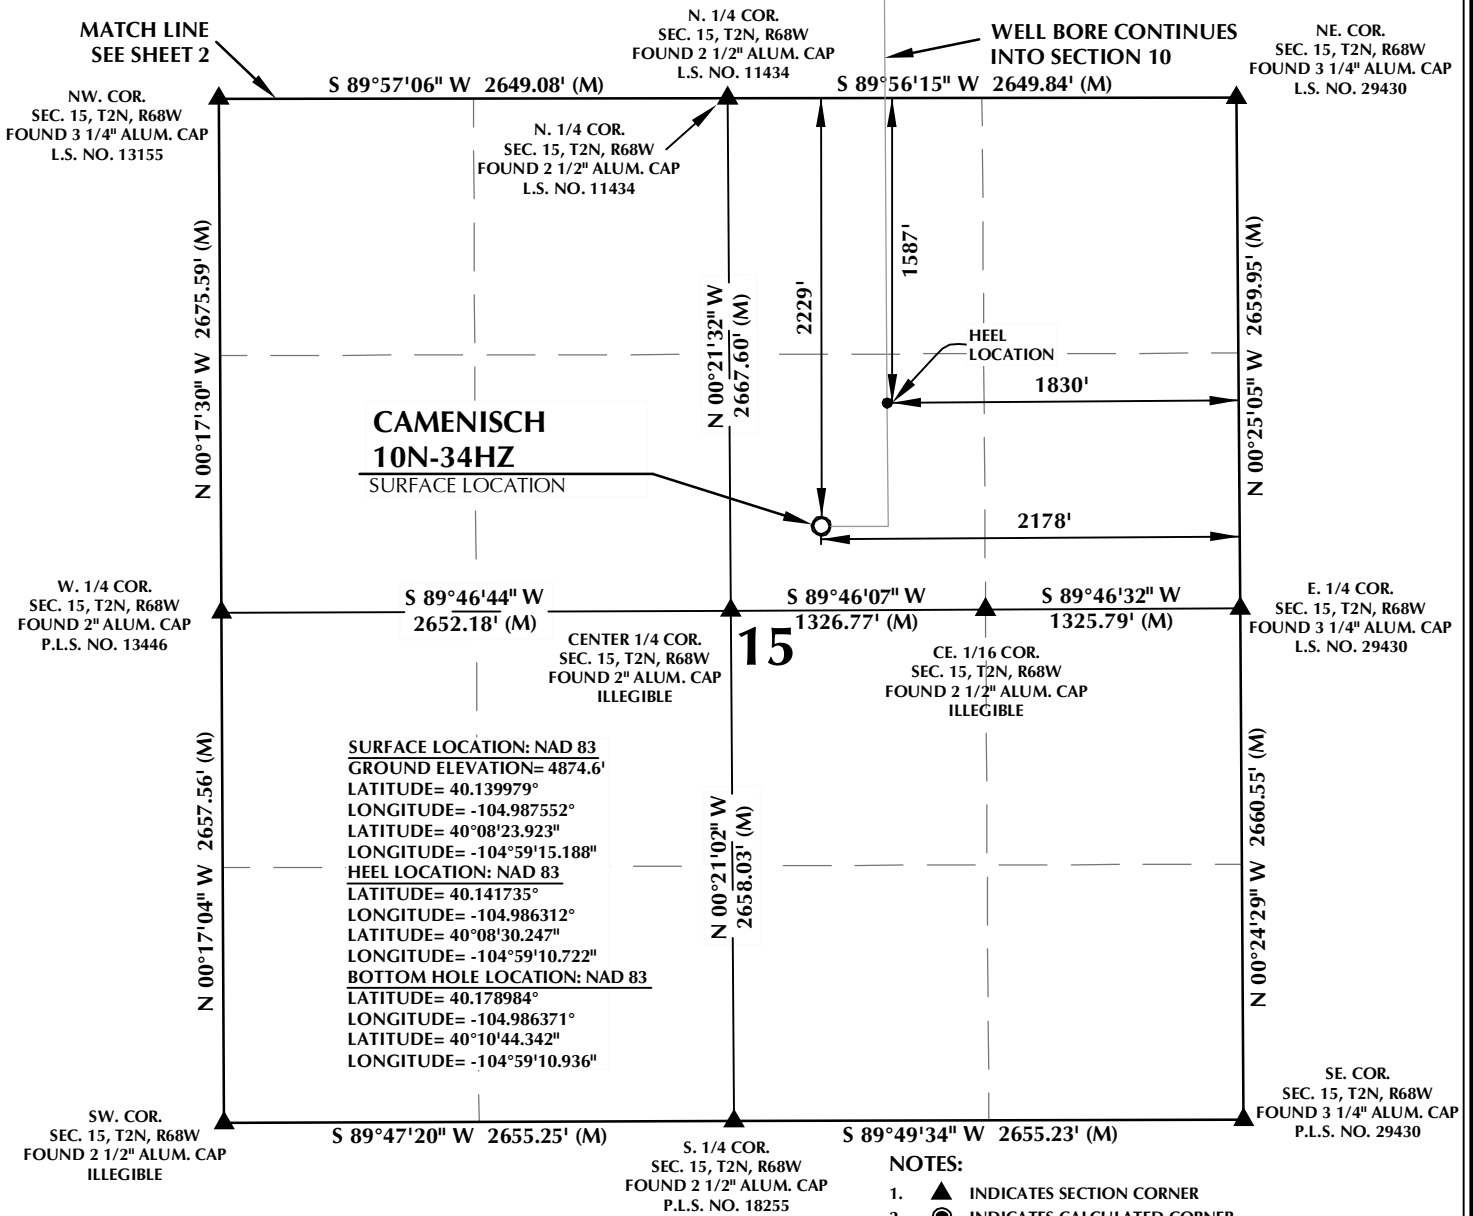


## CERTIFICATE OF SURVEYOR:

THIS IS TO CERTIFY THAT THE ABOVE PLAT WAS PREPARED FROM FIELD NOTES OF ACTUAL SURVEY MADE BY ME OR UNDER MY SUPERVISION AND THAT THE SAME ARE TRUE AND CORRECT TO THE BEST OF MY KNOWLEDGE AND BELIEF. THIS CERTIFICATE DOES NOT REPRESENT A LAND SURVEY PLAT OR IMPROVEMENT SURVEY PLAT AS DEFINED BY C.R.S. 38-51-102 AND CANNOT BE RELIED UPON TO DETERMINE OWNERSHIP.

*Randall K. French*  
 RANDALL K. FRENCH  
 PROFESSIONAL LAND SURVEYOR  
 COLORADO REGISTRATION NUMBER 18512


**NOTICE:**  
 ACCORDING TO COLORADO STATE LAW YOU MUST COMMENCE ANY LEGAL ACTION BASED UPON ANY DEFECT IN THIS SURVEY WITHIN THREE YEARS AFTER YOU FIRST DISCOVER SUCH DEFECT. IN NO EVENT MAY ANY ACTION BASED UPON ANY DEFECT IN THIS SURVEY BE COMMENCED MORE THAN TEN YEARS FROM THE DATE ON THE CERTIFICATION SHOWN HEREON.

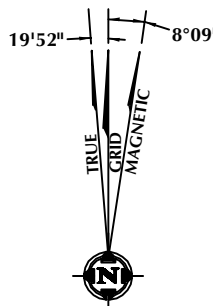

**NOTE:**  
 MAGNETIC NORTH IS CURRENT AS OF 9/10/2015.  
 MAGNETIC NORTH CHANGES WEST 0°06' PER YEAR.

## NOTES:

- ▲ INDICATES SECTION CORNER
- INDICATES CALCULATED CORNER
- ELEVATION BASED ON NAVD88 (GEOID09)
- BASIS OF BEARING DERIVED FROM COLORADO COORDINATE SYSTEM OF 1983 NORTH ZONE.
- ALL MEASURED DISTANCES ARE GRID. COMBINED SCALE FACTOR: .99972911 CALCULATED FROM THE S. 1/4 CORNER OF SECTION 10, T2N, R68W
- OPERATOR: ROB WILSON / PDOP = 1.6
- SEE ADDENDUM TO WELL LOCATION CERTIFICATE FOR EXISTING IMPROVEMENTS WITHIN 500' OF THE WELL PAD.
- WELL FOOTAGES ARE MEASURED AT RIGHT ANGLES TO THE SECTION LINES.
- THE BOTTOM OF HOLE BEARS N00°24'06"W, 13569' FROM THE HEEL LOCATION.

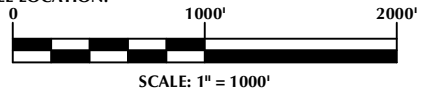

## WELL PAD - CAMENISCH 36N-22HZ

**CAMENISCH 10N-34HZ**  
**WELL LOCATION CERTIFICATE**  
 2229' FNL & 2178' FEL SWNE (SURFACE)  
 1587' FNL & 1830' FEL SWNE (HEEL)  
 LOCATED IN SECTION 15  
 T2N, R68W, 6TH P.M.  
 1467' FSL & 1913' FEL NWSE (BOTTOM)  
 LOCATED IN SECTION 34  
 T3N, R68W, 6TH P.M.  
 WELD COUNTY, COLORADO

**Kerr-McGee Oil &  
 Gas Onshore L.P.**  
 1099 18th Street  
 Denver, Colorado 80202




## CONSULTING, LLC

**SHERIDAN OFFICE**  
 1095 Saberton Avenue  
 Sheridan, Wyoming 82801  
 Phone 307-674-0609

**LOVELAND OFFICE**  
 1635 Foxtrail Drive, Suite 204  
 Loveland, Colorado 80538  
 Phone 970-776-4331

DRAFTED BY:	LMO	CHECKED BY:	RKF	SHEET NO:
DATE DRAFTED:	9/28/15	DATE SURVEYED:	7/15/15	1
REVISED:	10/17/16	FILE NAME:	15-23	1 OF 4

# T2N, R68W

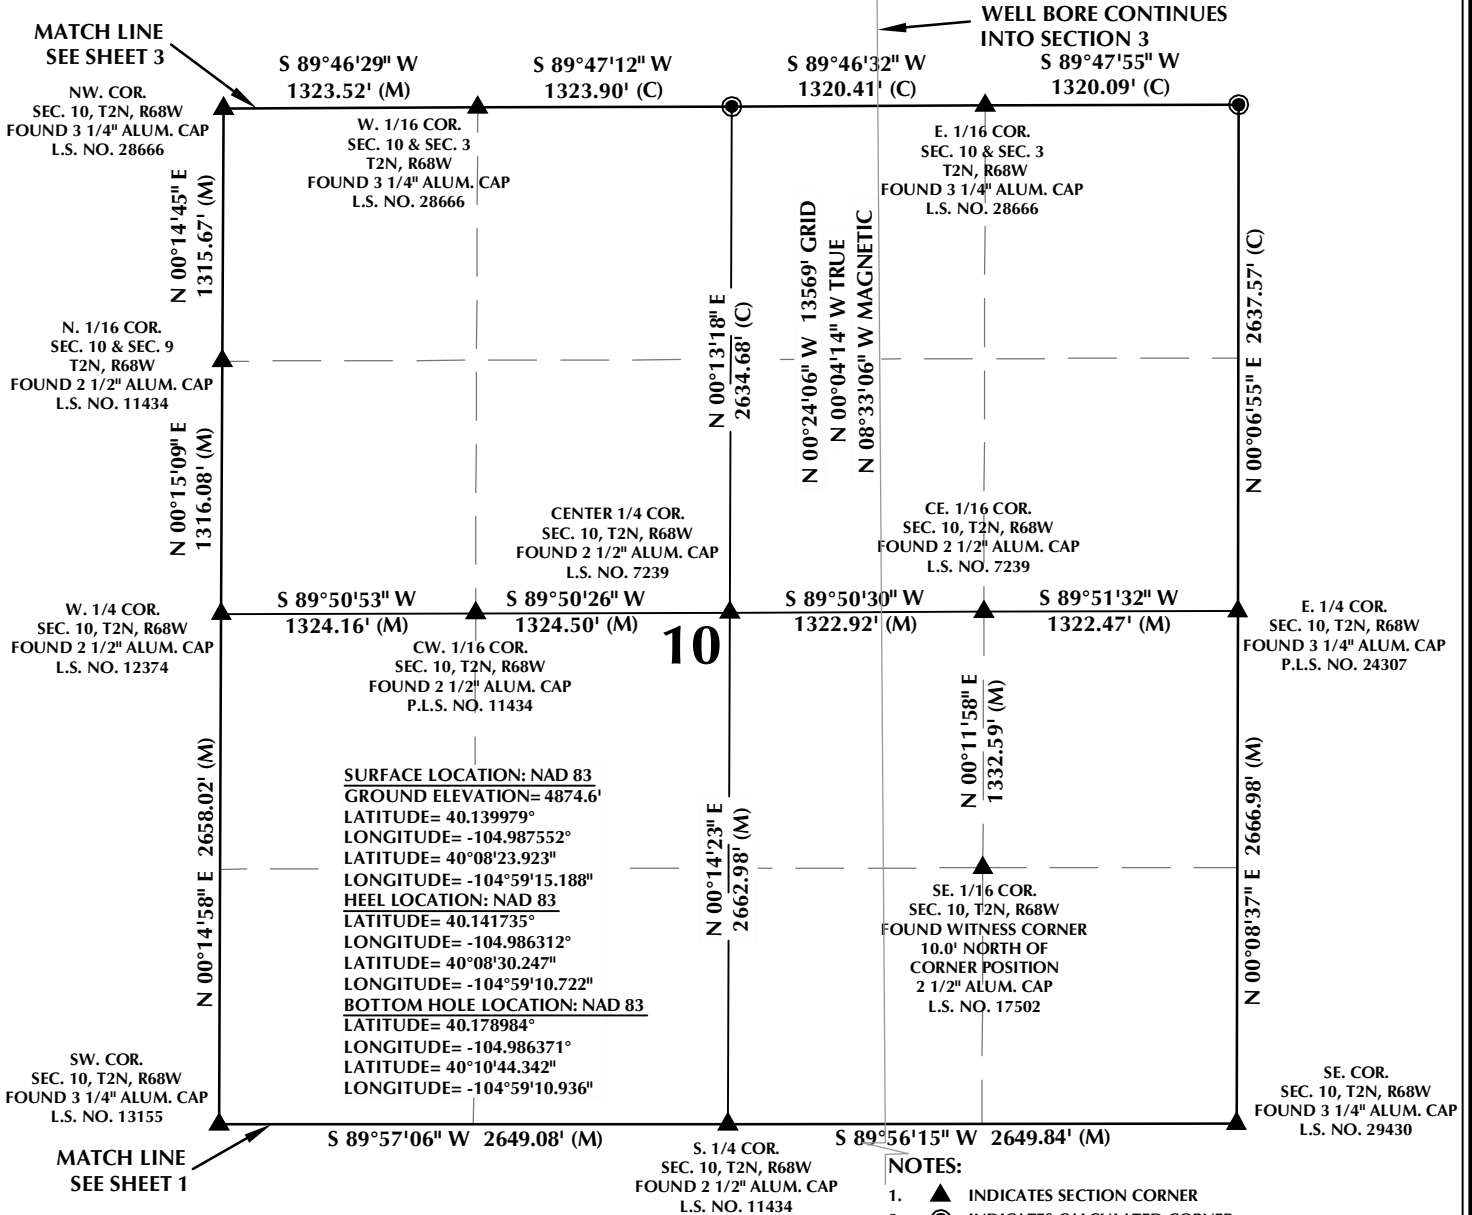


## CERTIFICATE OF SURVEYOR:

THIS IS TO CERTIFY THAT THE ABOVE PLAT WAS PREPARED FROM FIELD NOTES OF ACTUAL SURVEY MADE BY ME OR UNDER MY SUPERVISION AND THAT THE SAME ARE TRUE AND CORRECT TO THE BEST OF MY KNOWLEDGE AND BELIEF. THIS CERTIFICATE DOES NOT REPRESENT A LAND SURVEY PLAT OR IMPROVEMENT SURVEY PLAT AS DEFINED BY C.R.S. 38-51-102 AND CANNOT BE RELIED UPON TO DETERMINE OWNERSHIP.

*Randall K. French*  
 RANDALL K. FRENCH  
 PROFESSIONAL LAND SURVEYOR  
 COLORADO REGISTRATION NUMBER 18512

NOTICE:  
 ACCORDING TO COLORADO STATE LAW YOU MUST COMMENCE ANY LEGAL ACTION BASED UPON ANY DEFECT IN THIS SURVEY WITHIN THREE YEARS AFTER YOU FIRST DISCOVER SUCH DEFECT. IN NO EVENT MAY ANY ACTION BASED UPON ANY DEFECT IN THIS SURVEY BE COMMENCED MORE THAN TEN YEARS FROM THE DATE ON THE CERTIFICATION SHOWN HEREON.

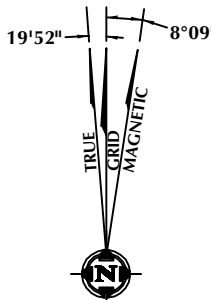

NOTE:  
 MAGNETIC NORTH IS CURRENT AS OF 9/10/2015.  
 MAGNETIC NORTH CHANGES WEST 0°06' PER YEAR.

## NOTES:

- ▲ INDICATES SECTION CORNER
- INDICATES CALCULATED CORNER
- ELEVATION BASED ON NAVD88 (GEOID09)
- BASIS OF BEARING DERIVED FROM COLORADO COORDINATE SYSTEM OF 1983 NORTH ZONE.
- ALL MEASURED DISTANCES ARE GRID. COMBINED SCALE FACTOR: .99972911 CALCULATED FROM THE S. 1/4 CORNER OF SECTION 10, T2N, R68W
- OPERATOR: ROB WILSON / PDOP = 1.6
- SEE ADDENDUM TO WELL LOCATION CERTIFICATE FOR EXISTING IMPROVEMENTS WITHIN 500' OF THE WELL PAD.
- WELL FOOTAGES ARE MEASURED AT RIGHT ANGLES TO THE SECTION LINES.
- THE BOTTOM OF HOLE BEARS N00°24'06"W, 13569' FROM THE HEEL LOCATION.



## WELL PAD - CAMENISCH 36N-22HZ

CAMENISCH 10N-34HZ  
 WELL LOCATION CERTIFICATE  
 2229' FNL & 2178' FEL SWNE (SURFACE)  
 1587' FNL & 1830' FEL SWNE (HEEL)  
 LOCATED IN SECTION 15  
 T2N, R68W, 6TH P.M.  
 1467' FSL & 1913' FEL NWSE (BOTTOM)  
 LOCATED IN SECTION 34  
 T3N, R68W, 6TH P.M.  
 WELD COUNTY, COLORADO

**Kerr-McGee Oil &  
 Gas Onshore L.P.**  
 1099 18th Street  
 Denver, Colorado 80202




## CONSULTING, LLC

SHERIDAN OFFICE  
 1095 Saberton Avenue  
 Sheridan, Wyoming 82801  
 Phone 307-674-0609

LOVELAND OFFICE  
 1635 Foxtrail Drive, Suite 204  
 Loveland, Colorado 80538  
 Phone 970-776-4331

DRAFTED BY:	LMO	CHECKED BY:	RKF	SHEET NO:
DATE DRAFTED:	9/28/15	DATE SURVEYED:	7/15/15	2
REVISED:	10/17/16	FILE NAME:	15-23	2 OF 4

K:\VADARKO\2015\23 CAMENISCH SEC. 15, T2N, R68W\PLAT\CAMENISCH 36N-22HZ.dwg, 10/17/2016 5:45:57 PM, Jabe

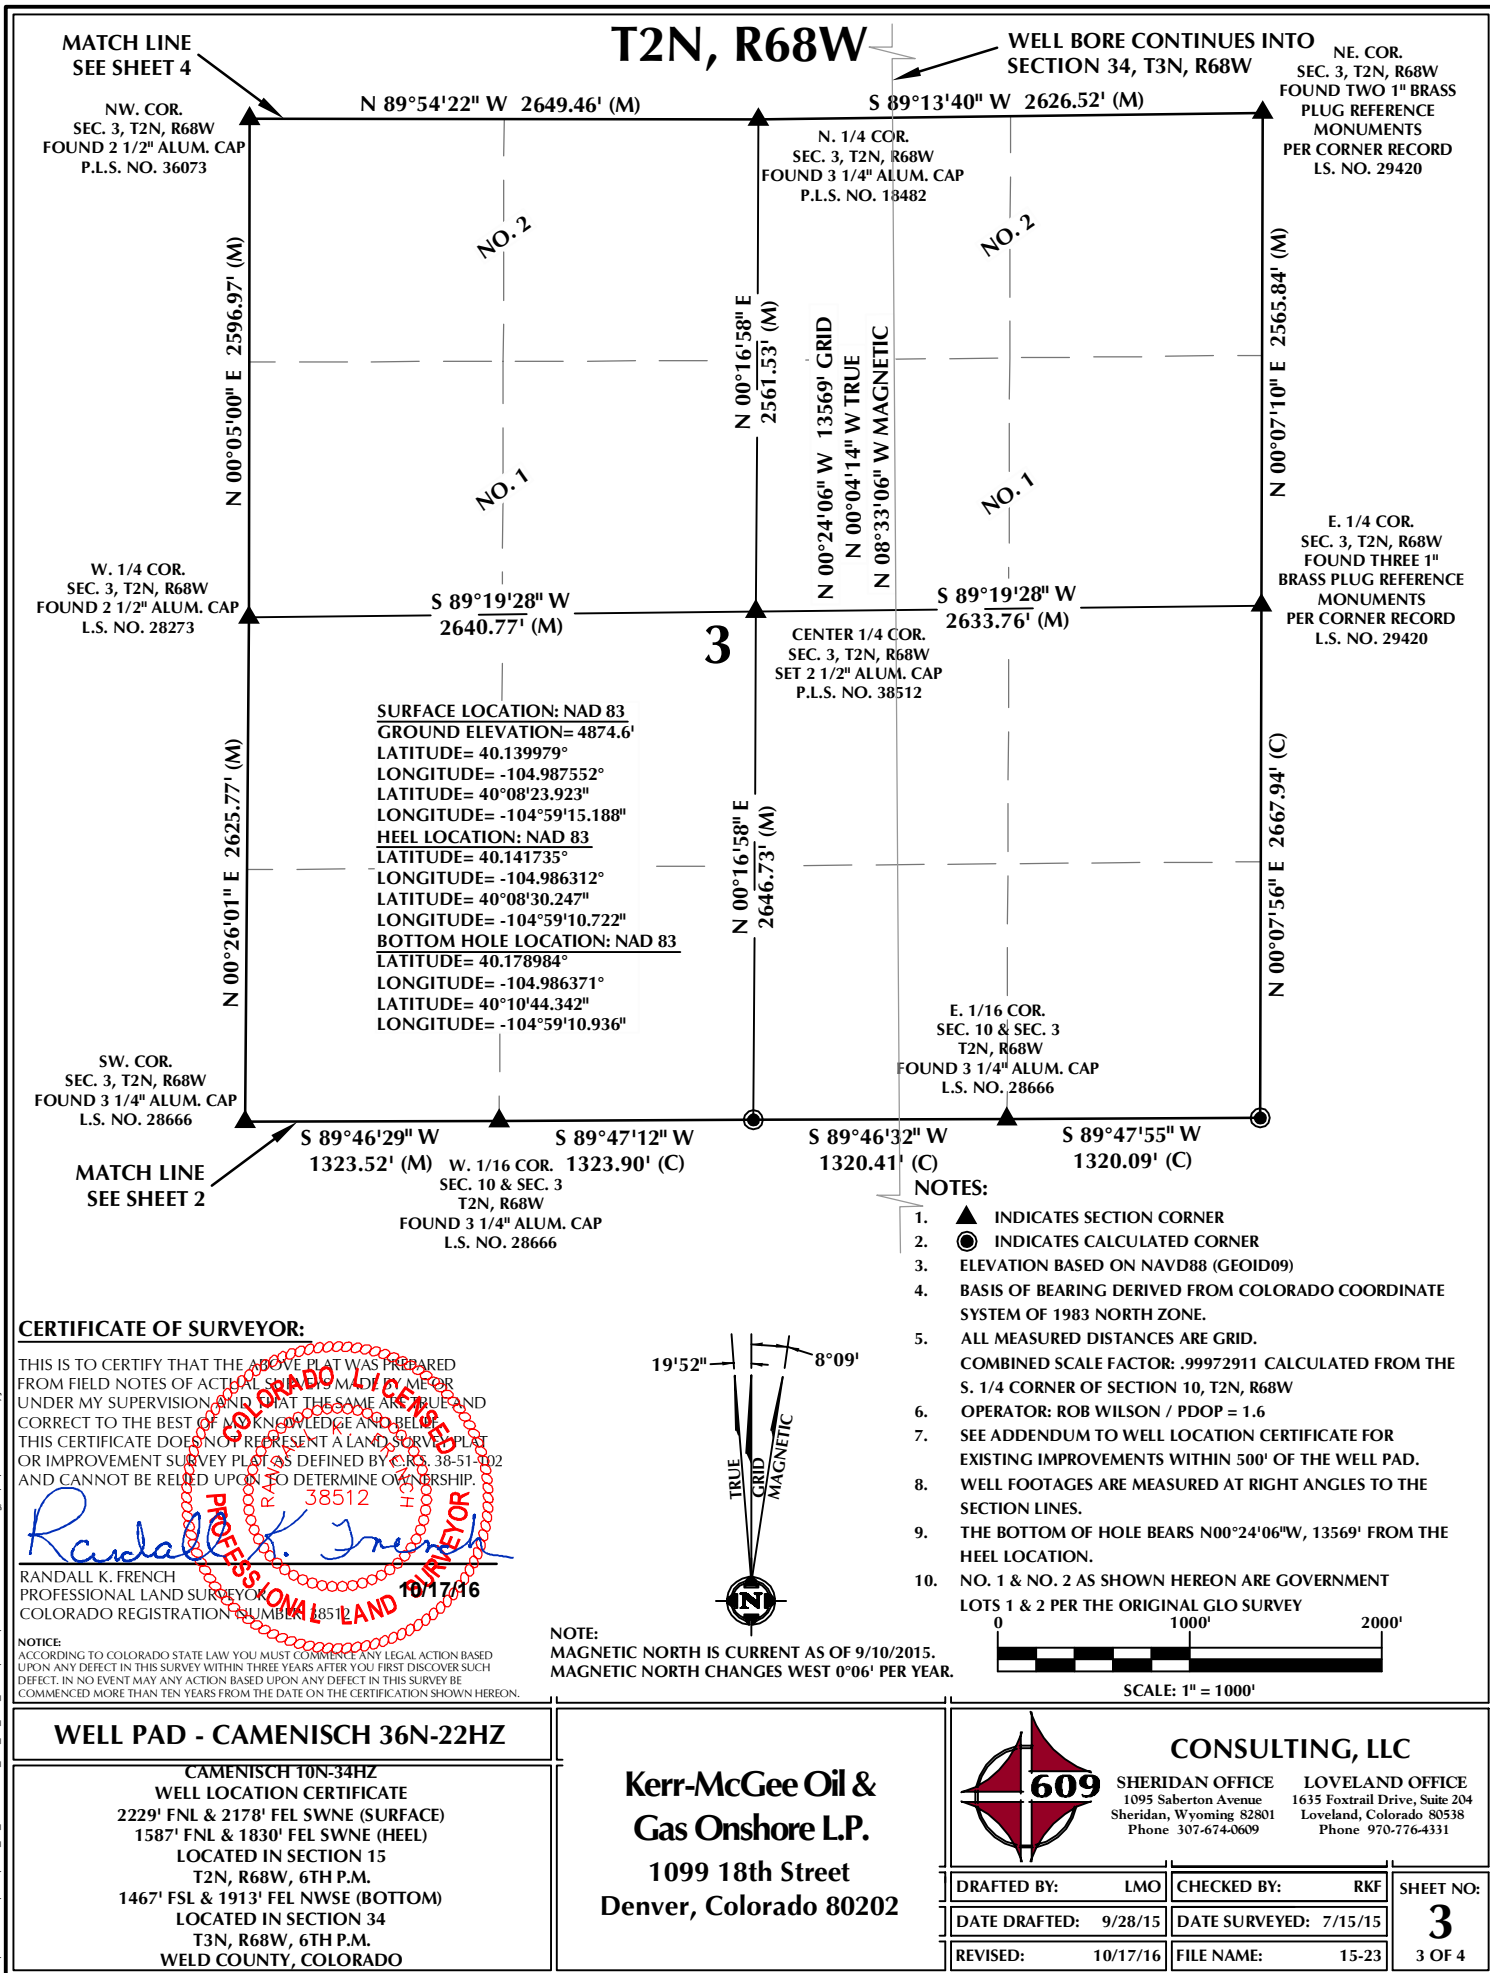

# T3N, R68W

NW. COR.  
SEC. 34, T3N, R68W  
FOUND 2 1/2" ALUM. CAP  
P.L.S. NO. 34591

S 89°07'13" W 2565.53' (M)

S 89°07'15" W 2656.24' (M)

NE. COR.  
SEC. 34, T3N, R68W  
FOUND 3 1/4" ALUM. CAP  
P.L.S. NO. 29420

N. 1/4 COR.  
SEC. 34, T3N, R68W  
FOUND 2 1/2" ALUM. CAP  
L.S. NO. 38459

SURFACE LOCATION: NAD 83  
GROUND ELEVATION= 4874.6'  
LATITUDE= 40.139979°  
LONGITUDE= -104.987552°  
LATITUDE= 40°08'23.923"  
LONGITUDE= -104°59'15.188"  
HEEL LOCATION: NAD 83  
LATITUDE= 40.141735°  
LONGITUDE= -104.986312°  
LATITUDE= 40°08'30.247"  
LONGITUDE= -104°59'10.722"  
BOTTOM HOLE LOCATION: NAD 83  
LATITUDE= 40.178984°  
LONGITUDE= -104.986371°  
LATITUDE= 40°10'44.342"  
LONGITUDE= -104°59'10.936"

CENTER 1/4 COR.  
SEC. 34, T3N, R68W  
FOUND 2 1/2" ALUM. CAP  
P.L.S. NO. 7735

34

W. 1/4 COR.  
SEC. 34, T3N, R68W  
FOUND 3 1/4" ALUM. CAP  
P.L.S. NO. 34591

S 89°07'26" W  
2573.32' (M)

S 89°34'05" W  
2673.11' (M)

E. 1/4 COR.  
SEC. 34, T3N, R68W  
FOUND 3 1/4" ALUM. CAP  
P.L.S. NO. 29420

N 00°18'58" W 2650.43' (M)

N 01°56'09" W  
2695.62' (M)

N 00°56'51" W 2679.21' (M)

BOTTOM OF HOLE:  
1467' FSL & 1913' FEL

SW. COR.  
SEC. 34, T3N, R68W  
FOUND 2 1/2" ALUM. CAP  
P.L.S. NO. 36073

N 89°54'22" W 2649.46' (M)

S. 1/4 COR.  
SEC. 34, T3N, R68W  
FOUND 3 1/4" ALUM. CAP  
P.L.S. NO. 18482

S 89°13'40" W 2626.52' (M)

SE. COR.  
SEC. 34, T3N, R68W  
FOUND TWO 1" BRASS  
PLUG REFERENCE  
MONUMENTS  
PER CORNER RECORD  
L.S. NO. 29420


MATCH LINE  
SEE SHEET 3

## CERTIFICATE OF SURVEYOR:

THIS IS TO CERTIFY THAT THE ABOVE PLAT WAS PREPARED FROM FIELD NOTES OF ACTUAL SURVEY MADE BY ME OR UNDER MY SUPERVISION AND THAT THE SAME ARE TRUE AND CORRECT TO THE BEST OF MY KNOWLEDGE AND BELIEF. THIS CERTIFICATE DOES NOT REPRESENT A LAND SURVEY PLAT OR IMPROVEMENT SURVEY PLAT AS DEFINED BY C.R.S. 38-51-102 AND CANNOT BE RELIED UPON TO DETERMINE OWNERSHIP.

*Randall K. French*  
RANDALL K. FRENCH  
PROFESSIONAL LAND SURVEYOR  
COLORADO REGISTRATION NUMBER 18512  
10/17/16

NOTICE:  
ACCORDING TO COLORADO STATE LAW YOU MUST COMMENCE ANY LEGAL ACTION BASED UPON ANY DEFECT IN THIS SURVEY WITHIN THREE YEARS AFTER YOU FIRST DISCOVER SUCH DEFECT. IN NO EVENT MAY ANY ACTION BASED UPON ANY DEFECT IN THIS SURVEY BE COMMENCED MORE THAN TEN YEARS FROM THE DATE ON THE CERTIFICATION SHOWN HEREON.

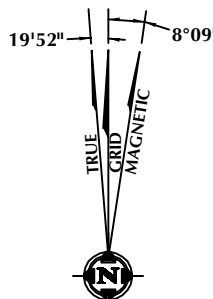

NOTE:  
MAGNETIC NORTH IS CURRENT AS OF 9/10/2015.  
MAGNETIC NORTH CHANGES WEST 0°06' PER YEAR.

## NOTES:


- ▲ INDICATES SECTION CORNER
- INDICATES CALCULATED CORNER
- ELEVATION BASED ON NAVD88 (GEOID09)
- BASIS OF BEARING DERIVED FROM COLORADO COORDINATE SYSTEM OF 1983 NORTH ZONE.
- ALL MEASURED DISTANCES ARE GRID.
- COMBINED SCALE FACTOR: .99972911 CALCULATED FROM THE S. 1/4 CORNER OF SECTION 10, T2N, R68W
- OPERATOR: ROB WILSON / PDOP = 1.6
- SEE ADDENDUM TO WELL LOCATION CERTIFICATE FOR EXISTING IMPROVEMENTS WITHIN 500' OF THE WELL PAD.
- WELL FOOTAGES ARE MEASURED AT RIGHT ANGLES TO THE SECTION LINES.
- THE BOTTOM OF HOLE BEARS N00°24'06"W, 13569' FROM THE HEEL LOCATION.



## WELL PAD - CAMENISCH 36N-22HZ

CAMENISCH 10N-34HZ  
WELL LOCATION CERTIFICATE  
2229' FNL & 2178' FEL SWNE (SURFACE)  
1587' FNL & 1830' FEL SWNE (HEEL)  
LOCATED IN SECTION 15  
T2N, R68W, 6TH P.M.  
1467' FSL & 1913' FEL NWSE (BOTTOM)  
LOCATED IN SECTION 34  
T3N, R68W, 6TH P.M.  
WELD COUNTY, COLORADO

**Kerr-McGee Oil &  
Gas Onshore L.P.**  
1099 18th Street  
Denver, Colorado 80202

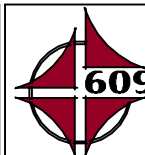

## CONSULTING, LLC


SHERIDAN OFFICE  
1095 Saberton Avenue  
Sheridan, Wyoming 82801  
Phone 307-674-0609

LOVELAND OFFICE  
1635 Foxtrail Drive, Suite 204  
Loveland, Colorado 80538  
Phone 970-776-4331

DRAFTED BY:	LMO	CHECKED BY:	RKF	SHEET NO:
DATE DRAFTED:	10/17/16	DATE SURVEYED:	7/15/15	4
REVISED:		FILE NAME:	15-23	4 OF 4



K:\ANADARKO\2015\2015\_23\_CAMENISCH\_SEC\_15\_T2N\_R68W\GIS\Maps\_ABC\CAMENISCH 36N-22HZ\CAMENISCH 10N-34HZ.mxd 10/14/2016 3:59:21 PM

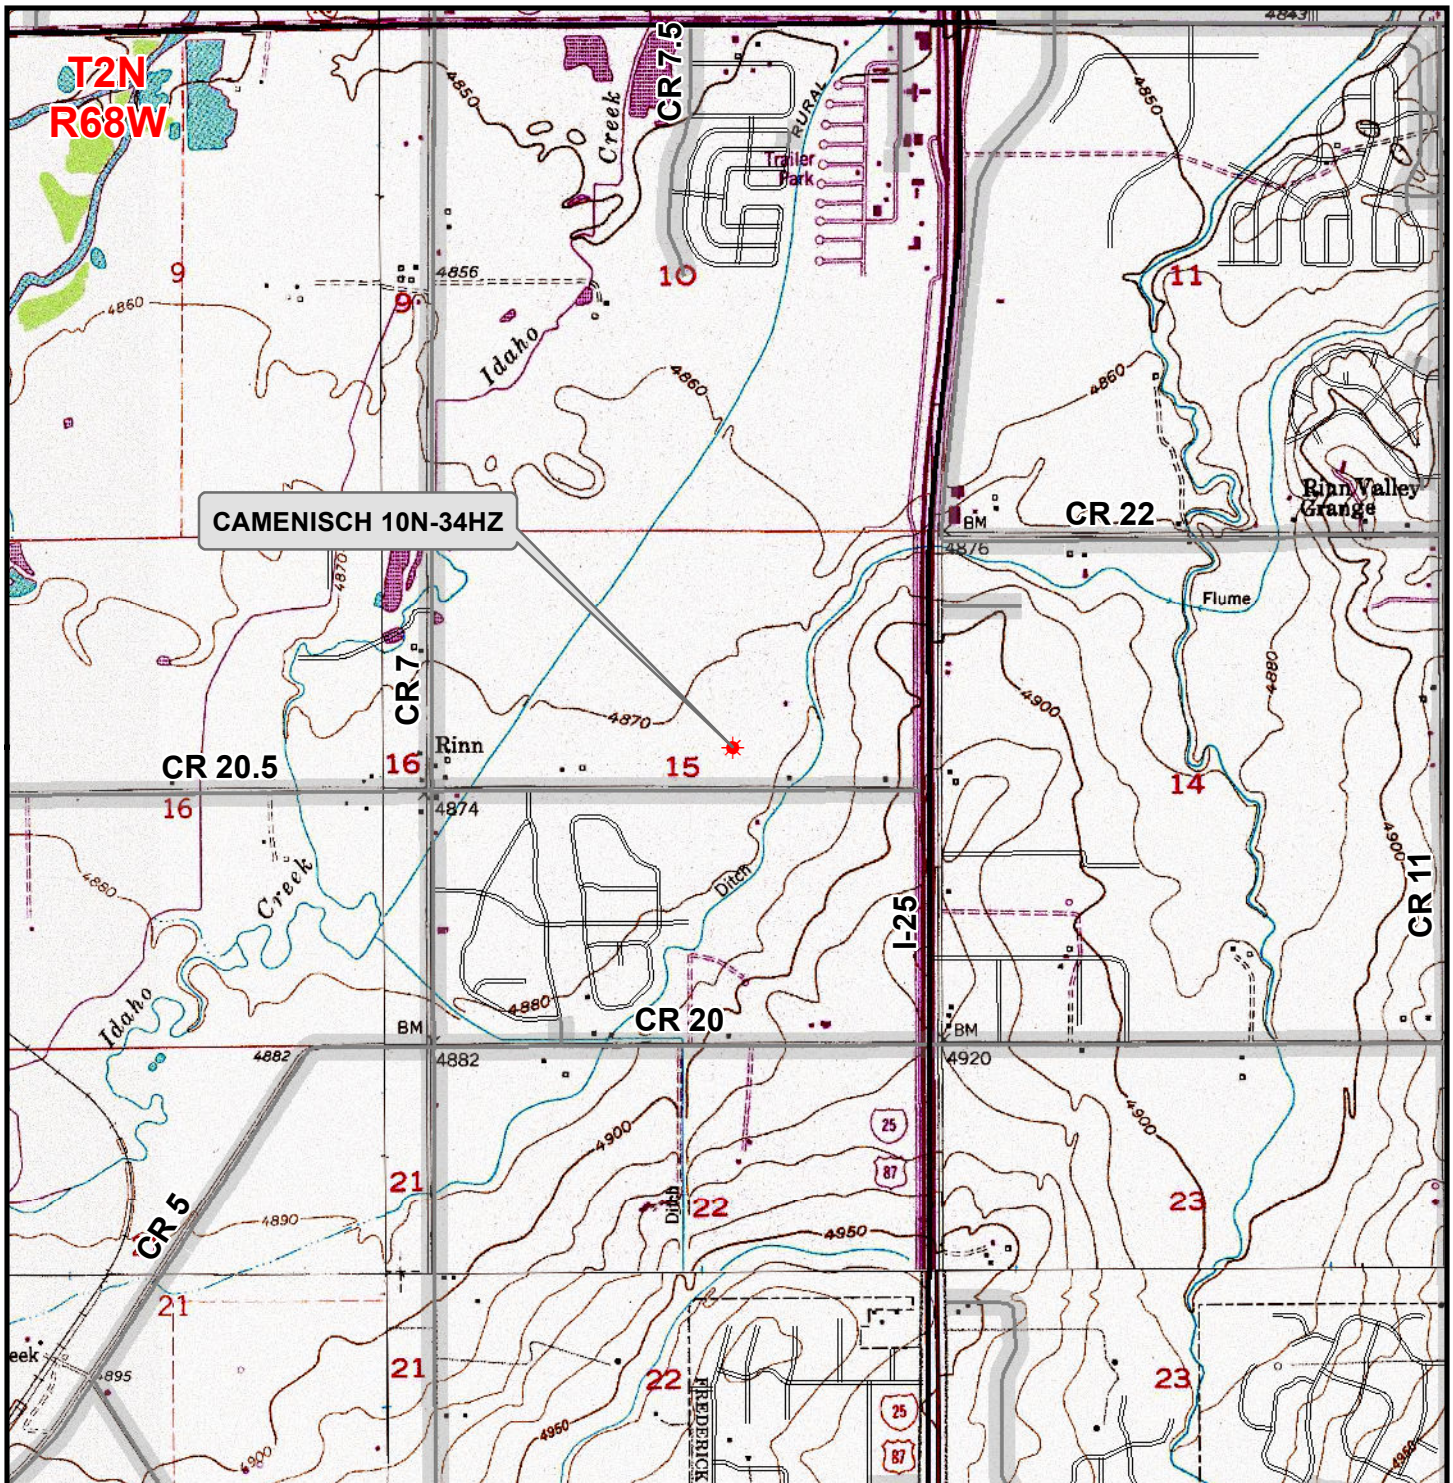

### Legend

- ★ Well - Fee - Proposed
- ==== Road - Primitive - Existing
- Road - County - Existing
- ★ Well - State - Proposed
- Road - Improved - Existing
- Road - Highway - Existing

WELL PAD - CAMENISCH 36N-22HZ

**GENERAL LOCATION MAP  
CAMENISCH 10N-34HZ  
LOCATED IN SECTION 15  
T2N, R68W, 6th P.M.  
WELD COUNTY, COLORADO**

**Kerr-McGee Oil &  
Gas Onshore L.P.**

1099 18th Street  
Denver, Colorado 80202



**CONSULTING, LLC**

**SHERIDAN OFFICE**  
1095 Saberton Avenue  
Sheridan, Wyoming 82801  
Phone 307-674-0609

**LOVELAND OFFICE**  
1635 Foxtail Drive, Suite 204  
Loveland, Colorado 80538  
Phone 970-776-4331



SCALE: 1" = 2,000ft

NAD83 CO-Nft

DRAWN: TL

DATE: 29 Sept 2015

REVISED: DP

DATE: 14 Oct 2016