


Well Name: SINJIN E36-06

VERTICAL - ORIGINAL HOLE, 12/9/2016 12:43:52 PM

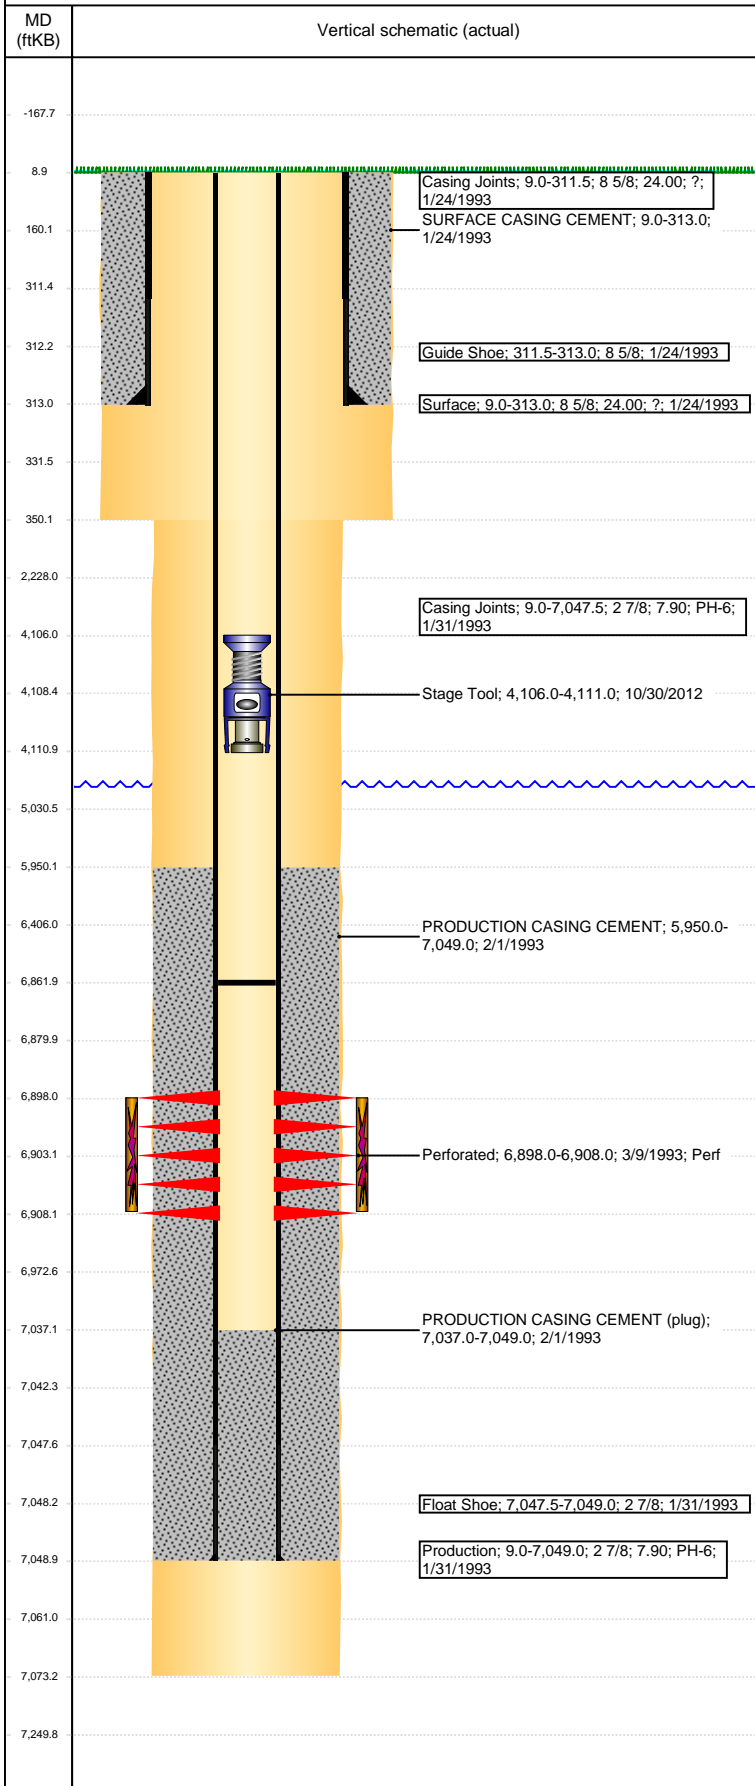

Well Header						
API 05-123-16354	Business Unit DJ BASIN		District 15	Well Config VERTICAL		
Original KB Elevation (ft) 4,662	KB - GL / MSL (ftKB) 9.00		Spud Date 1/23/1993		P & A Date	
Comment NO TBG INFO FOUND IN FILE						
Directions To Well						
Congressional Location						
Quarter 3 SE	Quarter 4 NW	Section 36	Township 6	Twnshp N/S Dir N	Range 65	Range E/W Dir W
Bottom Hole Location						
North-South Distance (ft)		From N or S Line		East-West Distance (ft)		From E or W Line
Plug Back Total Depths						
Date	Depth (ftKB)	Method		Com		
1/31/1993	7,045.0	CASING TALLY		FLOAT SHOE W/BAFFLE		
2/17/1993	7,037.0	CASED HOLE LOG		DEPTH LOGGER ON CBL		
2/25/1994	6,862.0	TAG		TAG		
Wellbore Sections						
Section Des		Size (in)		Act Top, MD (ftKB)		Act Btm, MD (ftKB)
SURFACE		12 1/4		9		350
PRODUCTION		7 7/8		350		7,073
Zone Statuses						
Zone Name	Status Date	Status	Fluid Type	Job	Prod Method	
CODELL	3/31/1993	PR		DRILLING/CO...		
Casing Strings						
Surface, 313.0ftKB						
Casing Description Surface	Run Date 1/24/1993	OD (in) 8 5/8	Wt/Len (l... 24.00	Grade ?	Top, MD (ft... 9.0	MD (ftKB) 313.0
Production, 7,049.0ftKB						
Casing Description Production	Run Date 1/31/1993	OD (in) 2 7/8	Wt/Len (l... 7.90	Grade PH-6	Top, MD (ft... 9.0	MD (ftKB) 7,049.0
Cement						
Description SURFACE CASING CEMENT				Top Depth (ftKB) 9.0		Bottom Depth (ftKB) 313.0
Description PRODUCTION CASING CEMENT				Top Depth (ftKB) 5,950.0		Bottom Depth (ftKB) 7,049.0
Tubing Strings						
Tubing Description	Run Date	String...	ID (in)	Wt (lb/ft)	Grade	Len (ft) Set De...
Other In Hole						
Run Date	Des			OD (in)	Top (ftKB)	Btm (ftKB)
10/30/2012	Stage Tool			2	4,106.0	4,111.0
Logs						
Date	Type			Top, MD (ftKB)		Btm, MD (ftKB)
1/31/1993	COMPENSATED DENSITY			3,184.0		7,039.0
1/31/1993	INDUCTION			3,184.0		3,800.0
2/17/1993	CEMENT BOND			5,850.0		7,030.0
Perforation Data						
Linked Zone	Bnch/St g	Entered Shot Total	Top (ftKB)	Btm (ftKB)		Date
CODELL, ORIGINAL HOLE		40	6,898.00	6,908.00		3/9/1993
Stimulation Intervals						
Start Date 3/10/1993		Primary Job Type DRILLING/COMPLETION - ORIGINAL				
Technical Result		Tech Result Details			Tech Result Note	
Comment						