


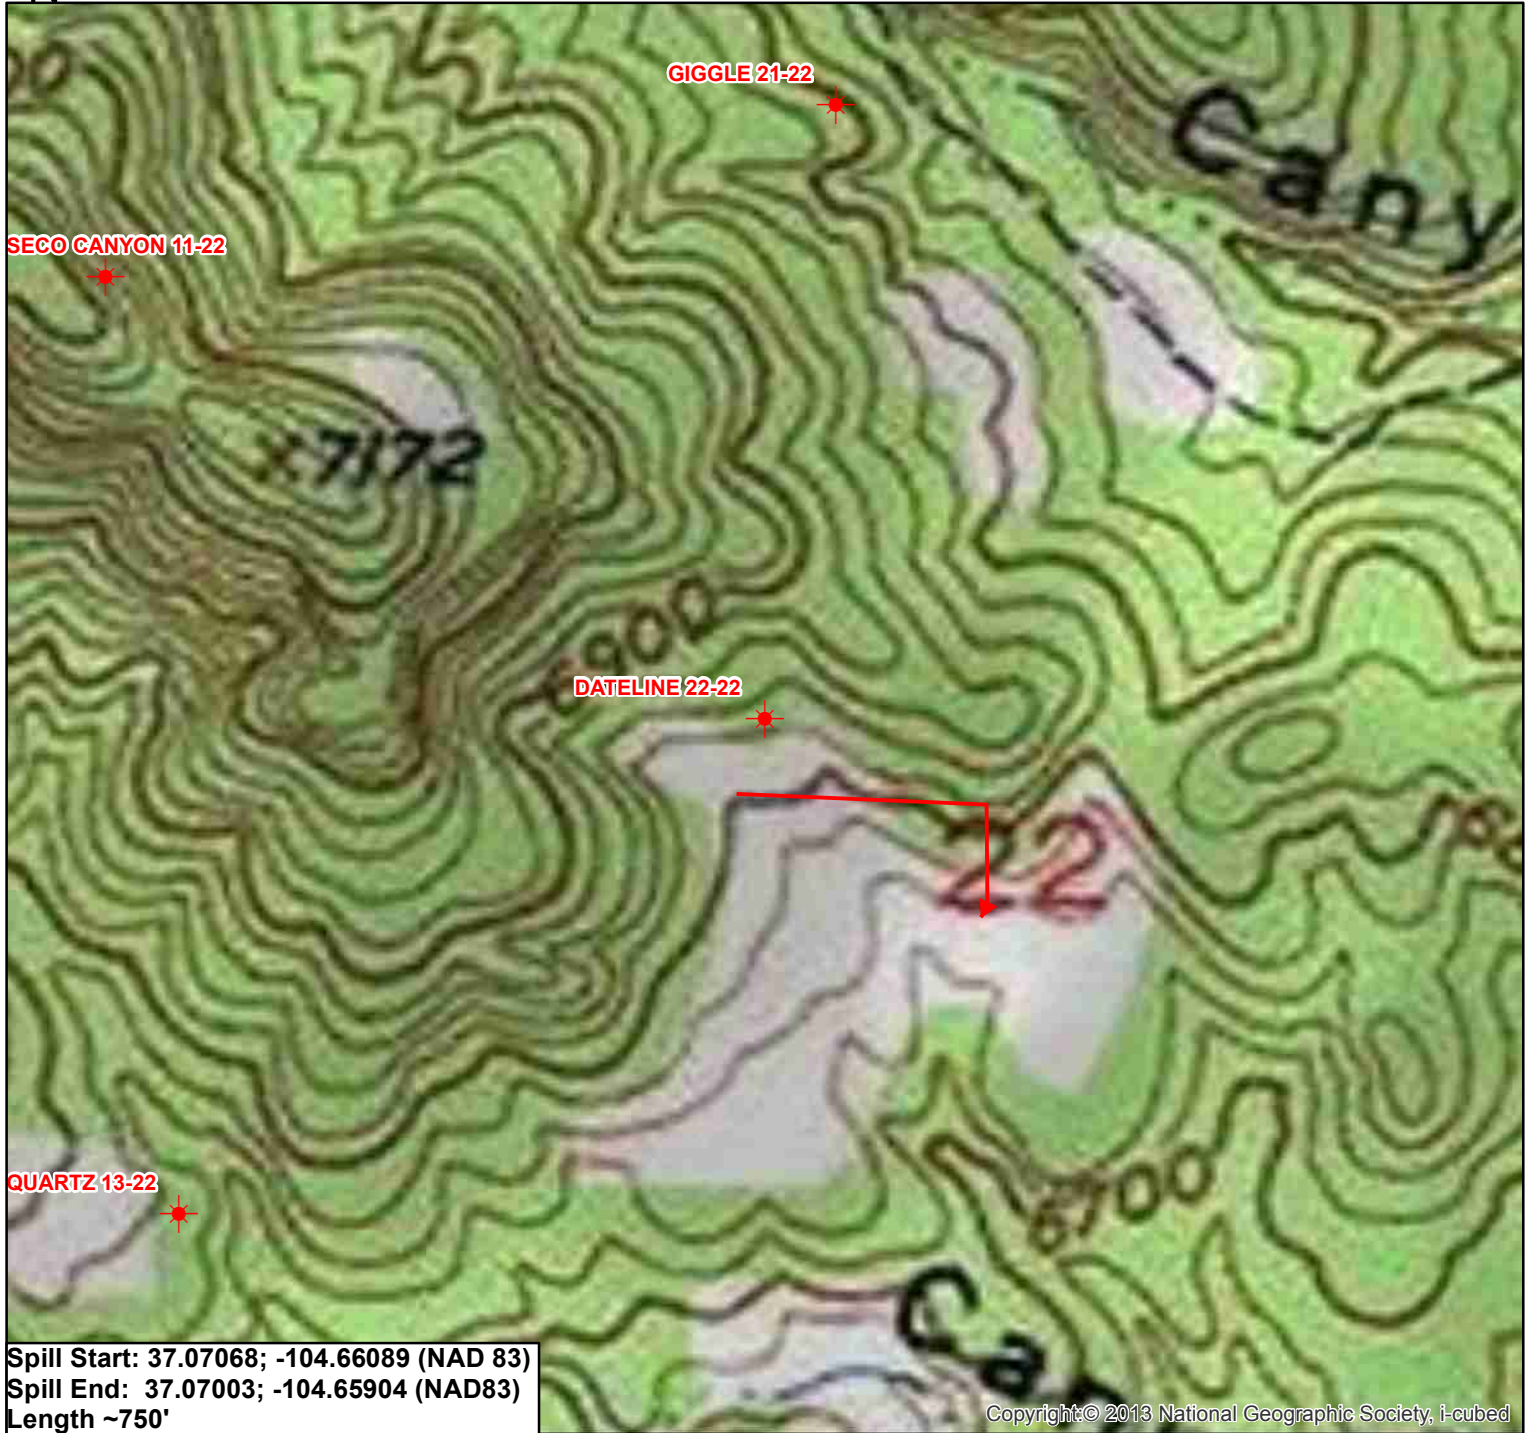

# Topographic Spill Map

Dateline 22-22 Spill



★ Permitted Well

→ Spill Path

0 250 500 750 1,000 Feet

1:5,000