


LOCATION DRAWING
MOORE UPRC H 13-2 PRODUCTION FACILITY

SECTION: 13
TOWNSHIP: 3N
RANGE: 65W

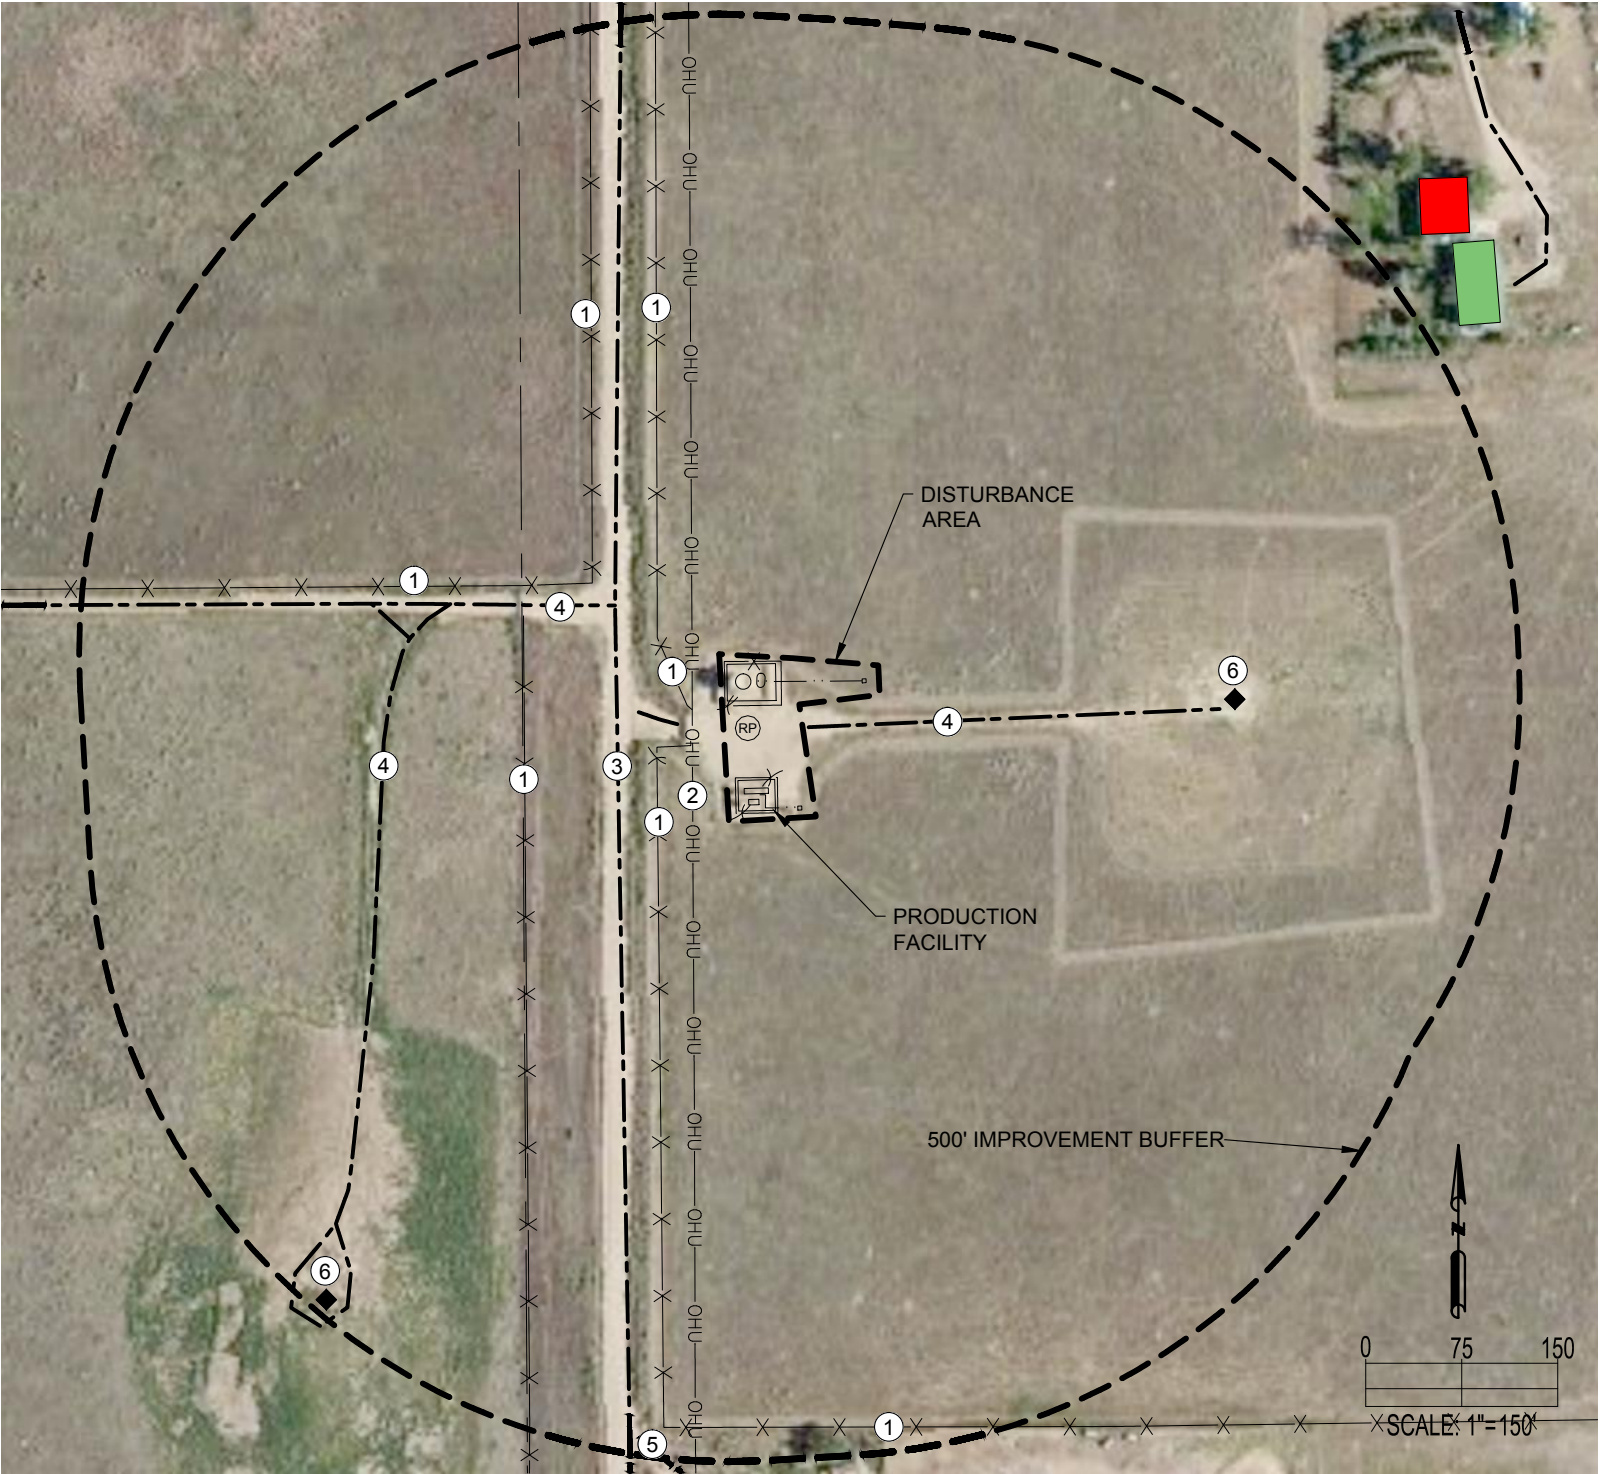

IMPROVEMENTS:
(MEASURED FROM THE MOORE UPRC H 13-2 REFERENCE POINT)

- ⓔ

NO BUILDING UNITS WITHIN 500' IMPROVEMENT BUFFER
- ⓑ

NO BUILDINGS WITHIN 500' IMPROVEMENT BUFFER
- ①

FENCE 546' S, 46' SW, 73' SW, 175' W, 51' NW, 100' NW, 166' NW
- ②

OVERHEAD UTILITY LINE 43' W
- ③

COUNTY ROAD 47 ½ 102' W
- ④

ACCESS ROAD 48' E, 18' W, 141' NW, 252' NW
- ⑤

PRIVATE ROAD 561' SW
- ⑥

EXISTING WELLHEAD 381' E, 555' SW

FACILITY REFERENCE POINT

LATITUDE: 40.23032°N

LONGITUDE: 104.61145°W

ELEVATION: 4853.5'

PDOP: 1.5

OPERATOR: CHARLES SCOTT

¼ ¼: NW¼ NE¼

FNL: 786'

FEL: 2470'

ASSOCIATED NEW WELLS:

NONE

ASSOCIATED EXISTING WELLS:

MOORE UPRC H 13-2

MEASURED FROM THE NEAREST	BUILDING	BUILDING UNIT	HIGH OCCUPANCY BUILDING UNIT	DESIGNATED OUTSIDE ACTIVITY AREA	PUBLIC ROAD	ABOVE GROUND UTILITY	RAILROAD	PROPERTY LINE
EDGE OF DISTURBANCE	526' NE	542' NE	5280'+	5280'+	81' W (CR 47.5)	21' W	5280'+	154' W

DISCLAIMER:

THIS PLOT DOES NOT REPRESENT A MONUMENTED LAND SURVEY AND SHOULD NOT BE RELIED UPON TO DETERMINE BOUNDARY LINES, PROPERTY OWNERSHIP OR OTHER PROPERTY INTERESTS. PARCEL LINES, IF DEPICTED HAVE NOT BEEN FIELD VERIFIED AND MAY BE BASED UPON PUBLICLY AVAILABLE DATA THAT ALSO HAS NOT BEEN INDEPENDENTLY VERIFIED.

DATA SOURCE:

AERIAL IMAGERY: NAIP 2015

PROPERTY BOUNDARIES: WELD COUNTY PROPERTY PORTAL

PUBLICLY AVAILABLE DATA SOURCES HAVE NOT BEEN INDEPENDENTLY VERIFIED BY PFS.

FIELD DATE: 10-25-16
DRAWING DATE: 11-15-16
DRAWN BY: MDC
CHECKED BY: CSG