


Wellbore Schematic Input Report

Well Name: DOC BUTTE E14-19

VERTICAL - Original Hole, 12/15/2016 8:13:09 AM

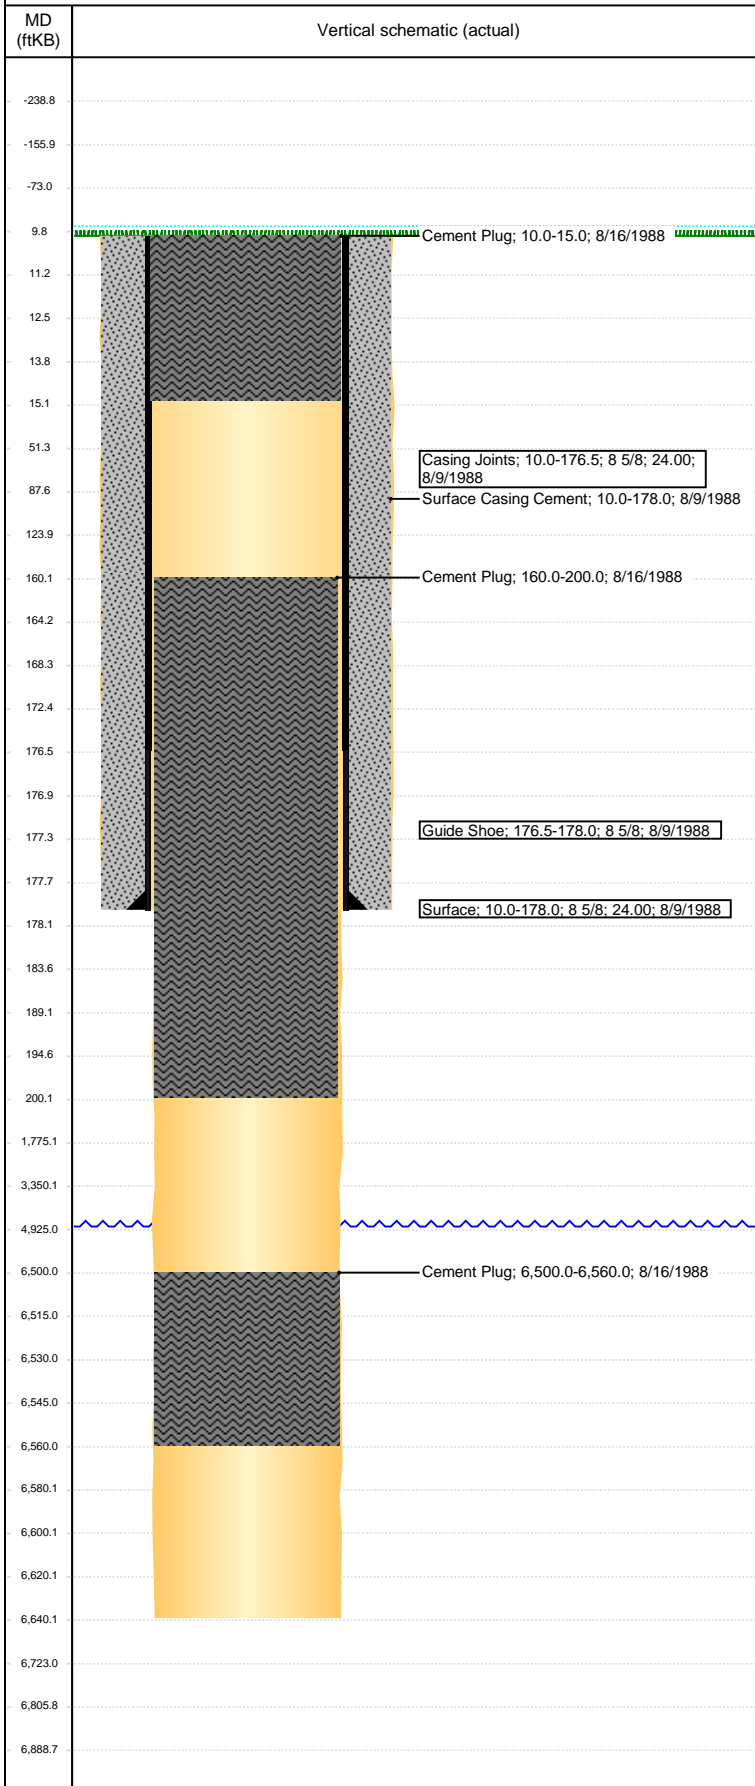

Well Header							
API 05-123-14028		Business Unit DJ BASIN		District 15		Well Config VERTICAL	
Original KB Elevation (ft) 4,841		KB - GL / MSL (ftKB) 10.00		Spud Date 8/9/1988		P & A Date 8/16/1988	
Comment VERY LITTLE INFO ON WELL.							
Directions To Well							
Congressional Location							
Quarter 3	Quarter 4	Section	Township	TwNshp N/S Dir	Range	Range E/W Dir	
Bottom Hole Location							
North-South Distance (ft)		From N or S Line		East-West Distance (ft)		From E or W Line	
Plug Back Total Depths							
Date	Depth (ftKB)	Method			Com		
Wellbore Sections							
Section Des		Size (in)		Act Top, MD (ftKB)		Act Btm, MD (ftKB)	
SURFACE		12 1/4		10		178	
PRODUCTION		7 7/8		178		6,640	
Zone Statuses							
Zone Name	Status Date	Status	Fluid Type	Job	Prod Method		
Casing Strings							
Surface, 178.0ftKB							
Casing Description Surface		Run Date 8/9/1988	OD (in) 8 5/8	Wt/Len (l... 24.00	Grade	Top, MD (ft... 10.0	MD (ftKB) 178.0
Cement							
Description Surface Casing Cement				Top Depth (ftKB) 10.0		Bottom Depth (ftKB) 178.0	
Description Cement Plug				Top Depth (ftKB) 6,500.0		Bottom Depth (ftKB) 6,560.0	
Description Cement Plug				Top Depth (ftKB) 160.0		Bottom Depth (ftKB) 200.0	
Description Cement Plug				Top Depth (ftKB) 10.0		Bottom Depth (ftKB) 15.0	
Tubing Strings							
Tubing Description		Run Date	String...	ID (in)	Wt (lb/ft)	Grade	Len (ft) Set De...
Other In Hole							
Run Date		Des			OD (in)	Top (ftKB)	Btm (ftKB)
Logs							
Date		Type			Top, MD (ftKB)	Btm, MD (ftKB)	
Perforation Data							
Linked Zone		Bnch/St g	Entered Shot Total	Top (ftKB)	Btm (ftKB)	Date	