


Legend	
◆	- Sample Location
— PL —	- Pipeline

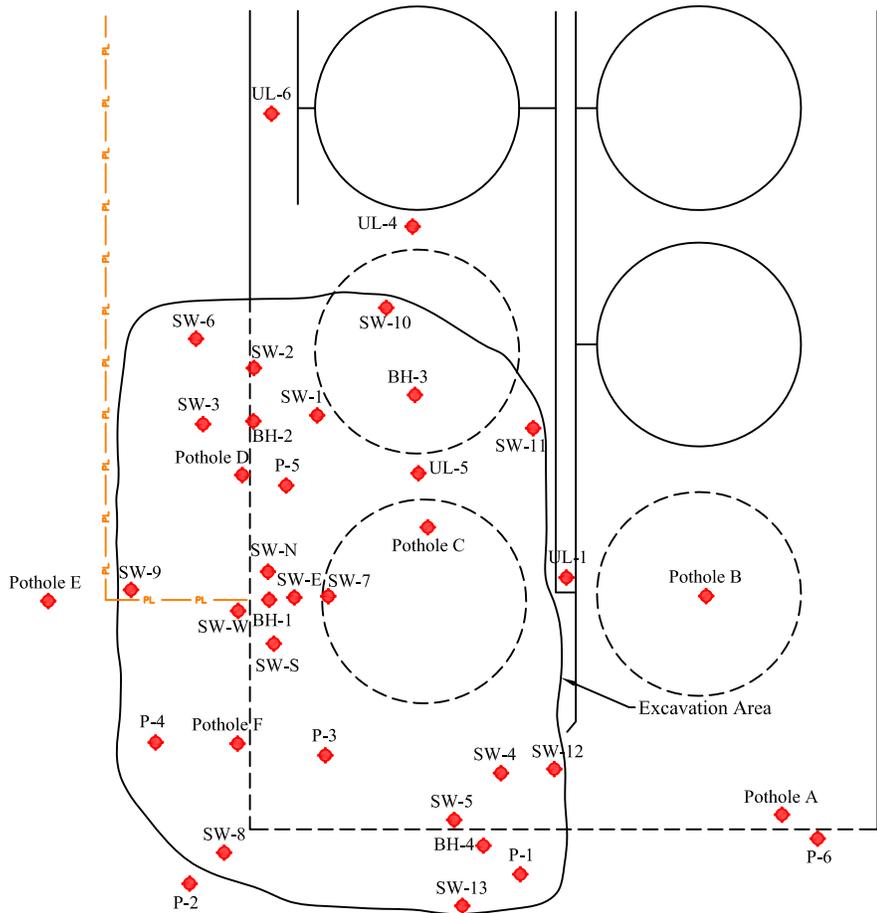

Date: 11/01/2016
 Scale: 1" = 50'
 Drawn By: TJS

Razor 30K
 Whiting Oil & Gas
 Weld County, Colorado
 Figure 1a - Site Plan - Overview of Battery



Legend
 ◆ - Sample Location
 — PL — Pipeline





0 25 50
 Scale in Feet



Date: 11/01/2016
 Scale: 1" = 50'
 Drawn By: TJS

Razor 30K
 Whiting Oil & Gas
 Weld County, Colorado
 Figure 1b - Site Plan - Detail of South End of Battery & Excavation

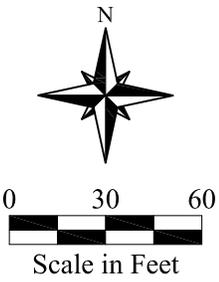
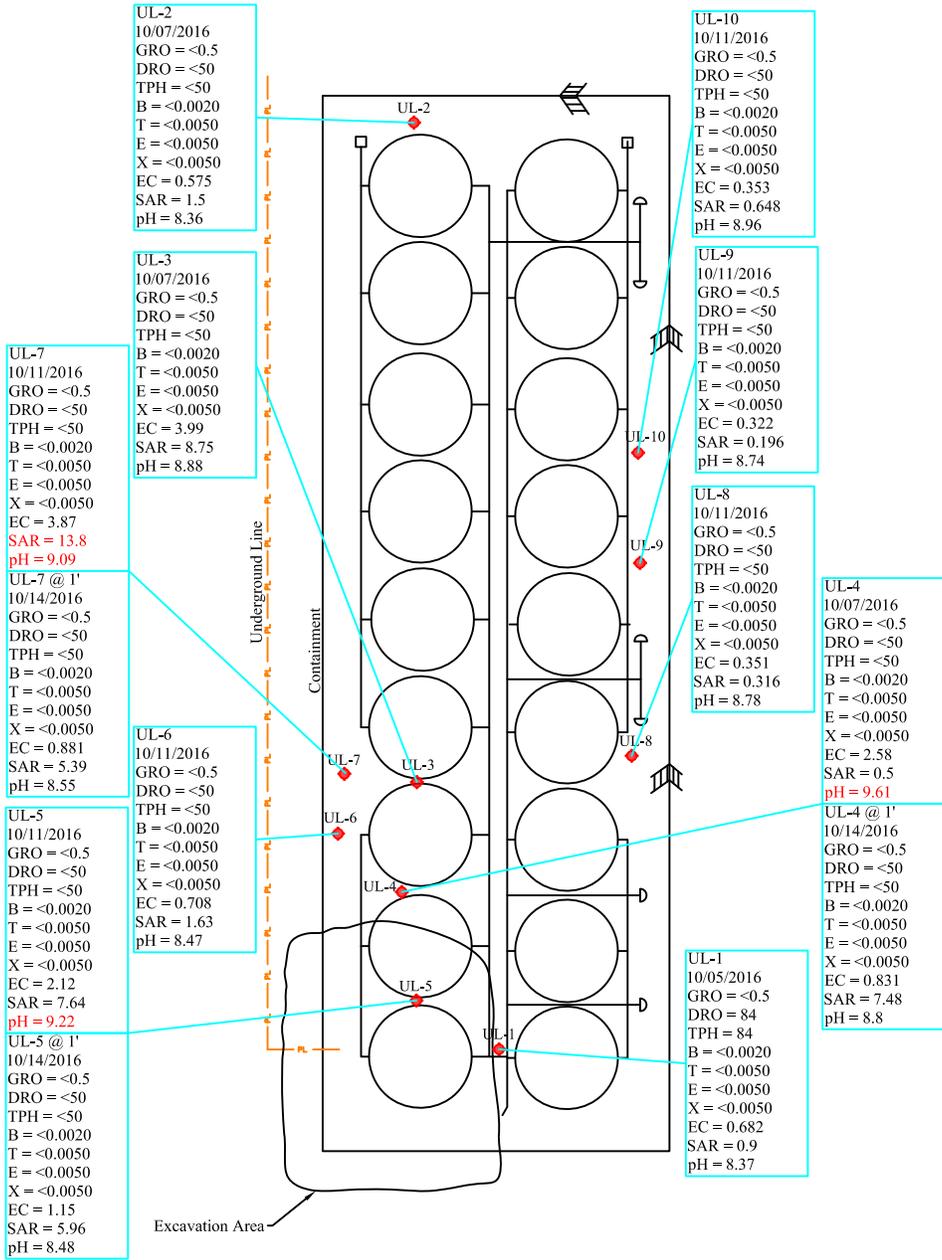


Legend	
◆	- Sample Location
—	- Pipeline
COGCC MCL's	
TPH = 500 mg/kg	
B = 0.17 mg/kg	
T = 85 mg/kg	
E = 100 mg/kg	
X = 175 mg/kg	
EC = <4 mmhos/cm	
SAR = <12 Units	
pH = 6-9 Units	



Date: 11/01/2016
Scale: 1" = 60'
Drawn By: TJS

Razor 30K
Whiting Oil & Gas
Weld County, Colorado
Figure 2a - Soil Concentration Map - Overview of Battery

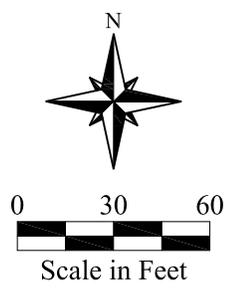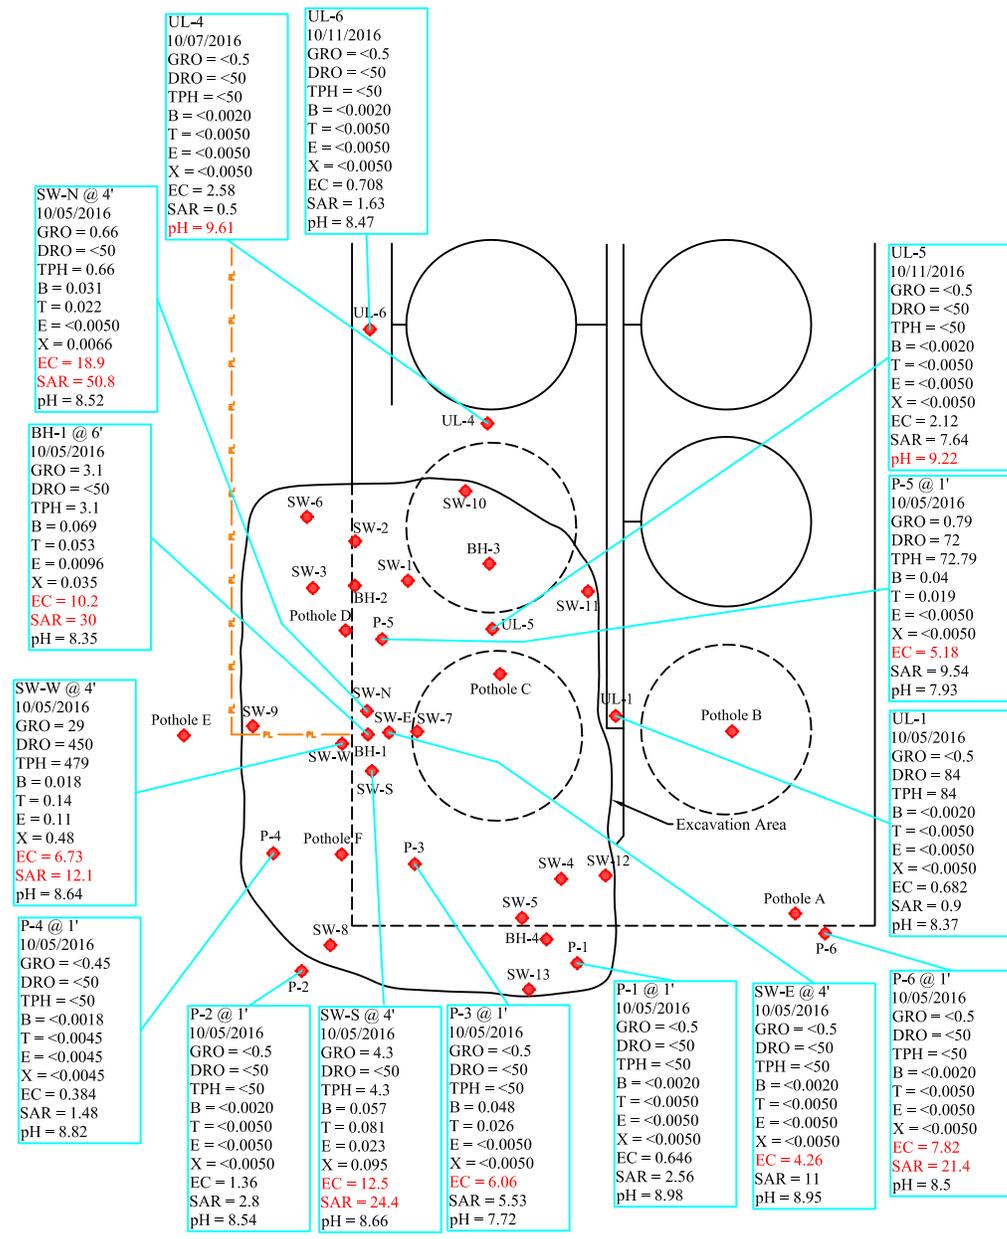

Legend

- ◆ - Sample Location
- Pipeline



COGCC MCL's

- TPH = 500 mg/kg
- B = 0.17 mg/kg
- T = 85 mg/kg
- E = 100 mg/kg
- X = 175 mg/kg
- EC = <4 mmhos/cm
- SAR = <12 Units
- pH = 6-9 Units



Date: 11/01/2016
Scale: 1" = 60'
Drawn By: TJS

Razor 30K
Whiting Oil & Gas
Weld County, Colorado
Figure 2b - Soil Concentration Map (10/05-11/2016)

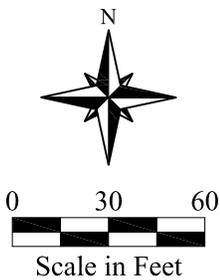
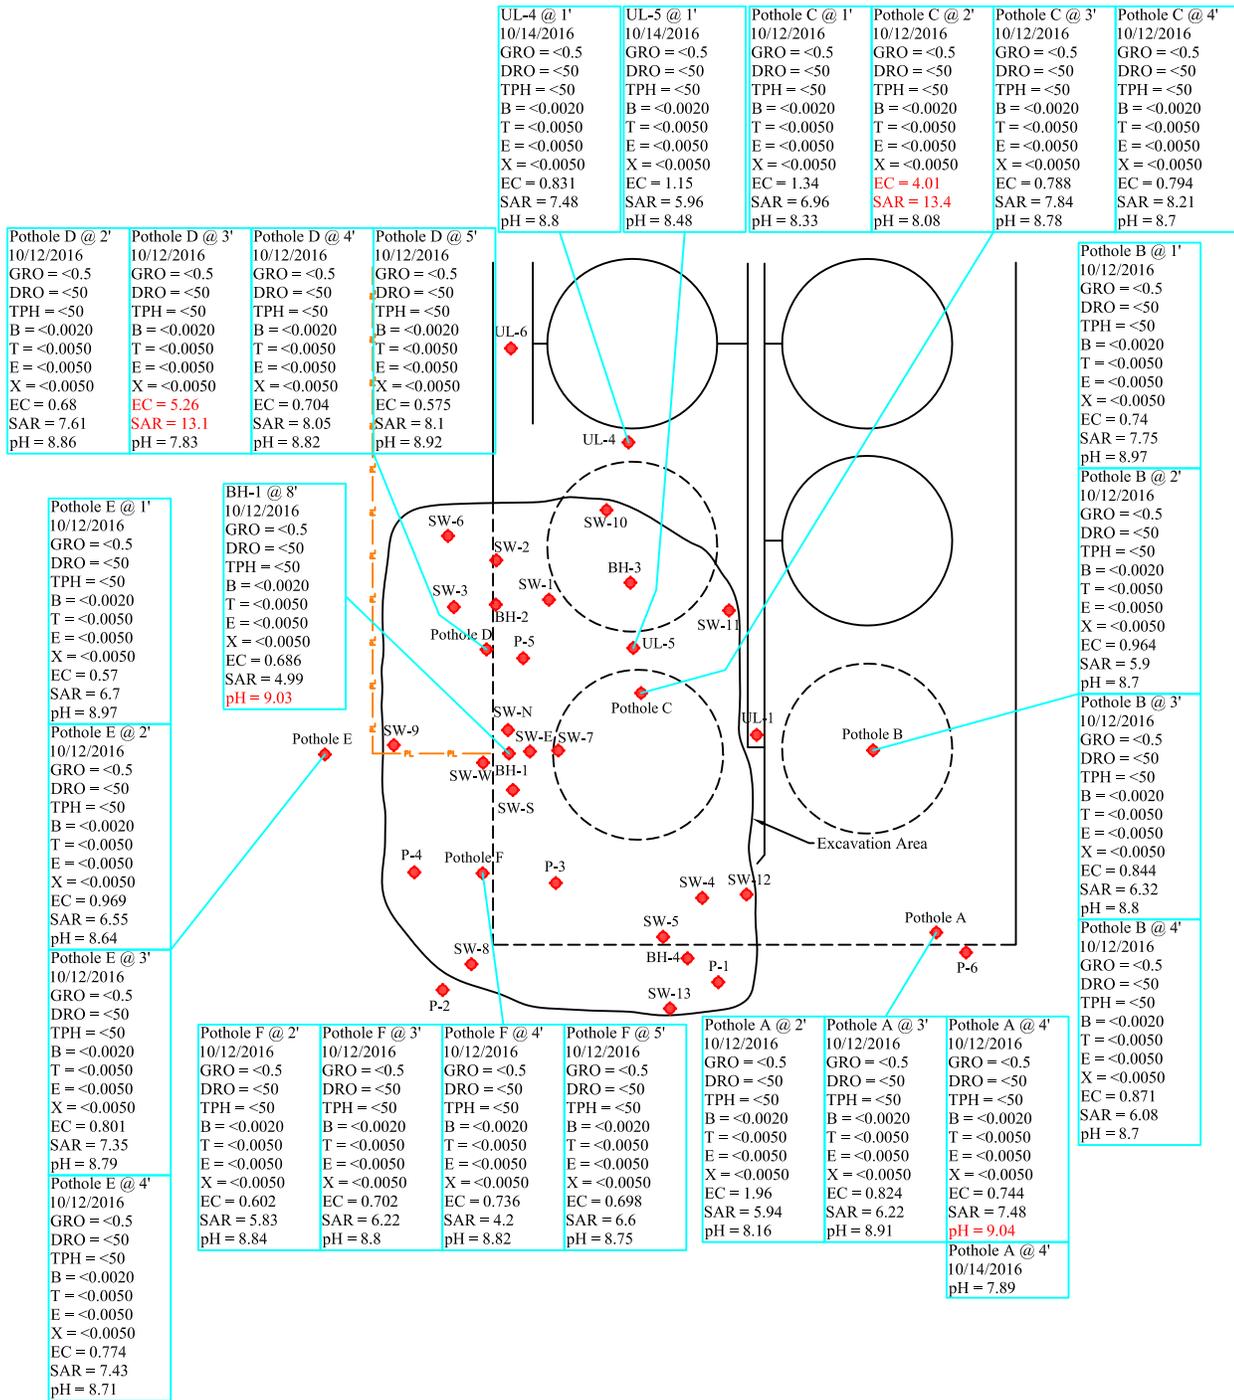


Legend	
◆	- Sample Location
—	- Pipeline
—	COGCC MCL's
	TPH = 500 mg/kg
	B = 0.17 mg/kg
	T = 85 mg/kg
	E = 100 mg/kg
	X = 175 mg/kg
	EC = <4 mmhos/cm
	SAR = <12 Units
	pH = 6-9 Units



Date: 11/01/2016
 Scale: 1" = 60'
 Drawn By: TJS

Razor 30K
 Whiting Oil & Gas
 Weld County, Colorado
 Figure 2c - Soil Concentration Map (10/12-14/2016)

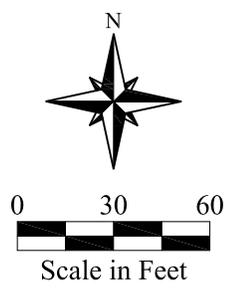
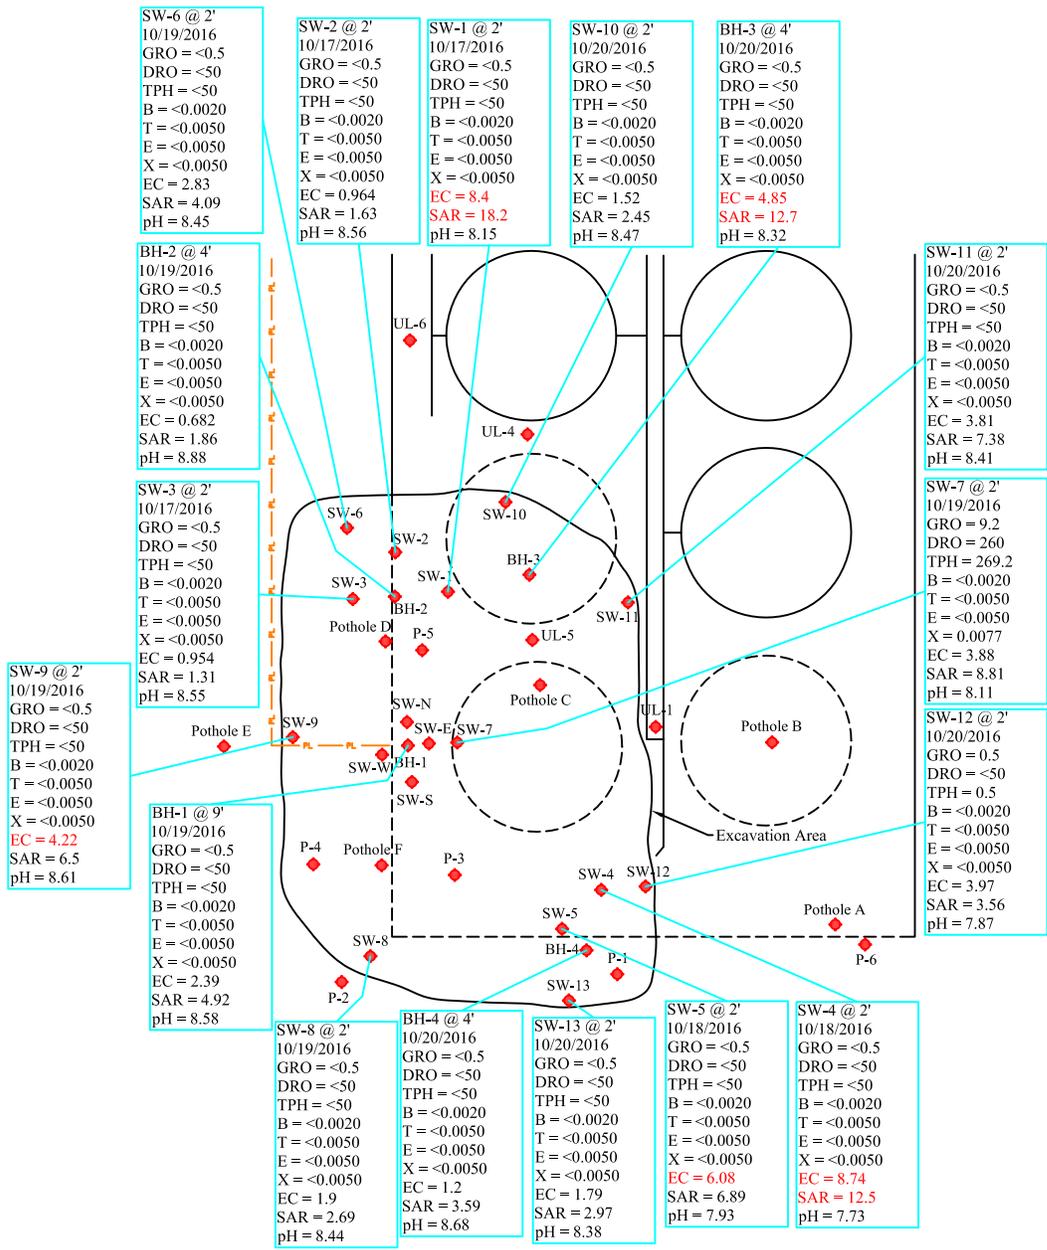


Legend	
◆	- Sample Location
—	- Pipeline
	COGCC MCL's
	TPH = 500 mg/kg
	B = 0.17 mg/kg
	T = 85 mg/kg
	E = 100 mg/kg
	X = 175 mg/kg
	EC = <4 mmhos/cm
	SAR = <12 Units
	pH = 6-9 Units



Date: 11/01/2016
 Scale: 1" = 60'
 Drawn By: TJS

Razor 30K
 Whiting Oil & Gas
 Weld County, Colorado
 Figure 2d - Soil Concentration Map (10/17-20/2016)

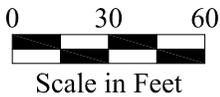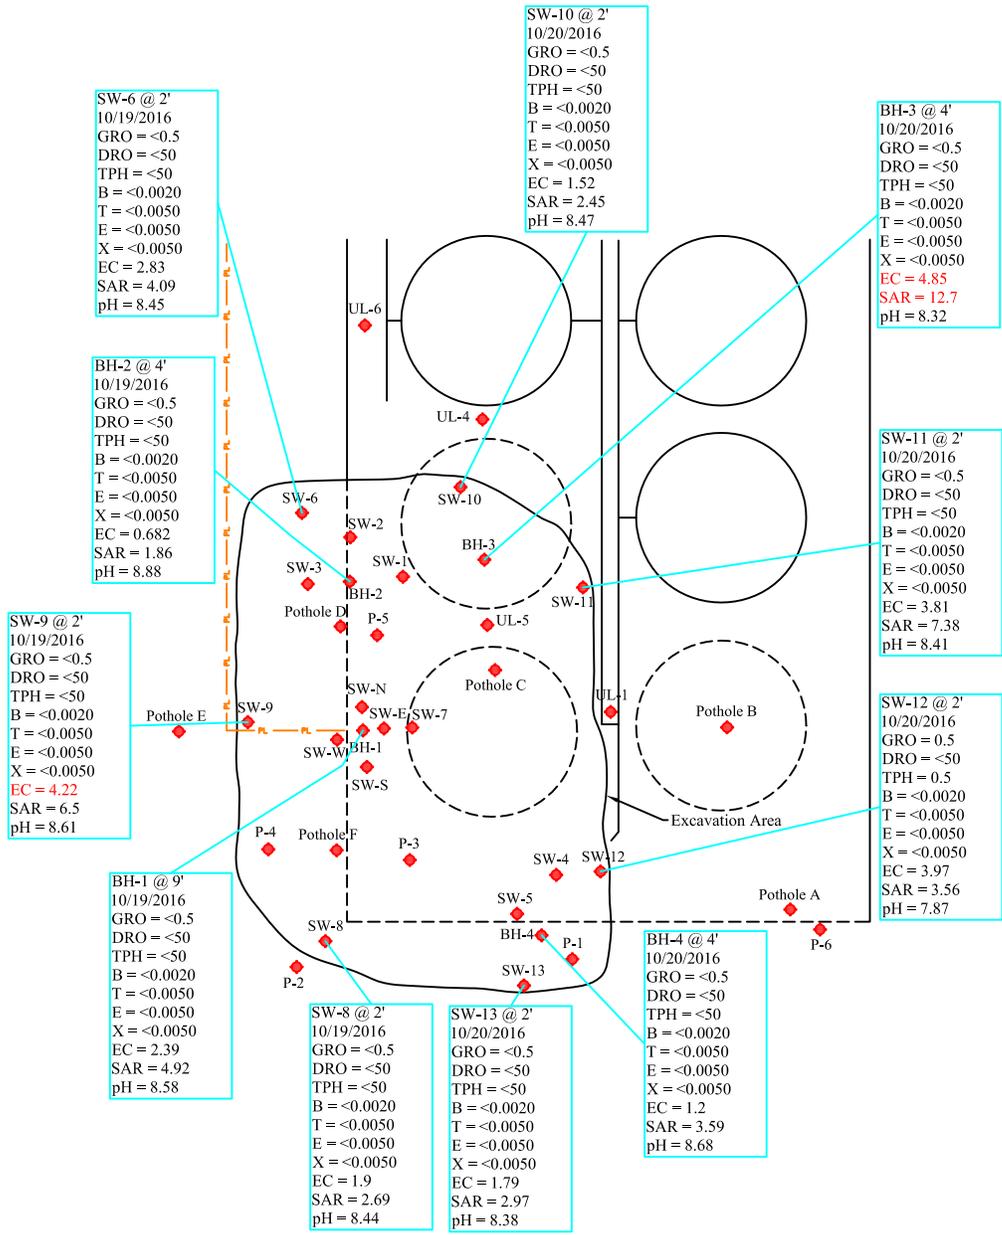

Legend

- ◆ - Sample Location
- Pipeline

COGCC MCL's

- TPH = 500 mg/kg
- B = 0.17 mg/kg
- T = 85 mg/kg
- E = 100 mg/kg
- X = 175 mg/kg
- EC = <4 mmhos/cm
- SAR = <12 Units
- pH = 6-9 Units



Date: 11/01/2016
Scale: 1" = 60'
Drawn By: TJS

Razor 30K
Whiting Oil & Gas
Weld County, Colorado
Figure 2e - Soil Concentration Map (Final Excavation Limits)