API:	**05-123-16663**	**KB ELEVATION:**	**5017'**	**QTR-QTR:**	**NW SE**
WELL NAME:	**DIPAOLO RED W 25-10**	**GROUND LEVEL:**	**5007'**	**SECTION:**	**25**
COUNTY:	**WELD**	**MD:**	**8058'**	**TWNSHIP:**	**2N**
LATITUDE:	**40.108258**	**PBMD:**	**8053'**	**RANGE:**	**66W**
LONGITUDE:	**-104.723754**	**CREATED BY:**	**Sterling Metzger/C GRAY**		
		DATE:	10/27/2016		

EXISTING **FINAL**

DATUM: RKB
KB=10'

Surface Casing
Hole Size/Depth 12 1/4" - 1067'

Deepest Water Well 846'
Casing Size/Depth: 8-5/8", 24#/ft @ 1067'

Fox Hills Marker 1490'

TOC (from CBL) 3456'

Sussex Top 4514'
Productive within 1 mile
Sussex base 4763'

Shannon Base Absent
Not Productive within 1 mile

BOC (from CBL) 4920'

TOC (from CBL) 6100'

Nio Top 7158'

Codell Perfs 7454' - 7464'

Top of Liner 7466'
TOC of Liner (from CBL) 7466'

Production Casing/Hole
Casing Size/Depth 3 1/2'' x 9.3#/ft @ 7624'
Hole Size/Depth 7 7/8" (bit size) @ 7624'
J Sand Perfs 7908'-7946'

Deepening:
2 3/8" x 4.7#/ft @ 8058'
2 7/8" (bit size) @ 8058'

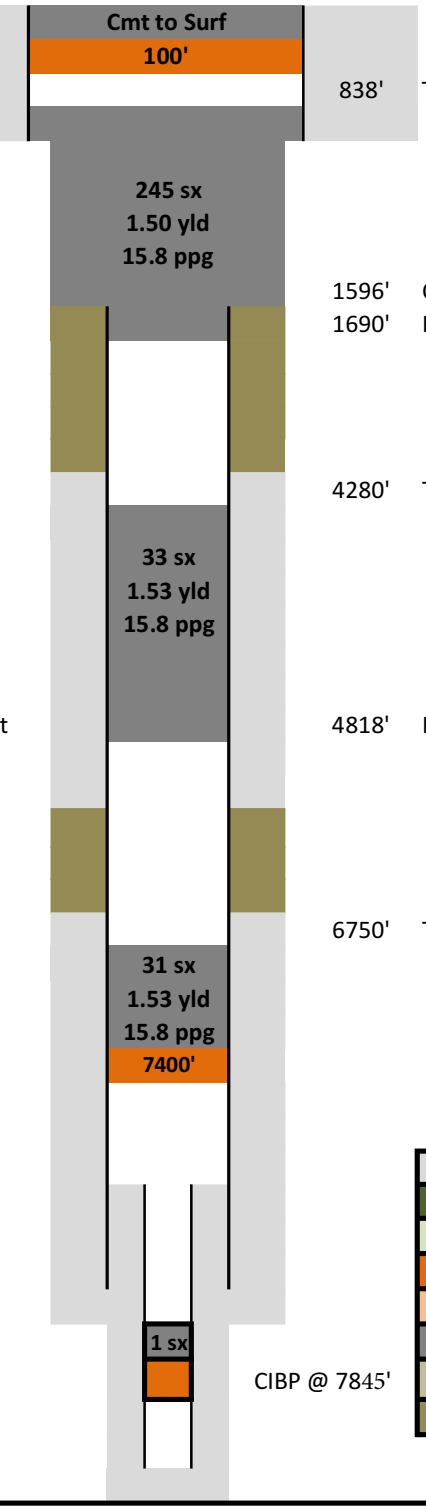

838' Tgd TOC in casing
1596' Cut off casing
1690' BOC in csg
4280' Tgd TOC in csg
4818' BOC in csg
6750' TOC in casing

Existing Cement
New CICR
Existing CICR
New CIBP
Existing CIBP
New Cement
Sand Plug
Existing Mud