


TEP Rocky Mountain LLC
 SR 444-12
 Rulison Field
 Section 12 T 7S-R94W

Formation Tops
 (Measured Depths)

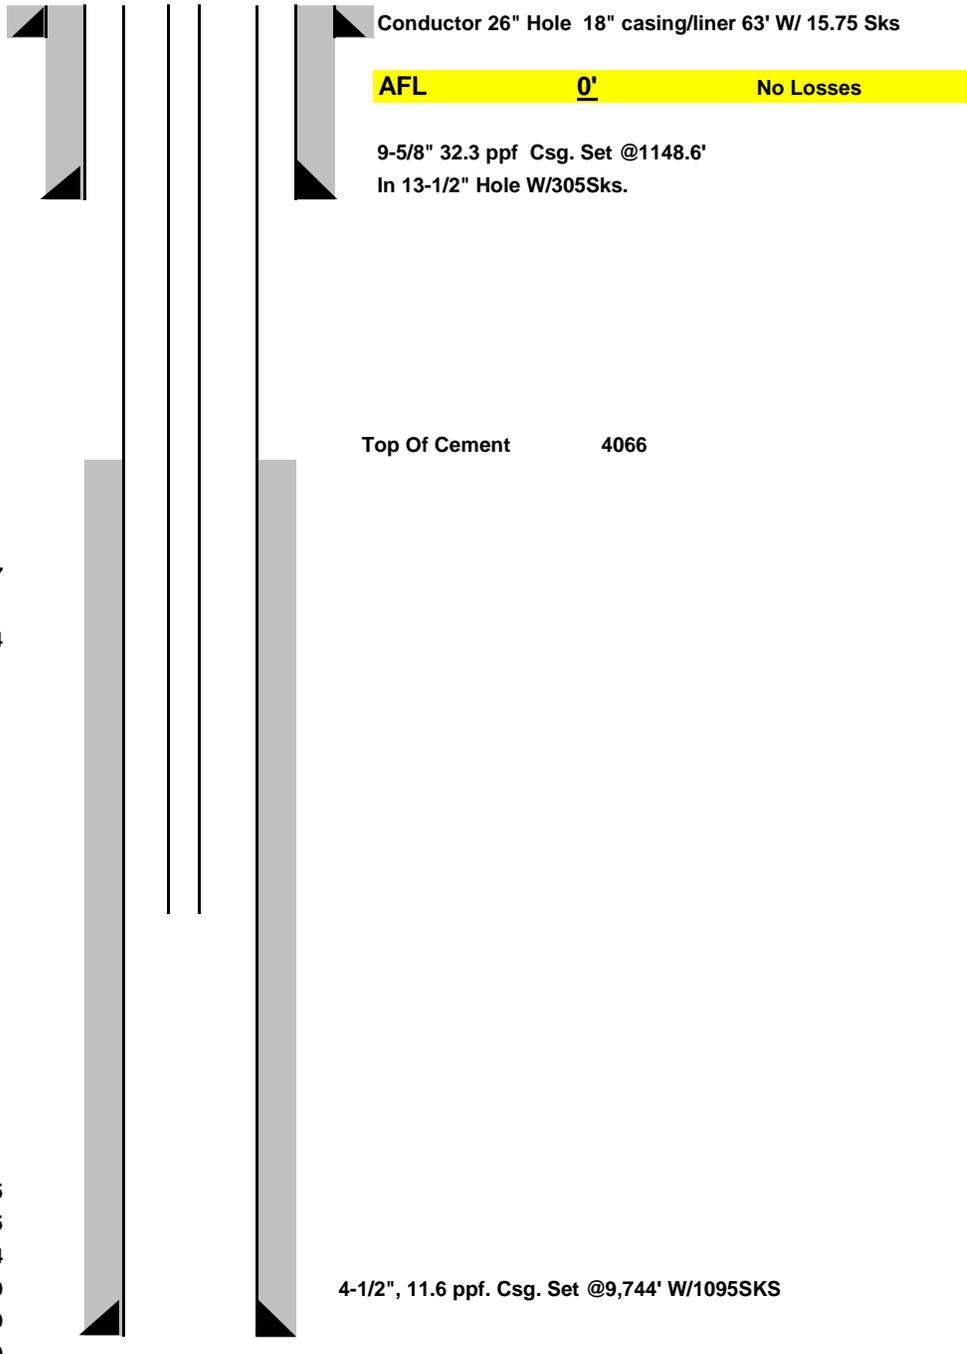

AFL 0' No Losses

9-5/8" 32.3 ppf Csg. Set @1148.6'
 In 13-1/2" Hole W/305Sks.

Top Of Cement 4066

"G" Sand @ 3347
 Mesaverde @ 5704
 Cameo @ 8371

Tubing not set

PBSD @ 9705
 Float Collar @ 9715
 TMD @ 9754
 TVD @ 9429
 Est.Top Perf @ 7239
 Top Of Gas @ 7339

4-1/2", 11.6 ppf. Csg. Set @9,744' W/1095SKS