

\\SYNERGY RESOURCES\2016\_81\_GOETZEL\_T6N\_R66W\_SEC\_29\PLATS\GOETZEL 7-29 PLAT.dwg, 9/22/2016 1:48:22 PM, lisa




JOHN R. SLAUGH  
PROFESSIONAL LAND SURVEYOR  
COLORADO REGISTRATION NUMBER 18232

**NOTICE:**  
ACCORDING TO COLORADO STATE LAW YOU MUST COMMENCE ANY LEGAL ACTION BASED UPON ANY DEFECT IN THIS SURVEY WITHIN THREE YEARS AFTER YOU FIRST DISCOVER SUCH DEFECT. IN NO EVENT MAY ANY ACTION BASED UPON ANY DEFECT IN THIS SURVEY BE COMMENCED MORE THAN TEN YEARS FROM THE DATE ON THE CERTIFICATION SHOWN HEREON.

GOETZEL 32C-30-M  
WELL LOCATION CERTIFICATE  
2073' FNL & 2446' FEL SWNE (SURFACE)  
2278' FNL & 2577' FWL SENW (TOP OF PRODUCTION)  
LOCATED IN SECTION 29  
2303' FNL & 510' FWL LOT 2 (SWNW) (BOTTOM)  
LOCATED IN SECTION 30  
T6N, R66W, 6TH P.M.  
WELD COUNTY, COLORADO

**BUILDING: ±1624' W**  
**BUILDING UNIT: ±1624' W**  
**HIGH OCCUPANCY BUILDING UNIT: 5280'+**  
**DESIGNATED OUTSIDE ACTIVITY AREA: 5280'+**  
**PUBLIC ROAD: ±2059' N**  
**PROPERTY LINE: ±220' W**  
**ABOVE GROUND UTILITY: ±952' SW**  
**RAILROAD: ±1572' S**


1. ▲ INDICATES SECTION CORNER
2. ● INDICATES CALCULATED CORNER
3. DRAWING LATITUDE AND LONGITUDE COORDINATES  
ARE NAD 83 (2011)(EPOCH:2010)
4. ELEVATION BASED ON NAVD88 (GEOID12B)
5. BASIS OF BEARING DERIVED FROM COLORADO COORDINATE  
SYSTEM OF 1983 NORTH ZONE.
6. ALL MEASURED DISTANCES ARE GRID.  
COMBINED SCALE FACTOR: .99974048 CALCULATED FROM  
THE W. 1/4 CORNER OF SECTION 29
7. OPERATOR: ROB WILSON / PDOP = 1.2
8. SEE ADDENDUM TO WELL LOCATION CERTIFICATE FOR  
EXISTING IMPROVEMENTS WITHIN 500' OF THE WELL PAD.
9. WELL FOOTAGES ARE MEASURED AT RIGHT ANGLES TO THE  
SECTION LINES.
10. THE BOTTOM OF HOLE BEARS S87°16'26"W, 7912' FROM THE  
TOP OF PRODUCTION ZONE.

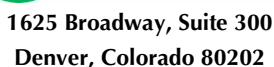

**SHERIDAN OFFICE**  
1095 Saberton Avenue  
Sheridan, Wyoming 82801  
Phone 307-674-0609

DRAFTED BY: LMO		CHECKED BY: JRS	SHEET NO:  <b>1</b> 1 OF 2
DATE DRAFTED: 8/30/16		DATE SURVEYED: 7/7/16	
REVISED: 9/21/16		FILE NAME: 16-81	

# T6N, R66W

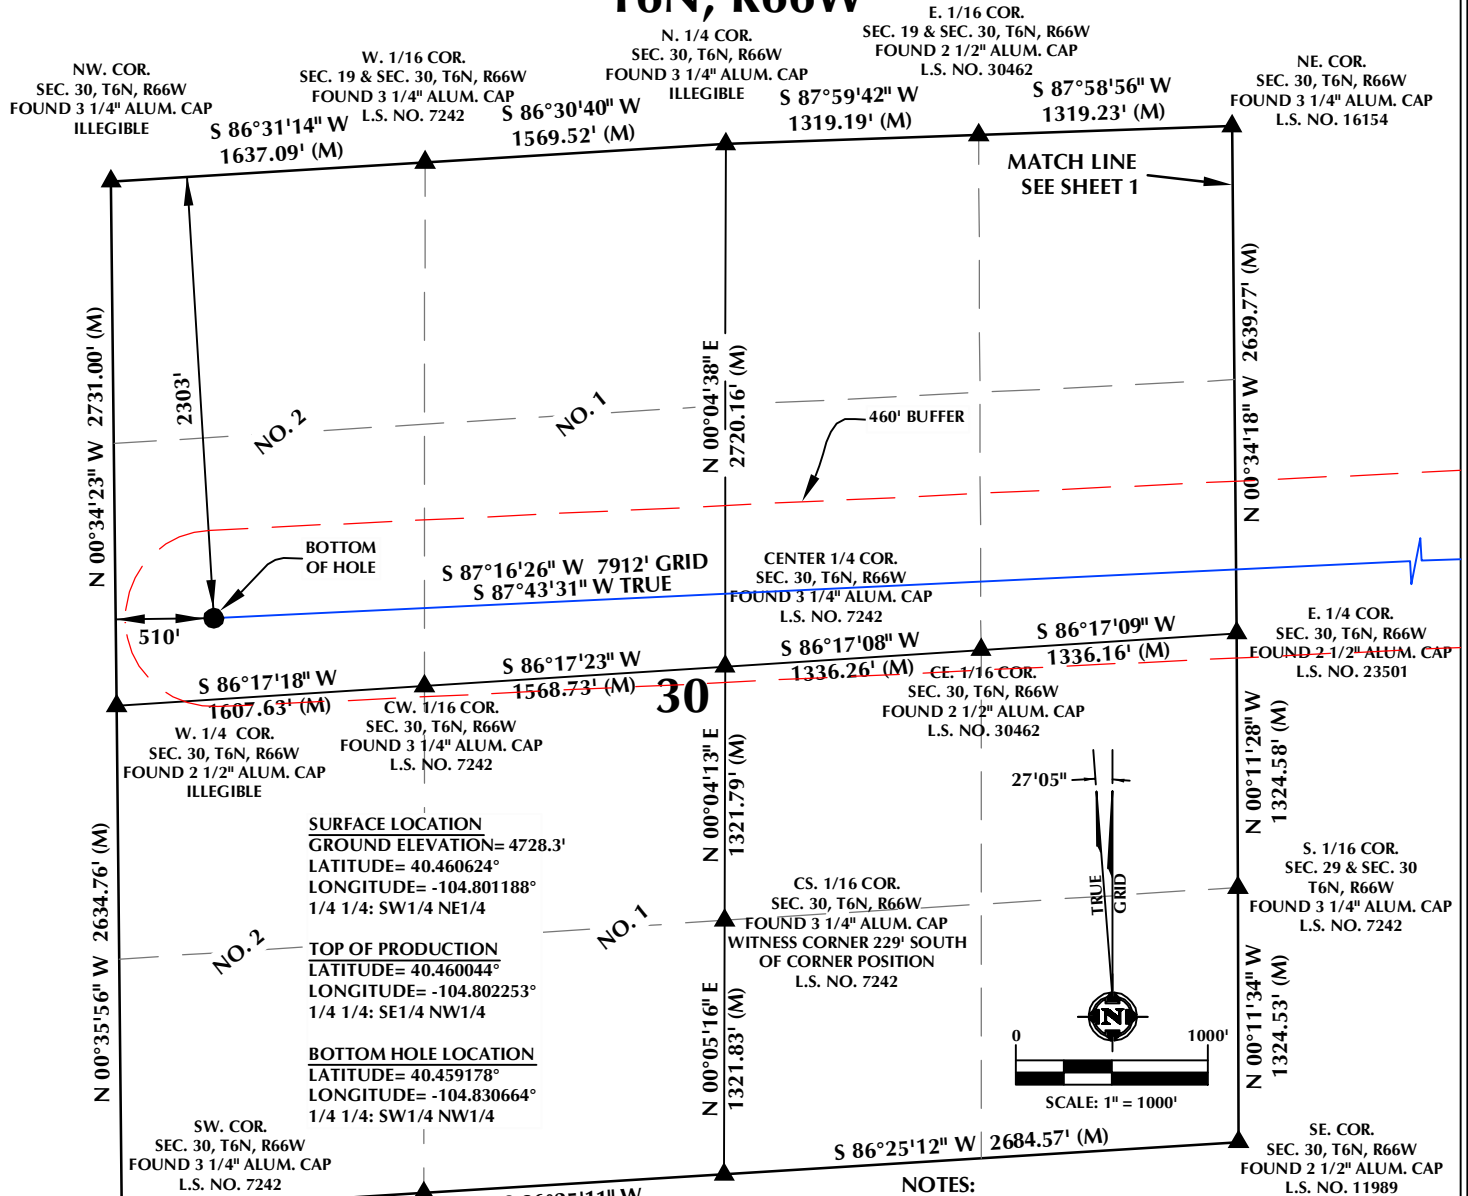

## CERTIFICATE OF SURVEYOR:

THIS IS TO CERTIFY THAT THE ABOVE PLAT WAS PREPARED FROM FIELD NOTES OF ACTUAL SURVEY MADE BY ME OR UNDER MY SUPERVISION AND THAT THE SAME ARE TRUE AND CORRECT TO THE BEST OF MY KNOWLEDGE AND BELIEF. THIS CERTIFICATE DOES NOT REPRESENT A LAND SURVEY PLAT OR IMPROVEMENT SURVEY PLAT AS DEFINED BY C.R.S. 38-51-302 AND CANNOT BE RELIED UPON TO DETERMINE OWNERSHIP.

JOHN R. SLAUGH  
PROFESSIONAL LAND SURVEYOR  
COLORADO REGISTRATION NUMBER 18230

NOTICE:  
ACCORDING TO COLORADO STATE LAW YOU MUST COMMENCE ANY LEGAL ACTION BASED UPON ANY DEFECT IN THIS SURVEY WITHIN THREE YEARS AFTER YOU FIRST DISCOVER SUCH DEFECT. IN NO EVENT MAY ANY ACTION BASED UPON ANY DEFECT IN THIS SURVEY BE COMMENCED MORE THAN TEN YEARS FROM THE DATE ON THE CERTIFICATION SHOWN HEREON.

## WELL DISTANCES:

BUILDING: ±1624' W  
BUILDING UNIT: ±1624' W  
HIGH OCCUPANCY BUILDING UNIT: 5280'+  
DESIGNATED OUTSIDE ACTIVITY AREA: 5280'+  
PUBLIC ROAD: ±2059' N  
PROPERTY LINE: ±220' W  
ABOVE GROUND UTILITY: ±952' SW  
RAILROAD: ±1572' S

## WELL PAD - GOETZEL 7-29

GOETZEL 32C-30-M  
WELL LOCATION CERTIFICATE  
2073' FNL & 2446' FEL SWNE (SURFACE)  
2278' FNL & 2577' FWL SENW (TOP OF PRODUCTION)  
LOCATED IN SECTION 29  
2303' FNL & 510' FWL LOT 2 (SWNW) (BOTTOM)  
LOCATED IN SECTION 30  
T6N, R66W, 6TH P.M.  
WELD COUNTY, COLORADO



1625 Broadway, Suite 300  
Denver, Colorado 80202



## CONSULTING, LLC

SHERIDAN OFFICE  
1095 Saberton Avenue  
Sheridan, Wyoming 82801  
Phone 307-674-0609

LOVELAND OFFICE  
1635 Foxtrail Drive, Suite 204  
Loveland, Colorado 80538  
Phone 970-776-4331

DRAFTED BY:	LMO	CHECKED BY:	JRS	SHEET NO:
DATE DRAFTED:	8/30/16	DATE SURVEYED:	7/7/16	2
REVISED:	9/21/16	FILE NAME:	16-81	2 OF 2