


**TEP Rocky Mountain LLC
SR 44-12
Rulison Field
Section 12T 7S-R94W**

**Formation Tops
(Measured Depths)**

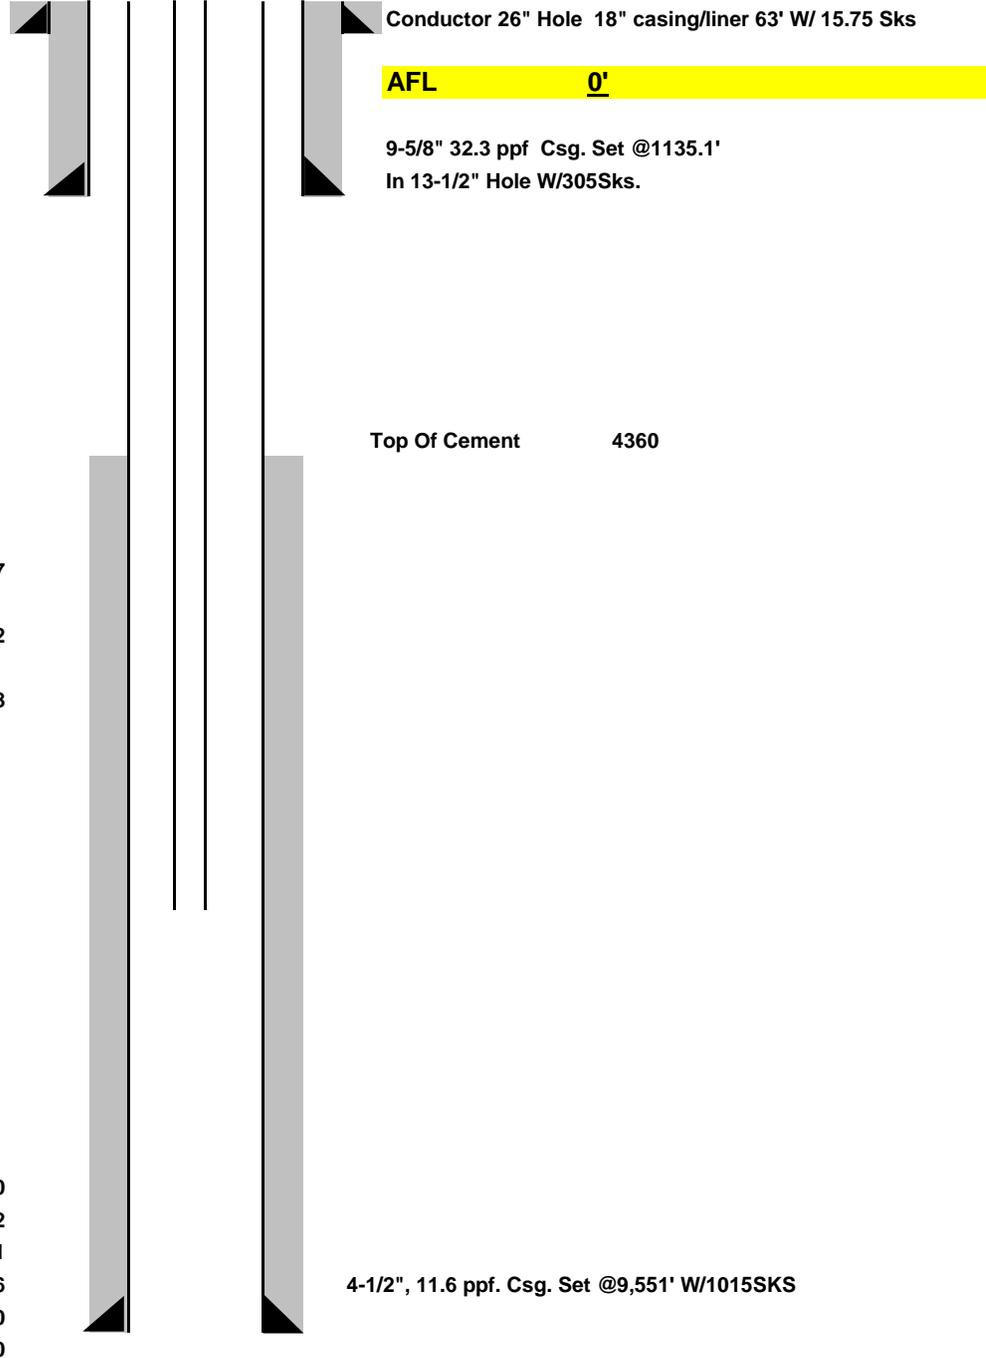

Tubing not set