


T10N, R58W, 6th P.M.

LEGEND:

- └─ = 90° SYMBOL
- = PROPOSED WELLHEAD.
- = TARGET BOTTOM HOLE.
- ◇ = TOP OF PRODUCTION.
- ▲ = SECTION CORNERS LOCATED. (NAD 83)

2011 Alum. Cap,
#28285 0.2' High,
Lat: 40.816467°
Long: 103.899111°

LINE TABLE		
LINE	DIRECTION	LENGTH
L1	N19°02'26"W	439.74'

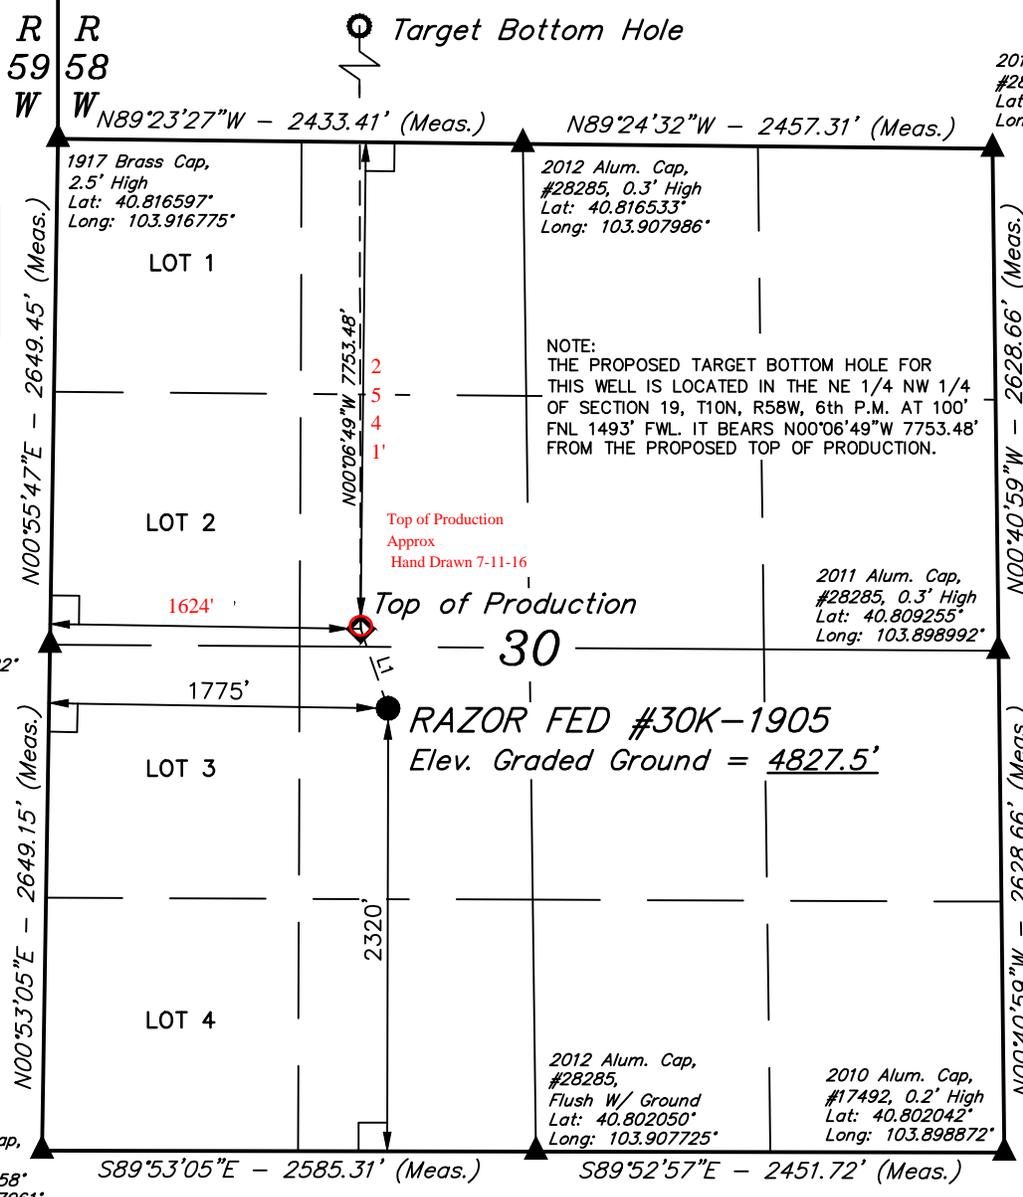

1917 Brass Cap,
1' High
Lat: 40.809328°
Long: 103.916922°

NOTE:
THE PROPOSED TARGET BOTTOM HOLE FOR THIS WELL IS LOCATED IN THE NE 1/4 NW 1/4 OF SECTION 19, T10N, R58W, 6th P.M. AT 100' FNL 1493' FWL. IT BEARS N00°06'49"W 7753.48' FROM THE PROPOSED TOP OF PRODUCTION.

2011 Alum. Cap,
#28285, 0.3' High
Lat: 40.809255°
Long: 103.898992°

2012 Alum. Cap,
#28285,
Flush W/ Ground
Lat: 40.802050°
Long: 103.907725°

2010 Alum. Cap,
#17492, 0.2' High
Lat: 40.802042°
Long: 103.898872°



NAD 83 (TOP OF PRODUCTION)	NAD 83 (SURFACE LOCATION)
LATITUDE = 40°48'34.42" (40.809561)	LATITUDE = 40°48'30.31" (40.808419)
LONGITUDE = 103°54'39.77" (103.911047)	LONGITUDE = 103°54'37.90" (103.910528)
NAD 27 (TOP OF PRODUCTION)	NAD 27 (SURFACE LOCATION)
LATITUDE = 40°48'34.47" (40.809575)	LATITUDE = 40°48'30.36" (40.808433)
LONGITUDE = 103°54'37.96" (103.910544)	LONGITUDE = 103°54'36.09" (103.910025)

CERTIFICATE OF ACCURACY
THIS IS TO CERTIFY THAT THE ABOVE PLAT WAS PREPARED FROM FIELD NOTES OF ACTUAL SURVEYS MADE BY ME OR UNDER MY SUPERVISION AND THAT THE SAME ARE TRUE AND CORRECT TO THE BEST OF MY KNOWLEDGE AND BELIEF.

Greg Weimer
28285
REGISTERED LAND SURVEYOR
REGISTRATION NO. 28285
STATE OF COLORADO
JUL 15 2015

BASIS OF BEARINGS
BASIS OF BEARINGS IS A G.P.S. OBSERVATION
BASIS OF ELEVATION

SPOT ELEVATION LOCATED AT THE NORTHEAST CORNER OF SECTION 15, T9N, R58W, 6th P.M. TAKEN FROM THE GATEHOOK SPRING, QUADRANGLE, COLORADO, WELD COUNTY, 7.5 MINUTE QUAD (TOPOGRAPHIC MAP) PUBLISHED BY THE UNITED STATES DEPARTMENT OF THE INTERIOR, GEOLOGICAL SURVEY. SAID ELEVATION IS MARKED AS BEING 4679 FEET.

WHITING OIL & GAS CORP.

RAZOR FED #30K-1905 (SURFACE LOCATION)
NE 1/4 SW 1/4, SECTION 30, T10N, R58W, 6th P.M.
WELD COUNTY, COLORADO



SURVEYED BY: GREG WEIMER, C.J.	DATE: 10-21-15
DRAWN BY: H.K.W.	DATE DRAWN: 01-16-14
SCALE: 1" = 1000'	REVISED: 11-04-15 K.B.




UELS, LLC
Corporate Office * 85 South 200 East
Vernal, UT 84078 * (435) 789-1017

WELL LOCATION PLAT

LEGEND:

- ◻ = 90° SYMBOL
- = PROPOSED WELLHEAD.
- = TARGET BOTTOM HOLE.
- ◇ = TOP OF PRODUCTION.
- ▲ = SECTION CORNERS LOCATED. (NAD 83)

T10N, R58W, 6th P.M.

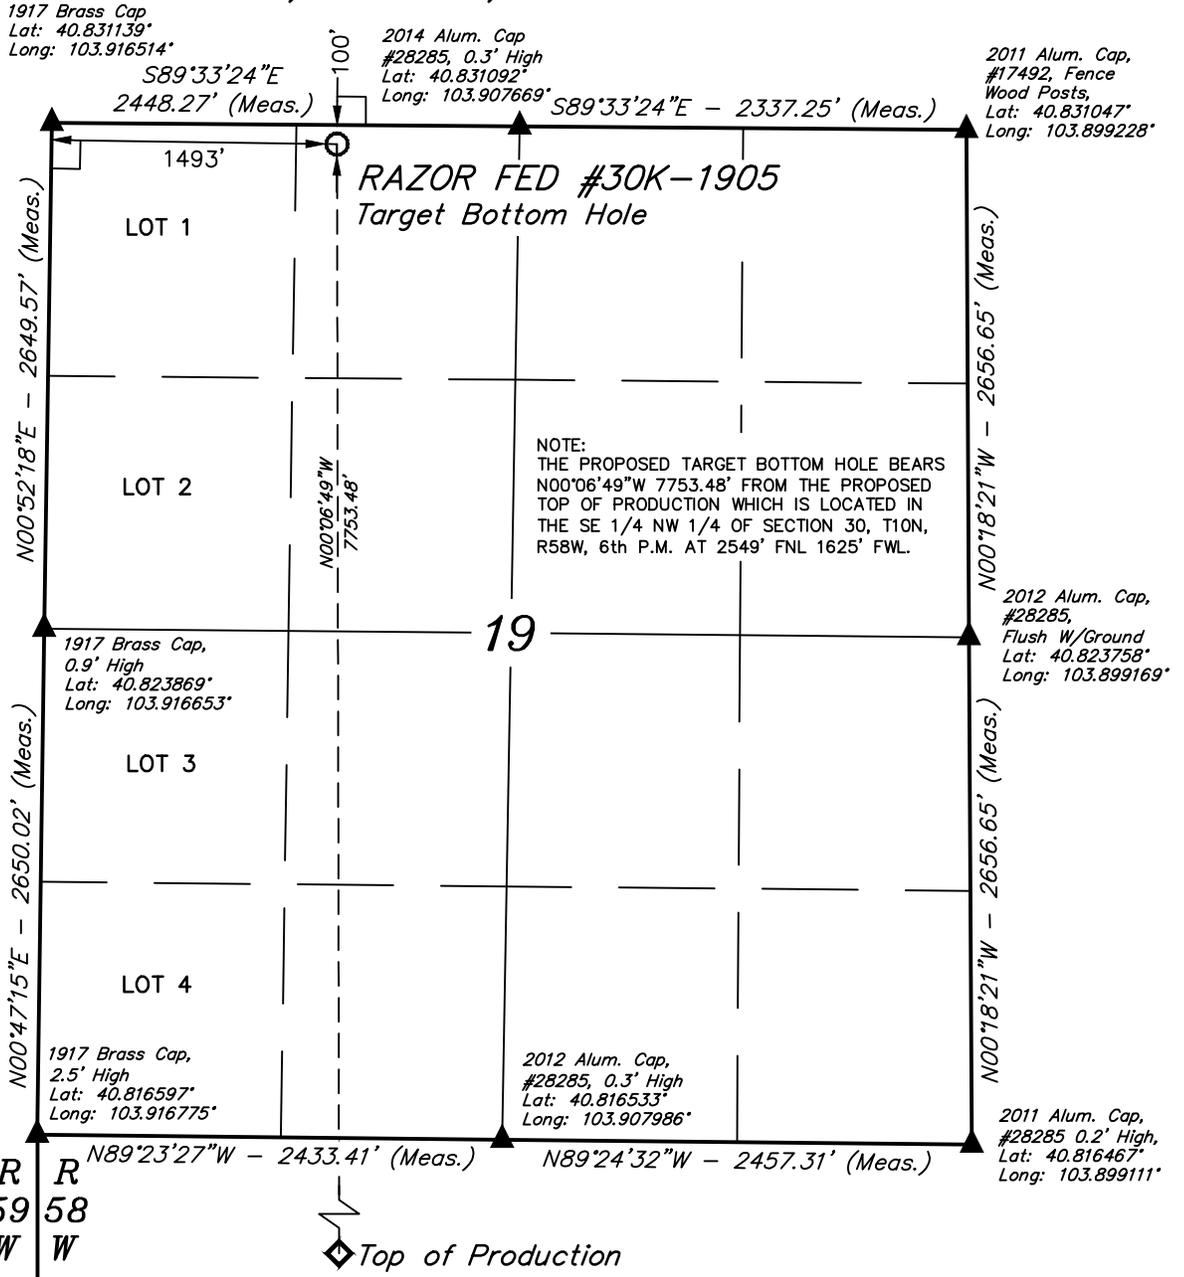

NAD 83 (TARGET BOTTOM HOLE)
LATITUDE = 40°49'51.01" (40.830836)
LONGITUDE = 103°54'40.06" (103.911128)
NAD 27 (TARGET BOTTOM HOLE)
LATITUDE = 40°49'51.06" (40.830850)
LONGITUDE = 103°54'38.24" (103.910622)



CERTIFICATE
THIS IS TO CERTIFY THAT THE ABOVE PLAT WAS PREPARED FROM FIELD NOTES OF ACTUAL SURVEYS MADE BY ME OR UNDER MY SUPERVISION AND THAT THE SAME ARE TRUE AND CORRECT TO THE BEST OF MY KNOWLEDGE AND BELIEF.



BASIS OF BEARINGS
BASIS OF BEARINGS IS A G.P.S. OBSERVATION

BASIS OF ELEVATION
SPOT ELEVATION LOCATED AT THE NORTHEAST CORNER OF SECTION 15, T9N, R58W, 6th P.M. TAKEN FROM THE GATEHOOK SPRING, QUADRANGLE, COLORADO, WELD COUNTY, 7.5 MINUTE QUAD (TOPOGRAPHIC MAP) PUBLISHED BY THE UNITED STATES DEPARTMENT OF THE INTERIOR, GEOLOGICAL SURVEY. SAID ELEVATION IS MARKED AS BEING 4679 FEET.

WHITING OIL & GAS CORP.

RAZOR FED #30K-1905 (TARGET BOTTOM HOLE)
NE 1/4 NW 1/4, SECTION 19, T10N, R58W, 6th P.M.
WELD COUNTY, COLORADO

SURVEYED BY: GREG WEIMER, C.J.	DATE: 10-21-15
DRAWN BY: H.K.W.	DATE DRAWN: 01-16-14
SCALE: 1" = 1000'	REVISED: 11-04-15 K.B.



UELS, LLC
Corporate Office * 85 South 200 East
Vernal, UT 84078 * (435) 789-1017



WELL LOCATION PLAT