




**DRILLING COMPANY, INC.**  
**WICHITA, KANSAS**

**Current Wellbore Diagram**

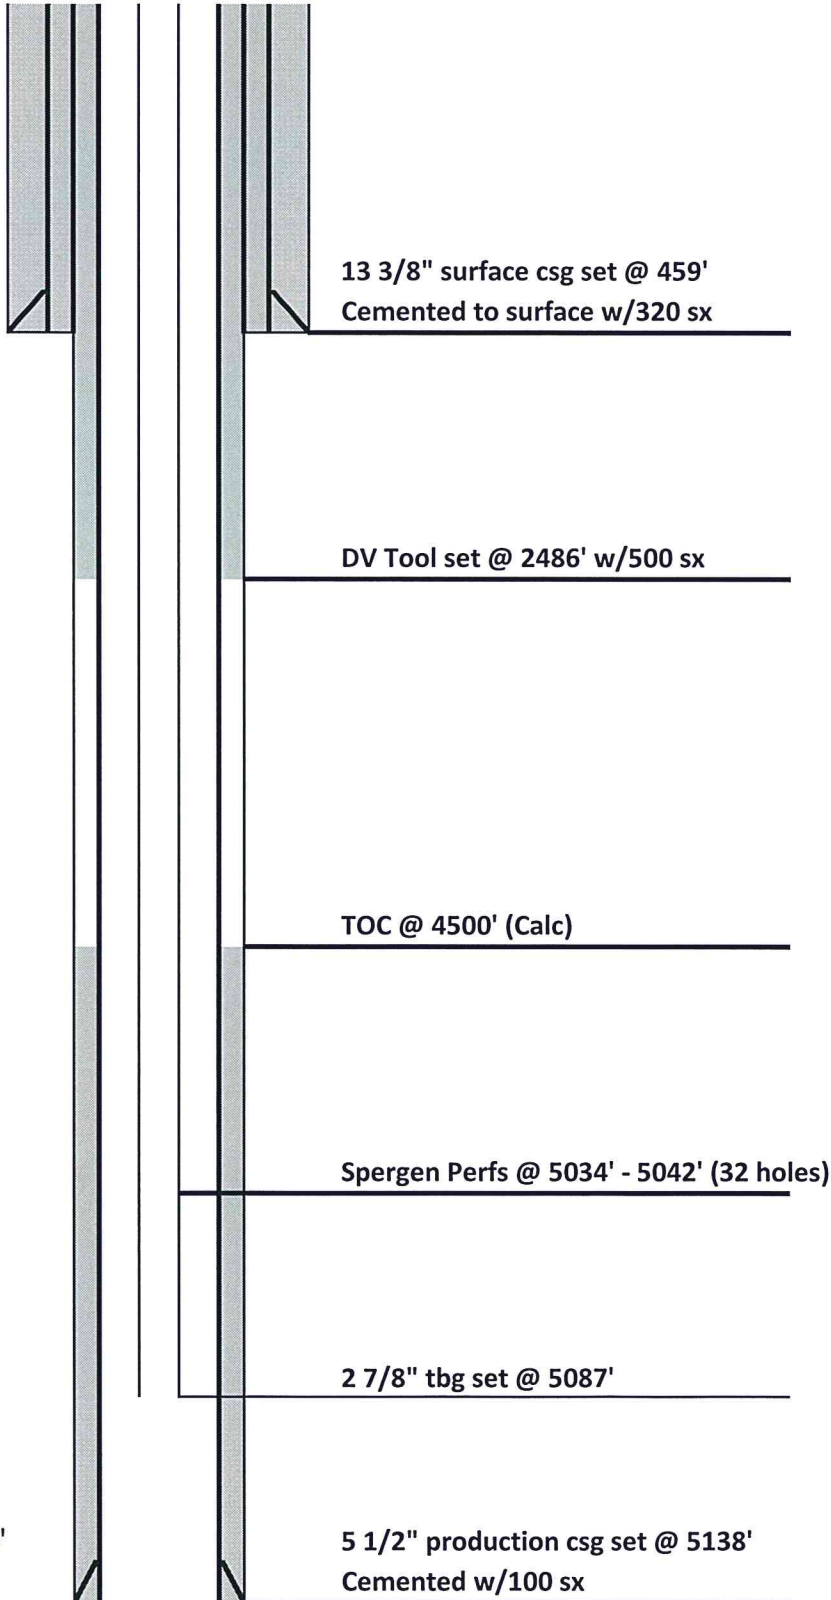

Date:	3/29/2016
Well Name:	UPLRC-George #2
Location:	720' FSL & 798' FWL SW/4 SW/4 1-17S-48W
County:	Kiowa
State:	Colorado
API:	05-061-06761
GL:	4141'
KB:	4149'
Spud Date:	3/22/2000

PBTD = 5114'  
RTD = 5140'