




DRILLING COMPANY, INC.
WICHITA, KANSAS

Proposed Wellbore Diagram

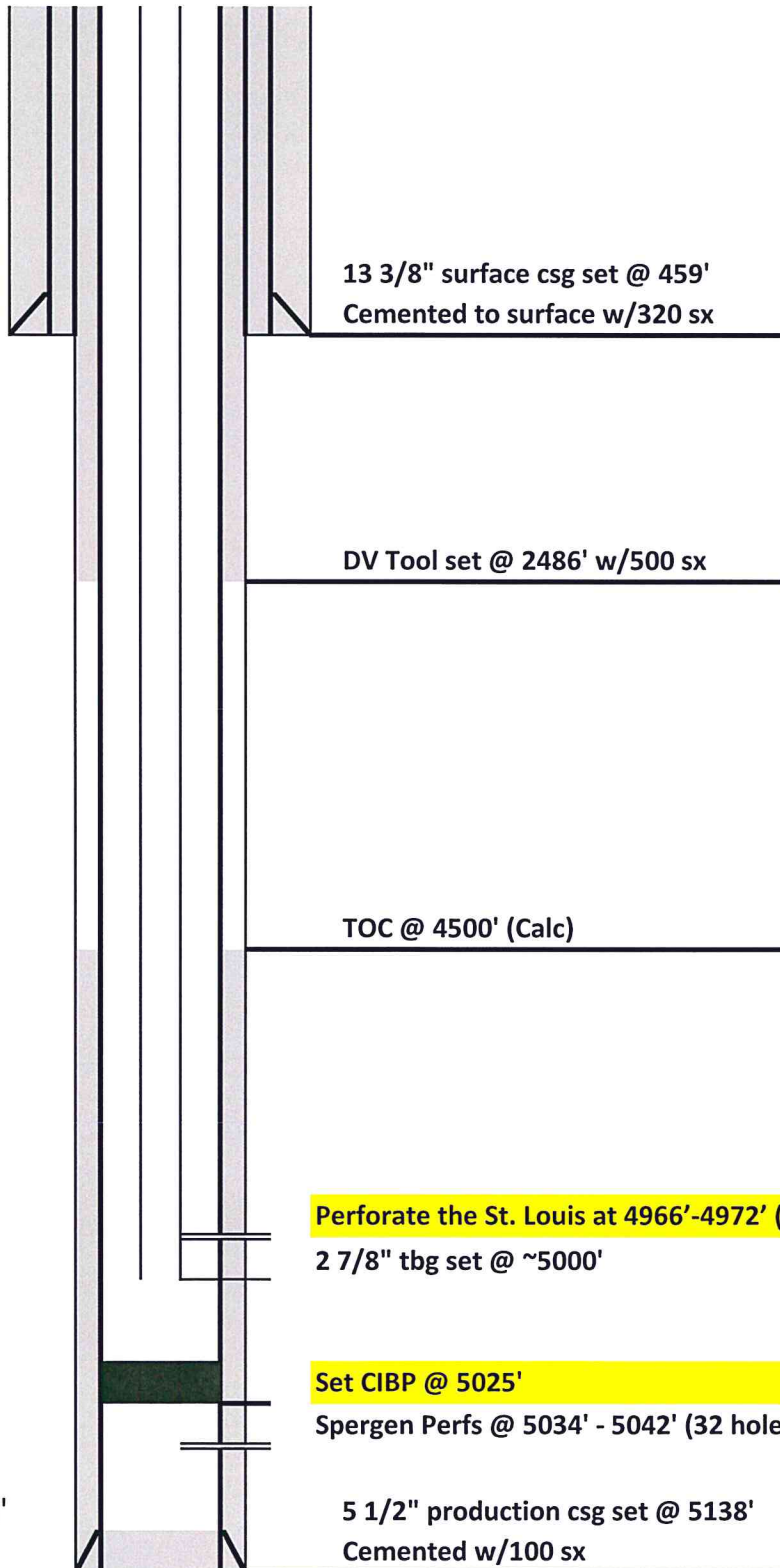

| | |
|------------|---------------------|
| Date: | 1/10/2017 |
| Well Name: | UPLRC-George #2 |
| Location: | 720' FSL & 798' FWL |
| | SW/4 SW/4 1-17S-48W |
| County: | Kiowa |
| State: | Colorado |
| API: | 05-061-06761 |
| GL: | 4141' |
| KB: | 4149' |
| Spud Date: | 3/22/2000 |