


Well Name: STATE 1-16-A

VERTICAL - ORIGINAL HOLE, 1/31/2017 2:36:06 PM

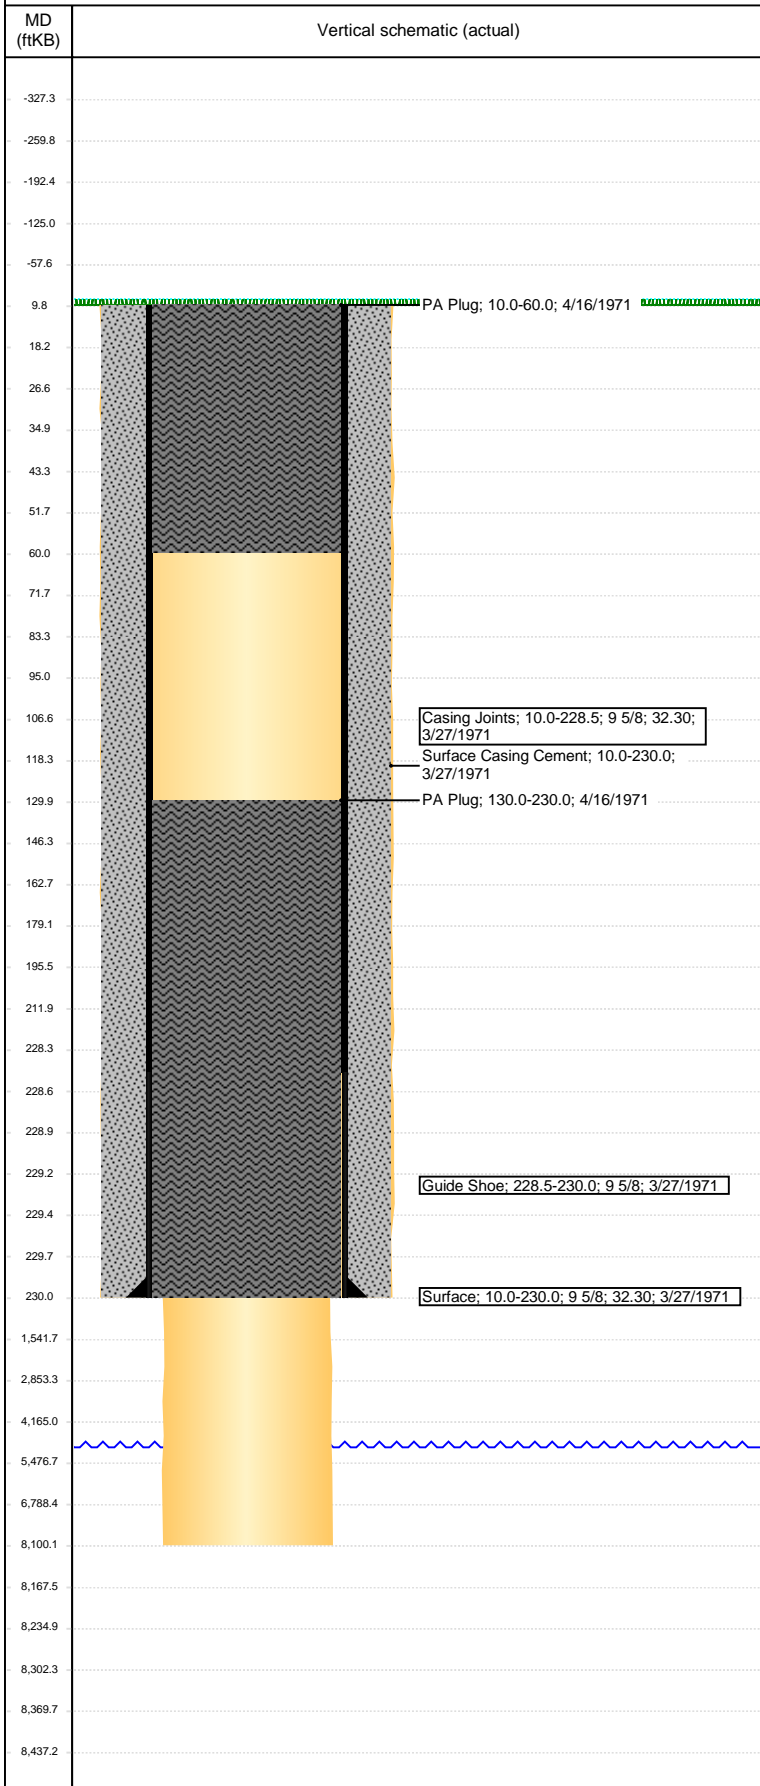

Well Header							
API 05-123-07275		Business Unit DJ BASIN		District 25		Well Config VERTICAL	
Original KB Elevation (ft) 4,955		KB - GL / MSL (ftKB) 10.00		Spud Date 3/27/1971		P & A Date 4/16/1971	
Comment NO RC NUMBER IN ORACLE AS OF 9/9/2015							
Directions To Well							
Congressional Location							
Quarter 3	Quarter 4	Section 16	Township 9	Twonshp N/S Dir N	Range 59	Range E/W Dir W	
Bottom Hole Location							
North-South Distance (ft)		From N or S Line		East-West Distance (ft)		From E or W Line	
Plug Back Total Depths							
Date	Depth (ftKB)	Method		Com			
Wellbore Sections							
Section Des		Size (in)		Act Top, MD (ftKB)		Act Btm, MD (ftKB)	
SURFACE		13 3/4		10		230	
PRODUCTION		7 7/8		230		8,100	
Zone Statuses							
Zone Name	Status Date	Status	Fluid Type	Job	Prod Method		
Casing Strings							
Surface, 230.0ftKB							
Casing Description Surface		Run Date 3/27/1971	OD (in) 9 5/8	Wt/Len (l... 32.30	Grade	Top, MD (ft... 10.0	
						MD (ftKB) 230.0	
Cement							
Description Surface Casing Cement				Top Depth (ftKB) 10.0		Bottom Depth (ftKB) 230.0	
Description PA Plug				Top Depth (ftKB) 130.0		Bottom Depth (ftKB) 230.0	
Description PA Plug				Top Depth (ftKB) 10.0		Bottom Depth (ftKB) 60.0	
Tubing Strings							
Tubing Description		Run Date	String...	ID (in)	Wt (lb/ft)	Grade	Len (ft)
							Set De...
Other In Hole							
Run Date		Des			OD (in)	Top (ftKB)	Btm (ftKB)
Logs							
Date		Type			Top, MD (ftKB)		Btm, MD (ftKB)
4/14/1971		DIFL/DENS/GR/GRD/CAL			10.0		8,100.0
4/14/1971		INDUCTION			10.0		8,100.0