




WELLBORE DIAGRAM

CURRENT WBD

528' FNL & 1974' FEL

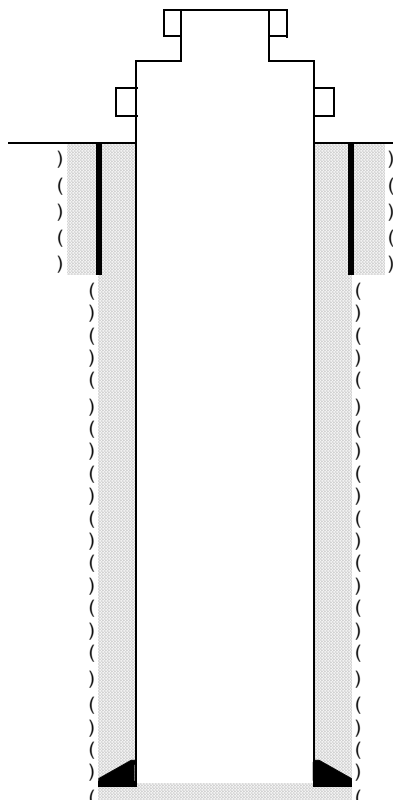

TVD = 1070' PBTVD = 1011'
MD = 1070' PBMD = 1011'

KB ' 4866.5'

GL ' 4850.3'

Spud Date: 9/4/2014
Date TD Reached 9/5/2014
Completion Date: N/A

Conductor Casing

(24" Hole Size) 16" 42# csg set at 80'
w/ 61 sx cmt.

Surface Casing

(13.5" Hole Size) 9-5/8" 36# J-55 LTC surface csg @ 1070' (25 jts)
cmt'd w/ 430 sx (115 bbls) 14.2 ppg swiftcem cement,
20 BBL returns to surface

Production casing

N/A

Tubing

N/A

Operator: Great Western Operating Co. LLC
Well Name: Schmunk EF 31-367HN
Lease Number:
Location: NWNE 31-T7N-R65W
Field: Wattenberg - #90750
County, State: Weld, CO
API Number: 05-123-38931
Diagram Date: 1/26/2017
Lat/Long: 40.537464/-104.703808