




# **WELLBORE DIAGRAM**

CURRENT WBD

530' FNL & 2034' FEL

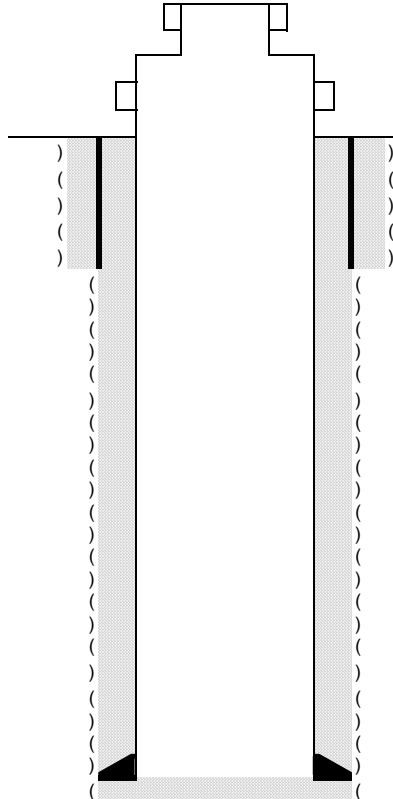

TVD = 1070' PBTVD = 1010'  
MD = 1070' PBMD = 1010'

Operator: Great Western Operating Co. LLC  
Well Name: Schmunk EF 31-369HN  
Lease Number:   
Location: NWNE 31-T7N-R65W  
Field: Wattenberg - #90750  
County, State: Weld, CO  
API Number: 05-123-38934  
Diagram Date: 1/27/2017  
Lat/Long: 40.537467/-104.704025

KB ' 4866.5'

GL ' 4850.3'

Spud Date: 9/6/2014  
Date TD Reached: 9/6/2014  
Completion Date: N/A

**Conductor Casing**  
(24" Hole Size) 16" 42# csg set at 80'  
w/ 61 sx cmt.

**Surface Casing**  
(13.5" Hole Size) 9-5/8" 36# J-55 LTC surface csg @ 1070' (25 jts)  
cmt'd w/ 430 sx (115 bbls) 14.2 ppg swiftcem cement,  
20 BBL returns to surface

**Production casing**  
N/A

**Tubing**  
N/A