Wellbore Schematic Input Report

Well Name: GREENHEAD 18-11

DEVIATED - ORIGINAL HOLE, 2/14/2017 3:41:41 PM

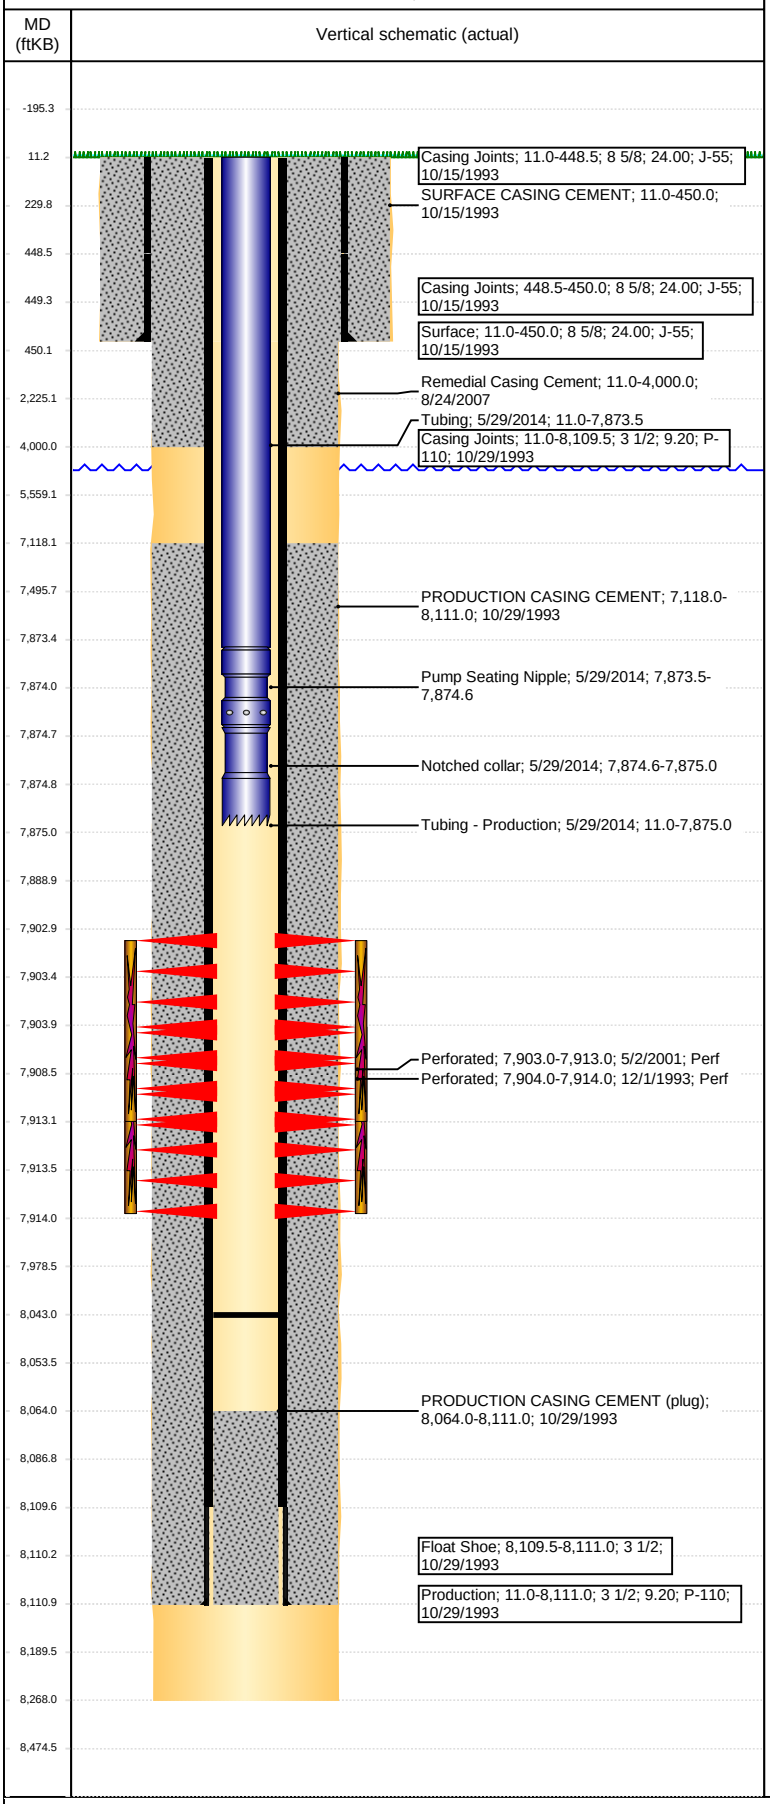

Report Printed: 2/14/2017