

STATE OF
COLORADO

Andrews - DNR, Doug <doug.andrews@state.co.us>

Will Trust 6-62-3_2 NWNW pad (Document Number: 401187514)

3 messages

Tracey Fallang <tfallang@billbarrettcorp.com>

Mon, Feb 27, 2017 at 3:16 PM

To: "john.noto@state.co.us" <john.noto@state.co.us>, "doug.andrews@state.co.us" <doug.andrews@state.co.us>

Cc: Matt Barber <mbarber@billbarrettcorp.com>

Per your conversation with Matt, please find the following details:

- 1) The surface owner has agreed to the placement of the Will Trust 6-62-3_2 NWNW pad as it reduces surface disturbance on Will Trust lands.
- 2) With adjustments made on well density, BBC was able to plan one additional pad in the NW/4 versus an expansion of loc ID 422197 and one new pad (loc ID 446150), reducing overall disturbance on Will Trust lands (again, who approved this reduction), by approximately 5.3 acres. Centralizing the NWNW pad allows BBC to effectively reach bottom hole targets and reduce disturbances.
- 3) The existing Dutch Lake 3-3H facility would not have accommodated additional facility equipment and as such, would have required a complete deconstruct/construct.
- 4) The approved Will Trust 6-62-3_2 NWSW (Location ID 446321) centralized production facility, located in the middle of section, will serve operations and production more efficiently.

Let me know if you have further questions.

Tracey Fallang, Regulatory Manager

BILL BARRETT CORPORATION

1099 18th Street | Suite 2300

Denver, CO 80202


O 303.312.8134 | C 303.596.4818 | F 303.291.0420

tfallang@billbarrettcorp.com

www.billbarrettcorp.com



Bill Barrett Corporation

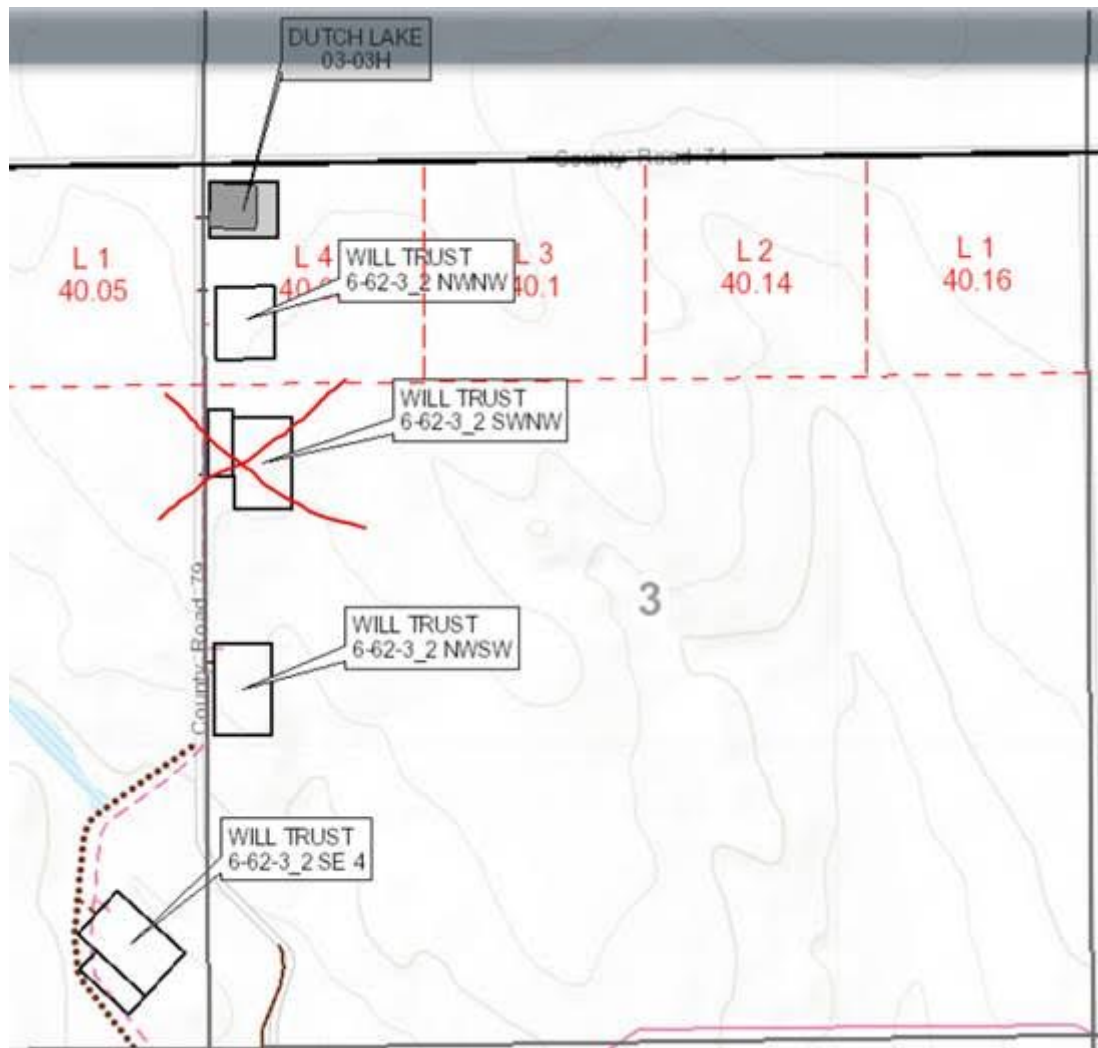

Tue, Feb 28, 2017 at 10:35 AM

Cc: Matt Barber <mbarber@billbarrettcorp.com>

Matt,

I have some additional follow-up comments on this Form 2A, now that I have completed my review.

1) Per Tracey's response and what you have indicated on this Form 2A, these four wells will produce to the Will Trust 6-62-3_2 NWSW location (Location ID #446321). However, when that location was approved in June 2016, it was for only six wells and six separators and that production would be on the Will Trust 6-62-3_2 SWNW pad. Per what Tracey has provided, the SWNW location will not be built. My question is when will the NWSW location be amended to add production facilities for the wells in this section?

2) In the Cultural Setback Distance section you have indicated the nearest Above Ground Utility is 325 feet from a well. At this distance, an Above Ground Utility should be on your Location Drawing but it is not shown. During my review, it appears the nearest Above Ground Utility is to the north along Weld County Road 74. Please confirm the distance to the nearest Above Ground Utility to a well and if necessary revise the Location Drawing.

3) As was done with the recent Form 2A for the Hawkins 5-61-20_19 SW21 location, please provide a revised Waste Management Plan that indicates at least four composite samples per acre will be collected from the drill cuttings.

Please respond to this correspondence by March 28, 2017. If you have any questions, please contact me. Thank you.

Doug Andrews

Oil & Gas Location Assessment Specialist - Northeast Colorado



1120 Lincoln St., Suite 801
Denver, CO 80203
doug.andrews@state.co.us
303-894-2100 Ext. 5180

[Quoted text hidden]

Matt Barber <mbarber@billbarrettcorp.com>
To: "Andrews - DNR, Doug" <doug.andrews@state.co.us>
Cc: Tracey Fallang <tfallang@billbarrettcorp.com>

Tue, Feb 28, 2017 at 11:46 AM

Doug,

I have added my 2A comments in blue text below.

Please let me know if you need anything else.

Thank you,

Matt

From: Andrews - DNR, Doug [mailto:doug.andrews@state.co.us]
Sent: Tuesday, February 28, 2017 10:36 AM
To: Tracey Fallang <tfallang@billbarrettcorp.com>
Cc: Matt Barber <mbarber@billbarrettcorp.com>
Subject: Re: Will Trust 6-62-3_2 NWNW pad (Document Number: 401187514)

Matt,

I have some additional follow-up comments on this Form 2A, now that I have completed my review.

1) Per Tracey's response and what you have indicated on this Form 2A, these four wells will produce to the Will Trust 6-62-3_2 NWSW location (Location ID #446321). However, when that location was approved in June 2016, it was for only six wells and six separators and that production would be on the Will Trust 6-62-3_2 SWNW pad. Per what Tracey has provided, the SWNW location will not be built. My question is when will the NWSW location be amended to add production facilities for the wells in this section? [As you noted that I noted, the amendment is pending for the NWSW additional production facilities. The location is not being expanded so a sundry will be submitted. We have one surveyor and a lot of plats in the queue for revisions so they will be submitted upon receipt of the revised plats.](#)

2) In the Cultural Setback Distance section you have indicated the nearest Above Ground Utility is 325 feet from a well. At this distance, an Above Ground Utility should be on your Location Drawing but it is not shown. During my review, it appears the nearest Above Ground Utility is to the north along Weld County Road 74. Please confirm the distance to the nearest Above Ground Utility to a well and if necessary revise the Location Drawing. [The correct distance to the nearest is 925'. This was a typo. My apologies.](#)

3) As was done with the recent Form 2A for the Hawkins 5-61-20_19 SW21 location, please provide a revised Waste Management Plan that indicates at least four composite samples per acre will be collected from the drill cuttings.

[New waste management plan attached](#)

[Quoted text hidden]

[Quoted text hidden]



Benificial Use Plan - Drill Cuttings - Updated 2-24-2017.pdf
23K