
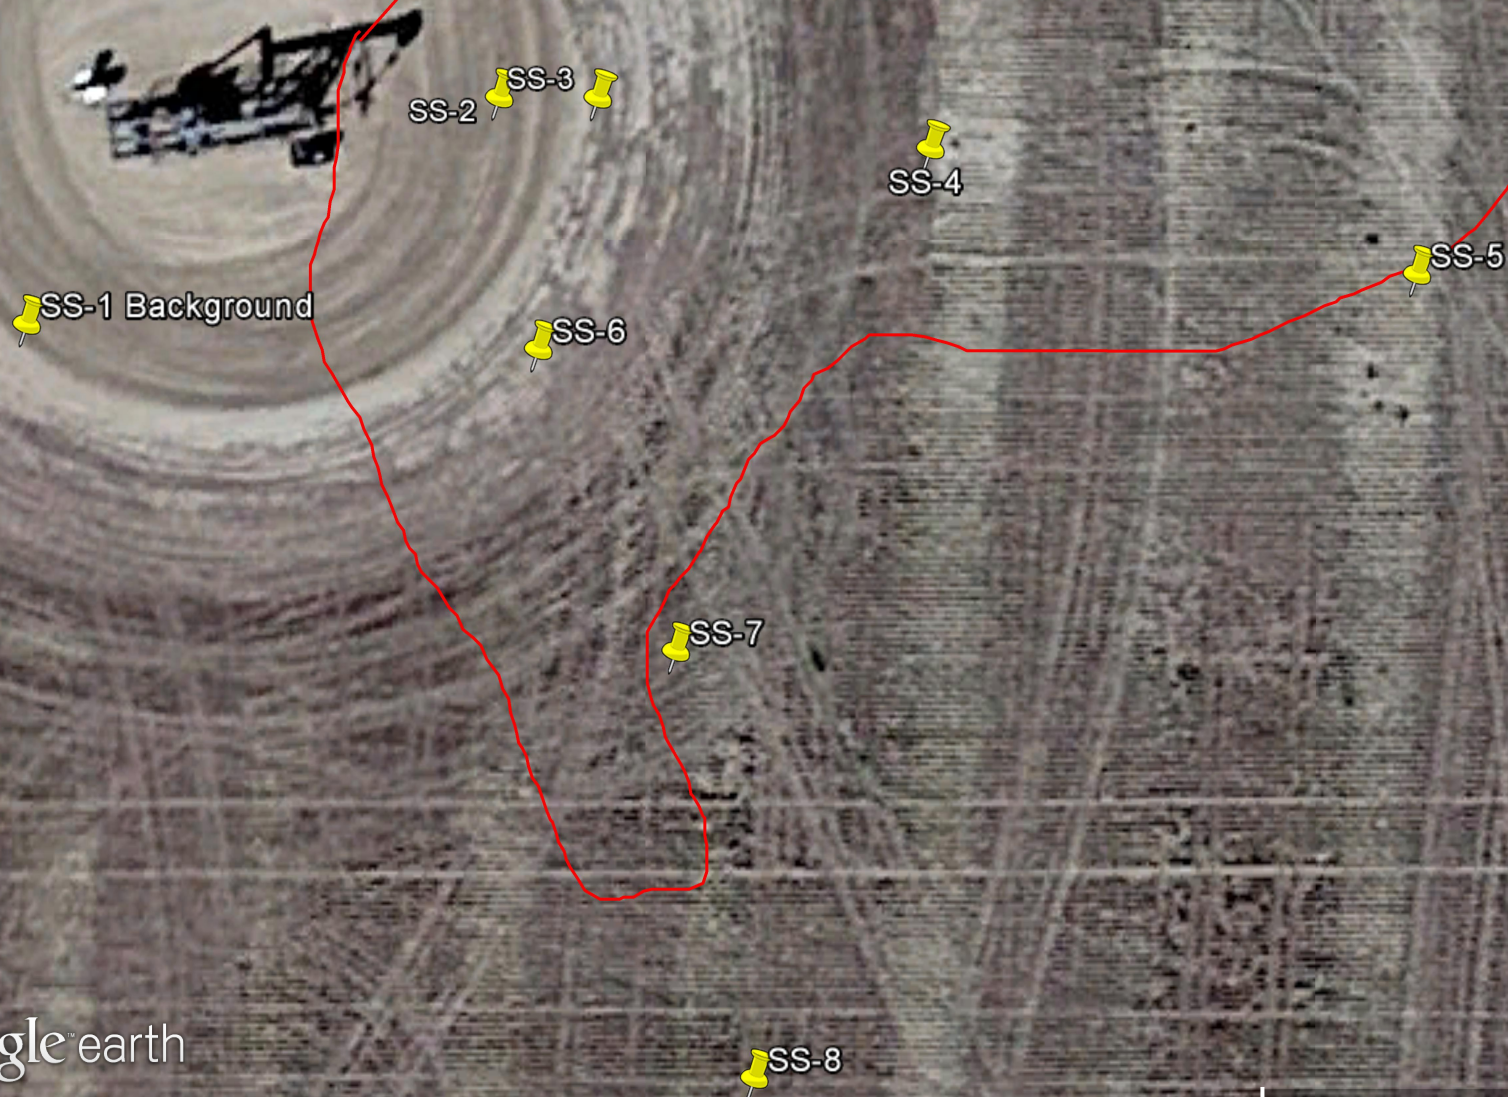


Spill 449146 Soil Sample Locations

Legend

 Spill area



Google earth

© 2016 Google



100 ft