

State of Colorado Oil and Gas Conservation Commission

1120 Lincoln Street, Suite 801, Denver, Colorado 80203 (303) 894-2100 Fax: (303) 894-2109



FOR OGCC USE ONLY

RECEIVED

AUG 27 03

00000



01200775

Complete the Attachment Checklist

Oper OGCC

|                            |  |
|----------------------------|--|
| Survey Plat                |  |
| Directional Survey         |  |
| Surface Equipment Diagram  |  |
| Technical Information Form |  |
| Other                      |  |

Submit original plus one copy. This form is to be used for general, technical and environmental sundry information. For proposed or completed operations, describe in full on Technical Information Page (Page 2 of this form). Identify well or other facility by API Number or by OGCC Facility ID.

1. OGCC Operator Number: 69175  
 2. Name of Operator: Petroleum Development Corp.  
 3. Address: 103 East Main Street P.O. Box 26  
 City: Bridgeport State: WV Zip: 26330  
 4. Contact Name and Telephone  
Gary Fridley  
 No: 1-800-624-3821  
 Fax: 1-304-842-0913  
 5. API Number: 05-123-20927 6. OGCC Facility ID Number: \_\_\_\_\_  
 7. Facility Name: State Operator's Facility Number: #12-4  
 8. Location (QtrQtr, Sec, Twp, Rng, Meridian): SWNW Sec.4 5N 63W  
 9. County: Weld 10. Field Name: Wattenberg  
 11. Federal, Indian or State Lease Number: \_\_\_\_\_

12. General Notice

Change well name and number from: \_\_\_\_\_ to: \_\_\_\_\_ Effective Date: \_\_\_\_\_

Change of location from (QtrQtr, Sec, Twp, Range, Meridian): SWNW Sec.4 5N 63W  
 Footage from Ext. Sec. Lines: 1940' FNL X 847' FWL 652 FWL  
 Change of location to (QtrQtr, Sec, Twp, Range, Meridian): SWNW Sec.4 5N 63W  
**ATTACH NEW SURVEY** Footage from Ext. Sec. Lines: 1806' FNL X 614' FWL

Abandoned Location: Is site ready for inspection?  Yes  No Date Ready for Inspection: \_\_\_\_\_  
 Was location ever built?  Yes  No

Date Well first shut in or temporarily abandoned \_\_\_\_\_  Notice of continued shut-in status.  
 Has production equipment been removed from site?  Yes  No  
 MIT required if shut in longer than two years. Date of last MIT: \_\_\_\_\_

Request for Confidential Status (6 months from date of well completion).

Final reclamation will commence approximately on \_\_\_\_\_

Final reclamation is completed and site is ready for inspection. *Attach technical page describing final reclamation procedures per Rule 1004.*

Change of Operator (prior to drilling): Effective Date: \_\_\_\_\_ Plugging bond:  Blanket  Individual

Spud Date \_\_\_\_\_

13. Technical Engineering/Environmental Notice

Notice of Intent Approximate Start Date: \_\_\_\_\_  Report of Work Done Date Work Completed: \_\_\_\_\_

*Details of work must be described in full on Technical Information Page (Page 2 must be submitted).*

|   |  |  |
|---|--|--|
| <input type="checkbox"/> Commingle Zones<br><input type="checkbox"/> Intent to Recomplete (submit Form 2)<br><input type="checkbox"/> Change Drilling Plans<br><input type="checkbox"/> Reservoir Stimulation<br><input type="checkbox"/> Perforating/Perfs Added<br>Gross Interval Changed?<br><input type="checkbox"/> Y <input type="checkbox"/> N | <input type="checkbox"/> Request to Vent or Flare<br><input type="checkbox"/> Repair Well<br><input type="checkbox"/> Convert Well to Injection (in an Approved Secondary Project)<br><input type="checkbox"/> Additional Source Leases for Water Disposal Well<br><input type="checkbox"/> Other: _____ | <input type="checkbox"/> E&P Waste Disposal<br><input type="checkbox"/> Beneficial Reuse of E&P Waste<br><input type="checkbox"/> New Pit<br><input type="checkbox"/> Landfarming<br><input type="checkbox"/> Status Update/Change of Remediation Plans for Spills and Releases<br><input type="checkbox"/> Variance |
|---|--|--|


I hereby certify that the statements made in this form are, to the best of my knowledge, true, correct, and complete.

Print Name: Gary W. Fridley  
 Signed: Gary W. Fridley Title: Landman Date: August 22, 2003  
 OGCC Approved: [Signature] Date: 10/28/03

CONDITIONS OF APPROVAL, IF ANY:

# WELL LOCATION CERTIFICATE

SECTION 4, TOWNSHIP 5 NORTH, RANGE 63 WEST

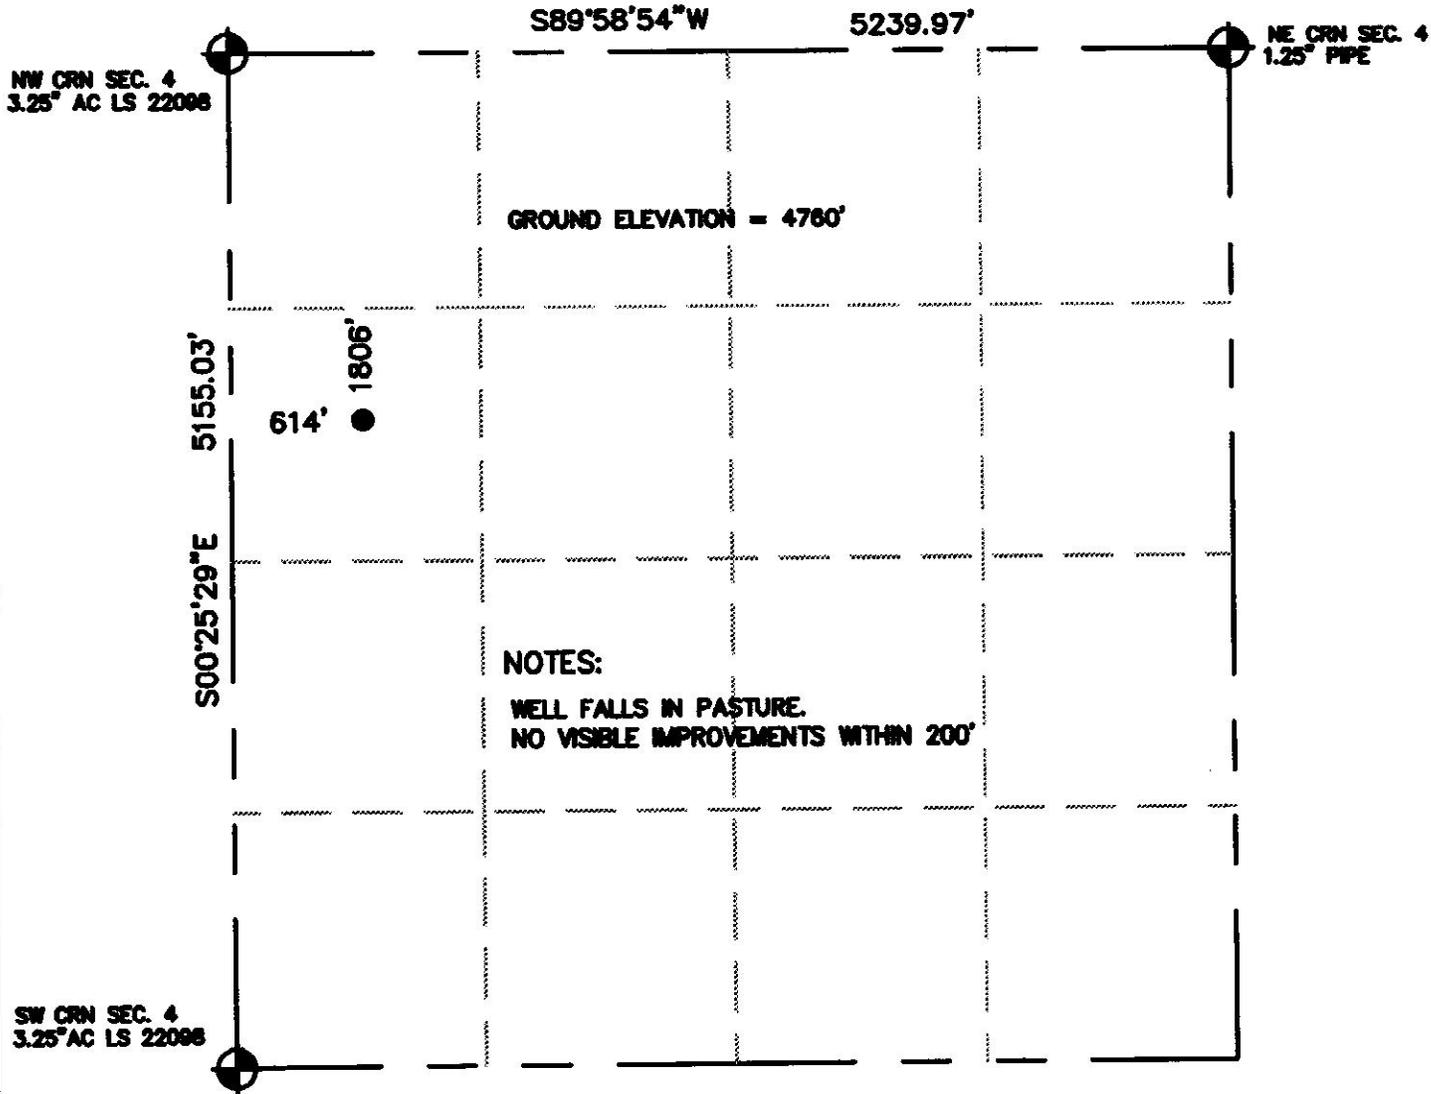


**NOTES:**

WELL FALLS IN PASTURE.  
NO VISIBLE IMPROVEMENTS WITHIN 200'

I HEREBY CERTIFY TO PETROLEUM DEVELOPMENT CORPORATION THAT THIS WELL LOCATION CERTIFICATE FOR THE WELL STATE WELLS 12-4 IS LOCATED 1806' FNL & 614' FWL, SEC. 4, T5N, R63W.



1" = 1000'

ELEVATION FROM USGS MAP, 1929 DATUM

THOMAS G. CARLSON, PLS 24657  
HORSESHOE SURVEYING, LLC

THIS IS NOT A MONUMENTED BOUNDARY SURVEY, IT IS ONLY INTENDED TO DEPICT THE WELL LOCATION TO SECTION LINES.

|  |         |                                      |  |
|--|---------|--------------------------------------|--|
| PREPARED BY: HORSESHOE SURVEYING, LLC<br>4745 E. 129TH CT<br>THORNTON, CO 80241<br>(720)937-6195 |         | WELL NAME:<br>STATE WELLS 12-4       |  |
| DATE: 8-19-03  |         | LOCATION:<br>SWNW, SEC. 4, T5N, R63W |  |
| BY: TGC  | JOB NO. | SHEET NO.<br>1 OF 1                  |  |