

NOBLE ENERGY INC.
Wells Ranch USX BB 05-25
NWSW 5-5N-63W
1302 FSL & 1232 FWL
WELD COUNTY, CO
Wattenberg
CURRENT WELLBORE SCHEMATIC
with PROPOSED P&A

API: 05-123-24998
COGCC #

GL Elev: 4695'
KB Elev: 4707'

Spud Date: 4/29/2007

Surface Casing :
8-5/8" 24# J-55 @ 487'
Cement: 256 sx
TOC: Surface


WW	N/A	
SC	487	687
FH	379	579

No Sussex completions within 1 mile

TOC @ 1940'

Nio Top 6528'

Production Casing :
4-1/2" 11.60# M-80 @ 6991'
Cement: 900 sx
TD Date: 5/3/2007

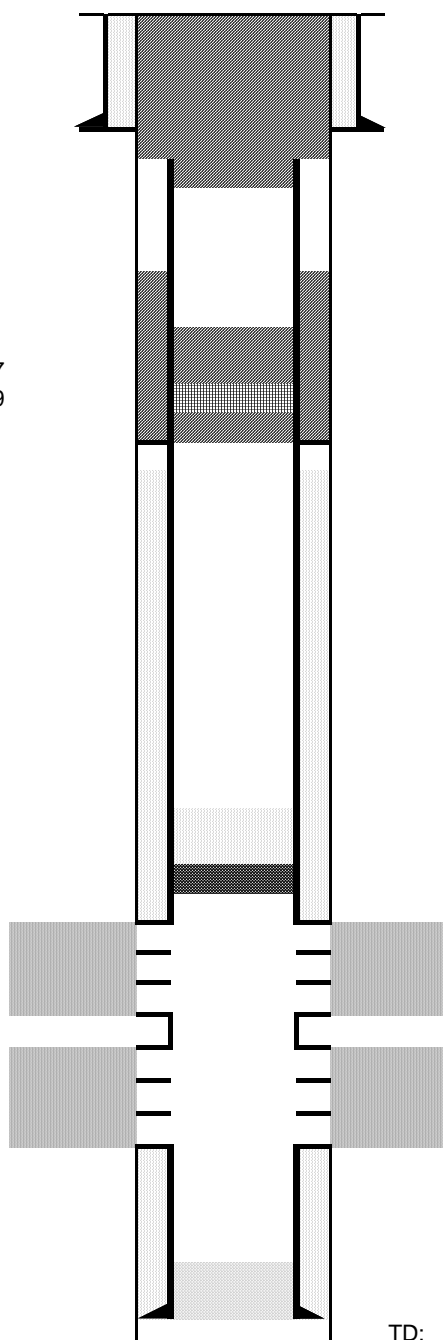

Cut surface casing off 6'-8' below surface.

Cut production casing at 687'
Cmt to surface from 50' in csg stub (737')
with 250 sx cmt

Pump 210 sx plug through/on CICR
Cmt Coverage inside PC: 1611'
Cmt Coverage outside PC: 1340'
Set CICR at 1740'
Shoot sqz perms at 1840'

Set CIBP at 6480' with 2 sx cement
New TOC: 6454'

Niobrara Perforations 6530'-
6540' & 6634'-6650'

Codell Perforations 6780'-6790'

TD: 7005'