


API:	05-123-17838	ELEVATION:	4925	QTR-QTR:	SESE
WELL NAME:	UPRC 5-16 O	GROUND LEVEL:	4914	SECTION:	5
COUNTY:	WELD	MD:	8034	TWNSHIP:	2N
LATITUDE:	40.161138	PBMD:	7927	RANGE:	66W
LONGITUDE:	-104.79474	CREATED BY:	D. HASZ		
		DATE:	3/22/2017		

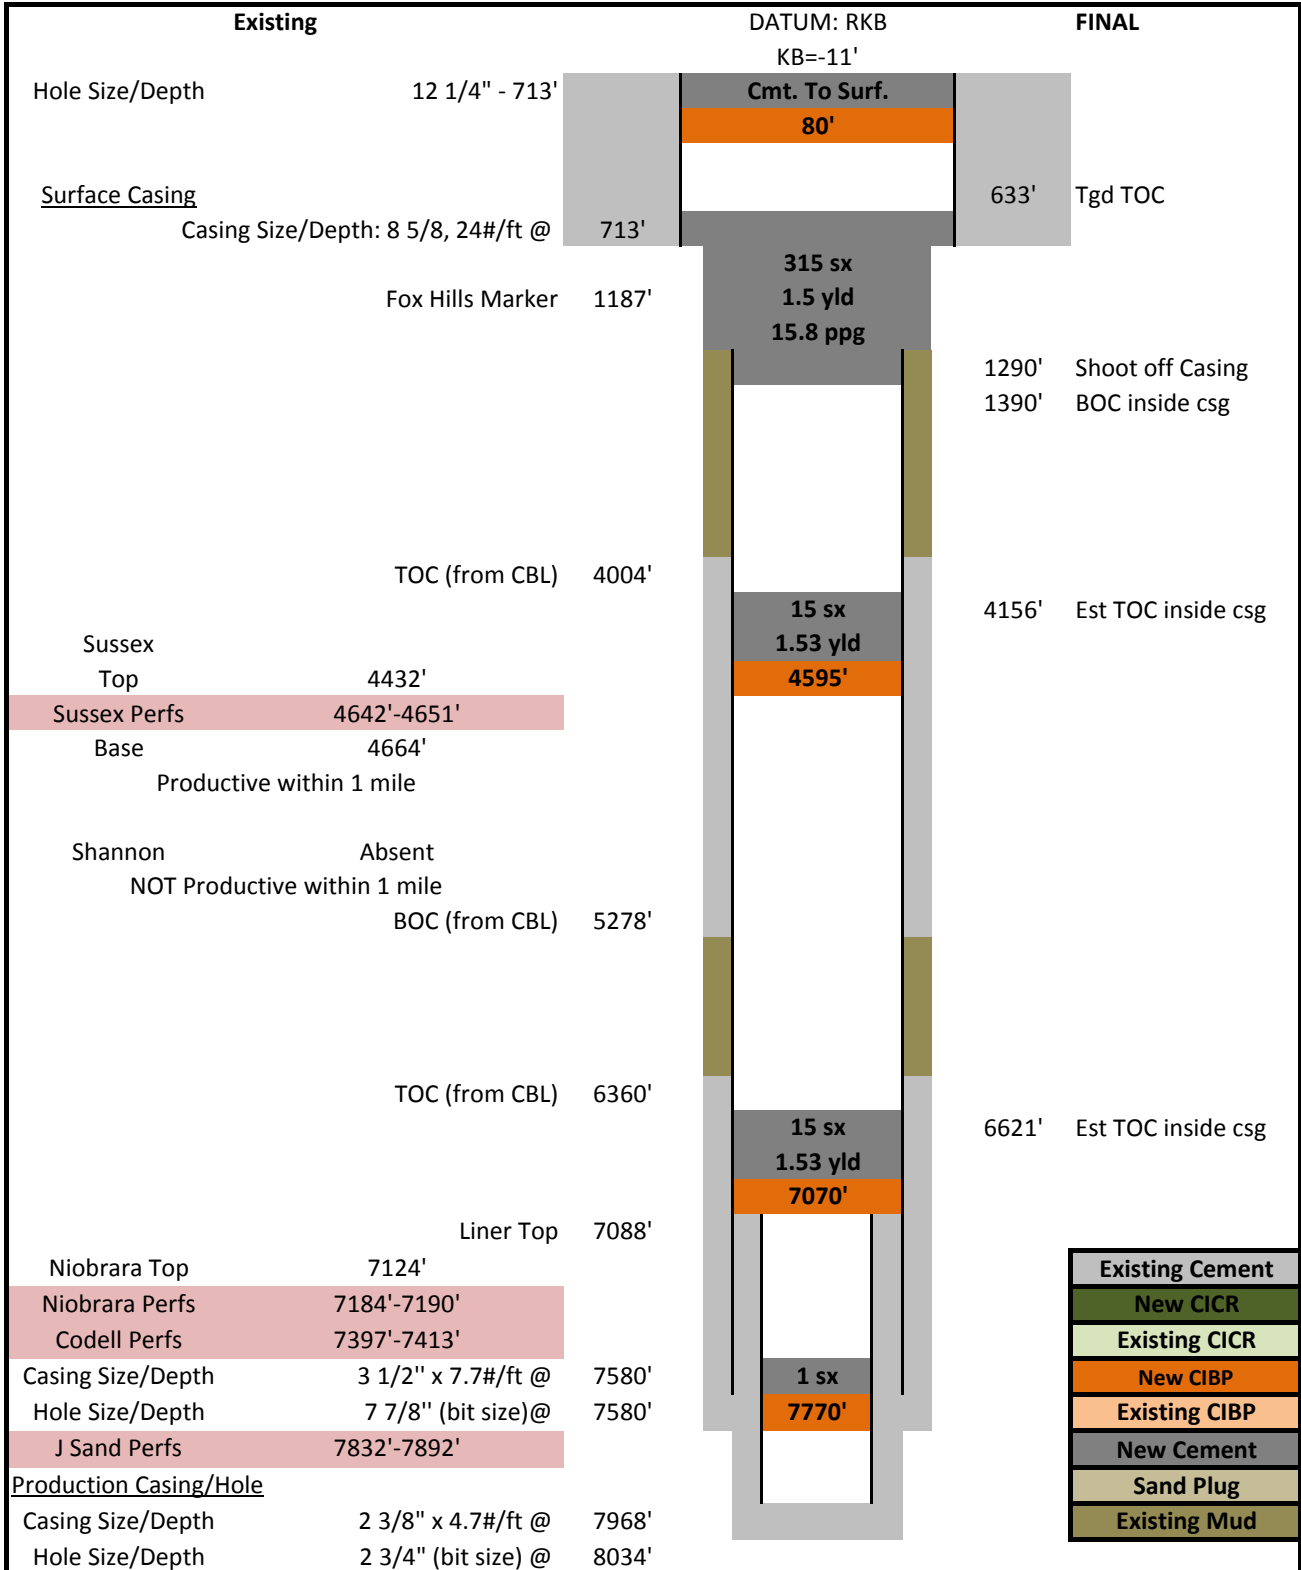

OW RPT

OW CMT

WELLBOR CMT

CMT

WL

80

80

633

500

633 pio

315 sx

315 sx

1290

1290

1390

1390

4156

4156

15 sx

15 sx

4595

4595

4595

we set

6621

6621

15 sx

15 SX

7070

7070

7070

7070

7770

7770

GENERAL INPUTS	
Name	David Hasz
Cell Phone Number	970-371-8820
Date	3/22/2017
WELL INPUTS	
Well Name	
API #	05-123-17838
WINS #	23923
Gyro Date:	Feb-13
Surface Hole Size (in)	12.25
Prod Hole Size (in)	7.88
OH Excess Factor	60
Surface Casing (size/wt)	8-5/8", 24#
Surface Casing Shoe (ft)	713
Prod csg (size/wt)	3.5", 7.7#
Tubing OD (in)	2.060
Tubing Set Depth (ft)	6656
Collar Above JSand CIBP (ft)	7780
Collar Below JSand CIBP (ft)	7780
J Sand CIBP (ft)	7780
Collar Above Nio CIBP (ft)	7046
Collar Below Nio CIBP (ft)	7088
Niobrara CIBP / BOC (ft)	7080
Niobrara TOC (ft)	6680
Niobrara Cement Vol (sx)	15
SUSX/SH BOC (ft)	4590
SUSX/SH TOC (ft)	4190
SUSX/SH Cement Vol (sx)	15
Bradenhead Issues? (Y/N)	N
Stub Plug BOC (ft)	1390
Cut Casing Depth (ft)	1290
Stub Plug TOC Form6 (ft)	663
Stub Plug TOC Calc (ft)	510
Stub Plug Cement Vol (sx)	270
GEOLOGY INPUTS	
FHM (ft)	1187
Sussex Top (ft)	4432
Sussex Base (ft)	4664
Shannon Base (ft)	Absent
Niobrara Top (ft)	7124
QUESTIONS?	
Who Drilled Well?	Snyder Oil Corp
Straight or Deviated Hole?	Straight
Age of well (yr)	23
Any squeeze holes? (Y/N)	N
Details of Integrity Issues?	NONE
SUSX Productive? (Y/N)	Y
SH Productive? (Y/N)	N
Gyro Found (Y/N)	Y
CBL Found (Y/N)	Y
Packer Downhole? (Y/N)	N
Packer Depth (ft)	7500

O.D. Nom.	Wt
8.625	24
3.5	7.7

Recommended
13.4

Recommended
13.4

Flush (bbl)
102

Recommended
270

*No end punctuation

*If No Integrity Issues, Put "NONE".