


Wellbore Schematic Input Report

Well Name: COUNTRY I29-04

VERTICAL - ORIGINAL HOLE, 3/28/2017 12:42:38 PM

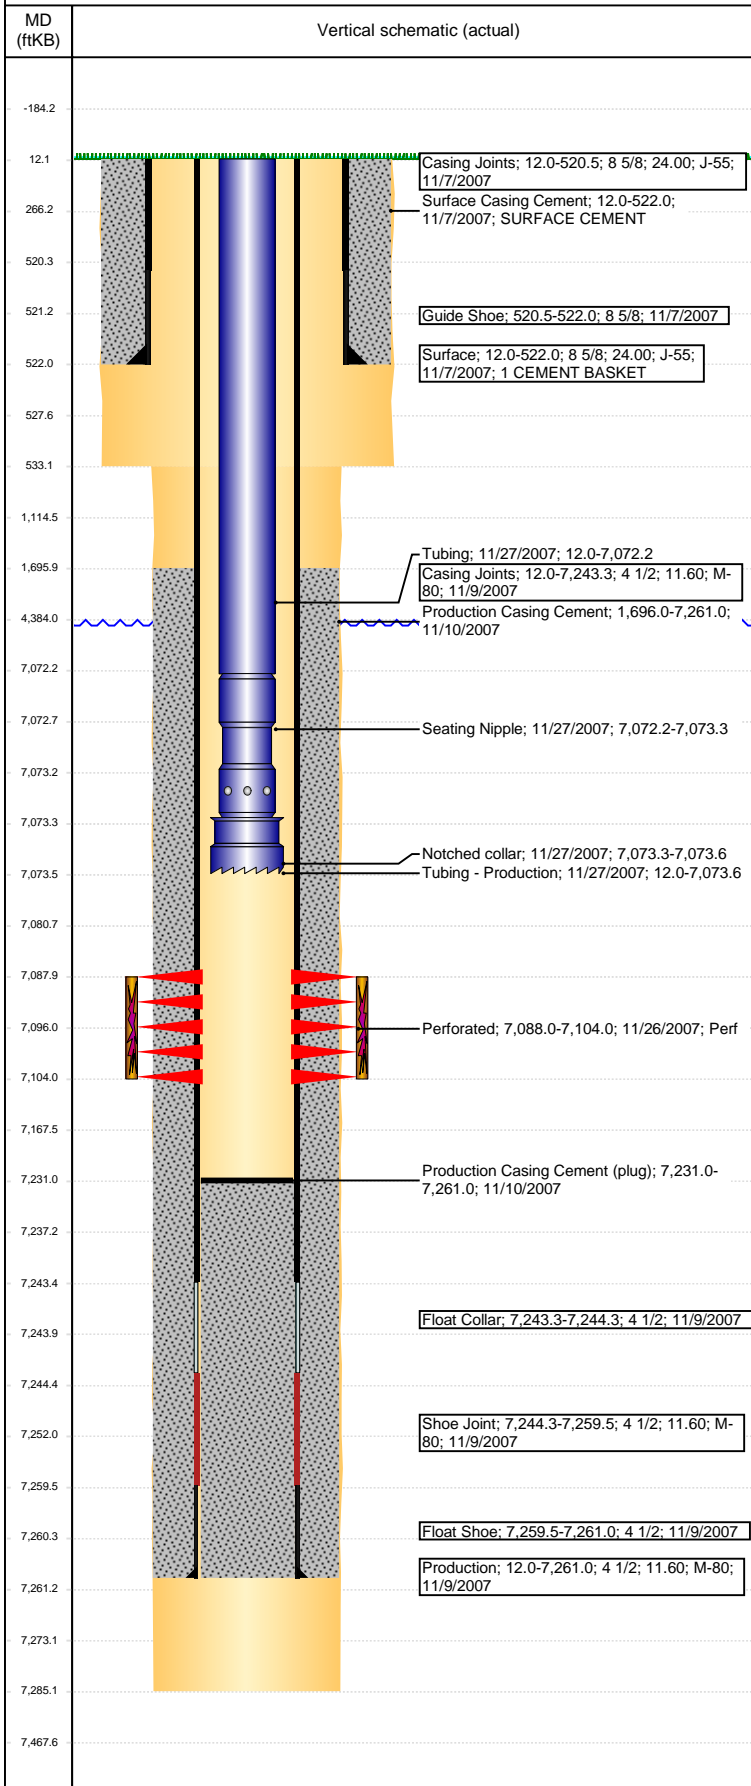

Well Header

API 05-123-26421	Business Unit DJ BASIN	District 15	Well Config VERTICAL
Original KB Elevation (ft) 4,747	KB - GL / MSL (ftKB) 12.00	Spud Date 11/6/2007	P & A Date
Comment			

Directions To Well

WCR 29 & WCR 66, W 0.7, SW 0.2 INTO LOCATION.

Congressional Location

Quarter 3 NW	Quarter 4 NW	Section 29	Township 6	Twnshp N/S Dir N	Range 66	Range E/W Dir W
-----------------	-----------------	---------------	---------------	---------------------	-------------	--------------------

Bottom Hole Location

North-South Distance (ft)	From N or S Line	East-West Distance (ft)	From E or W Line
---------------------------	------------------	-------------------------	------------------

Plug Back Total Depths

Date	Depth (ftKB)	Method	Com
11/9/2007	7,243.3	CASING TALLY	TOP OF FLOAT COLLAR
11/21/2007	7,231.0	CASED HOLE LOG	DEPTH LOGGER ON CBL

Wellbore Sections

Section Des	Size (in)	Act Top, MD (ftKB)	Act Btm, MD (ftKB)
Surface	12 1/4	12	533
Production	7 7/8	533	7,285

Zone Statuses

Zone Name	Status Date	Status	Fluid Type	Job	Prod Method
CODELL	1/7/2008	PR		DRILLING/CO...	

Casing Strings

Surface, 522.0ftKB

Casing Description	Run Date	OD (in)	Wt/Len (l...)	Grade	Top, MD (ft...)	MD (ftKB)
Surface	11/7/2007	8 5/8	24.00	J-55	12.0	522.0

Production, 7,261.0ftKB

Casing Description	Run Date	OD (in)	Wt/Len (l...)	Grade	Top, MD (ft...)	MD (ftKB)
Production	11/9/2007	4 1/2	11.60	M-80	12.0	7,261.0

Cement

Description	Top Depth (ftKB)	Bottom Depth (ftKB)
Surface Casing Cement	12.0	522.0
Description	Top Depth (ftKB)	Bottom Depth (ftKB)
Production Casing Cement	1,696.0	7,261.0

Tubing Strings

Tubing Description	Run Date	String...	ID (in)	Wt (lb/ft)	Grade	Len (ft)	Set De...
Tubing - Production	11/27/2007	2 3/8	2.00	4.70	J-55	7,061.61	

Tubing Components

Item Des	OD (in)	Wt (lb/ft)	Grade	Jts	Len (ft)	Btm (ftKB)	Btm (TVD) (ftKB)
Tubing	2 3/8	4.70	J-55	230	7,060.21	7,072.2	
Seating Nipple	2 3/8	1.10	J-55	1	1.10	7,073.3	
Notched collar	3 1/16		J-55	1	0.30	7,073.6	

Other In Hole

Run Date	Des	OD (in)	Top (ftKB)	Btm (ftKB)

Logs

Date	Type	Top, MD (ftKB)	Btm, MD (ftKB)
11/10/2007	COMPENSATED DENSITY	2,340.0	7,268.0
11/10/2007	INDUCTION	522.0	7,288.0
11/21/2007	CBL/CCL/GR	1,550.0	7,229.0

Perforation Data

Linked Zone	Bnch/St g	Sum of Entered Shot Total	Top (ftKB)	Btm (ftKB)	Date
CODELL, ORIGINAL HOLE		64	7,088.00	7,104.00	11/26/2007
Total (Sum)		64			

Stimulation Intervals

Start Date 12/5/2007	Primary Job Type DRILLING/COMPLETION - ORIGINAL		
Technical Result Success	Tech Result Details According to Plan	Tech Result Note	

Comment
CODELL NEW DRILL FRAC WENT GOOD - NO PROBLEMS TO REPORT