


DALEY LAND SURVEYING, INC. 970.302.4159
SCALED FACILITY DRAWING
CENTENNIAL STATE G35 PRODUCTION FACILITY

SECTION: 35
 TOWNSHIP: 4N
 RANGE: 65W

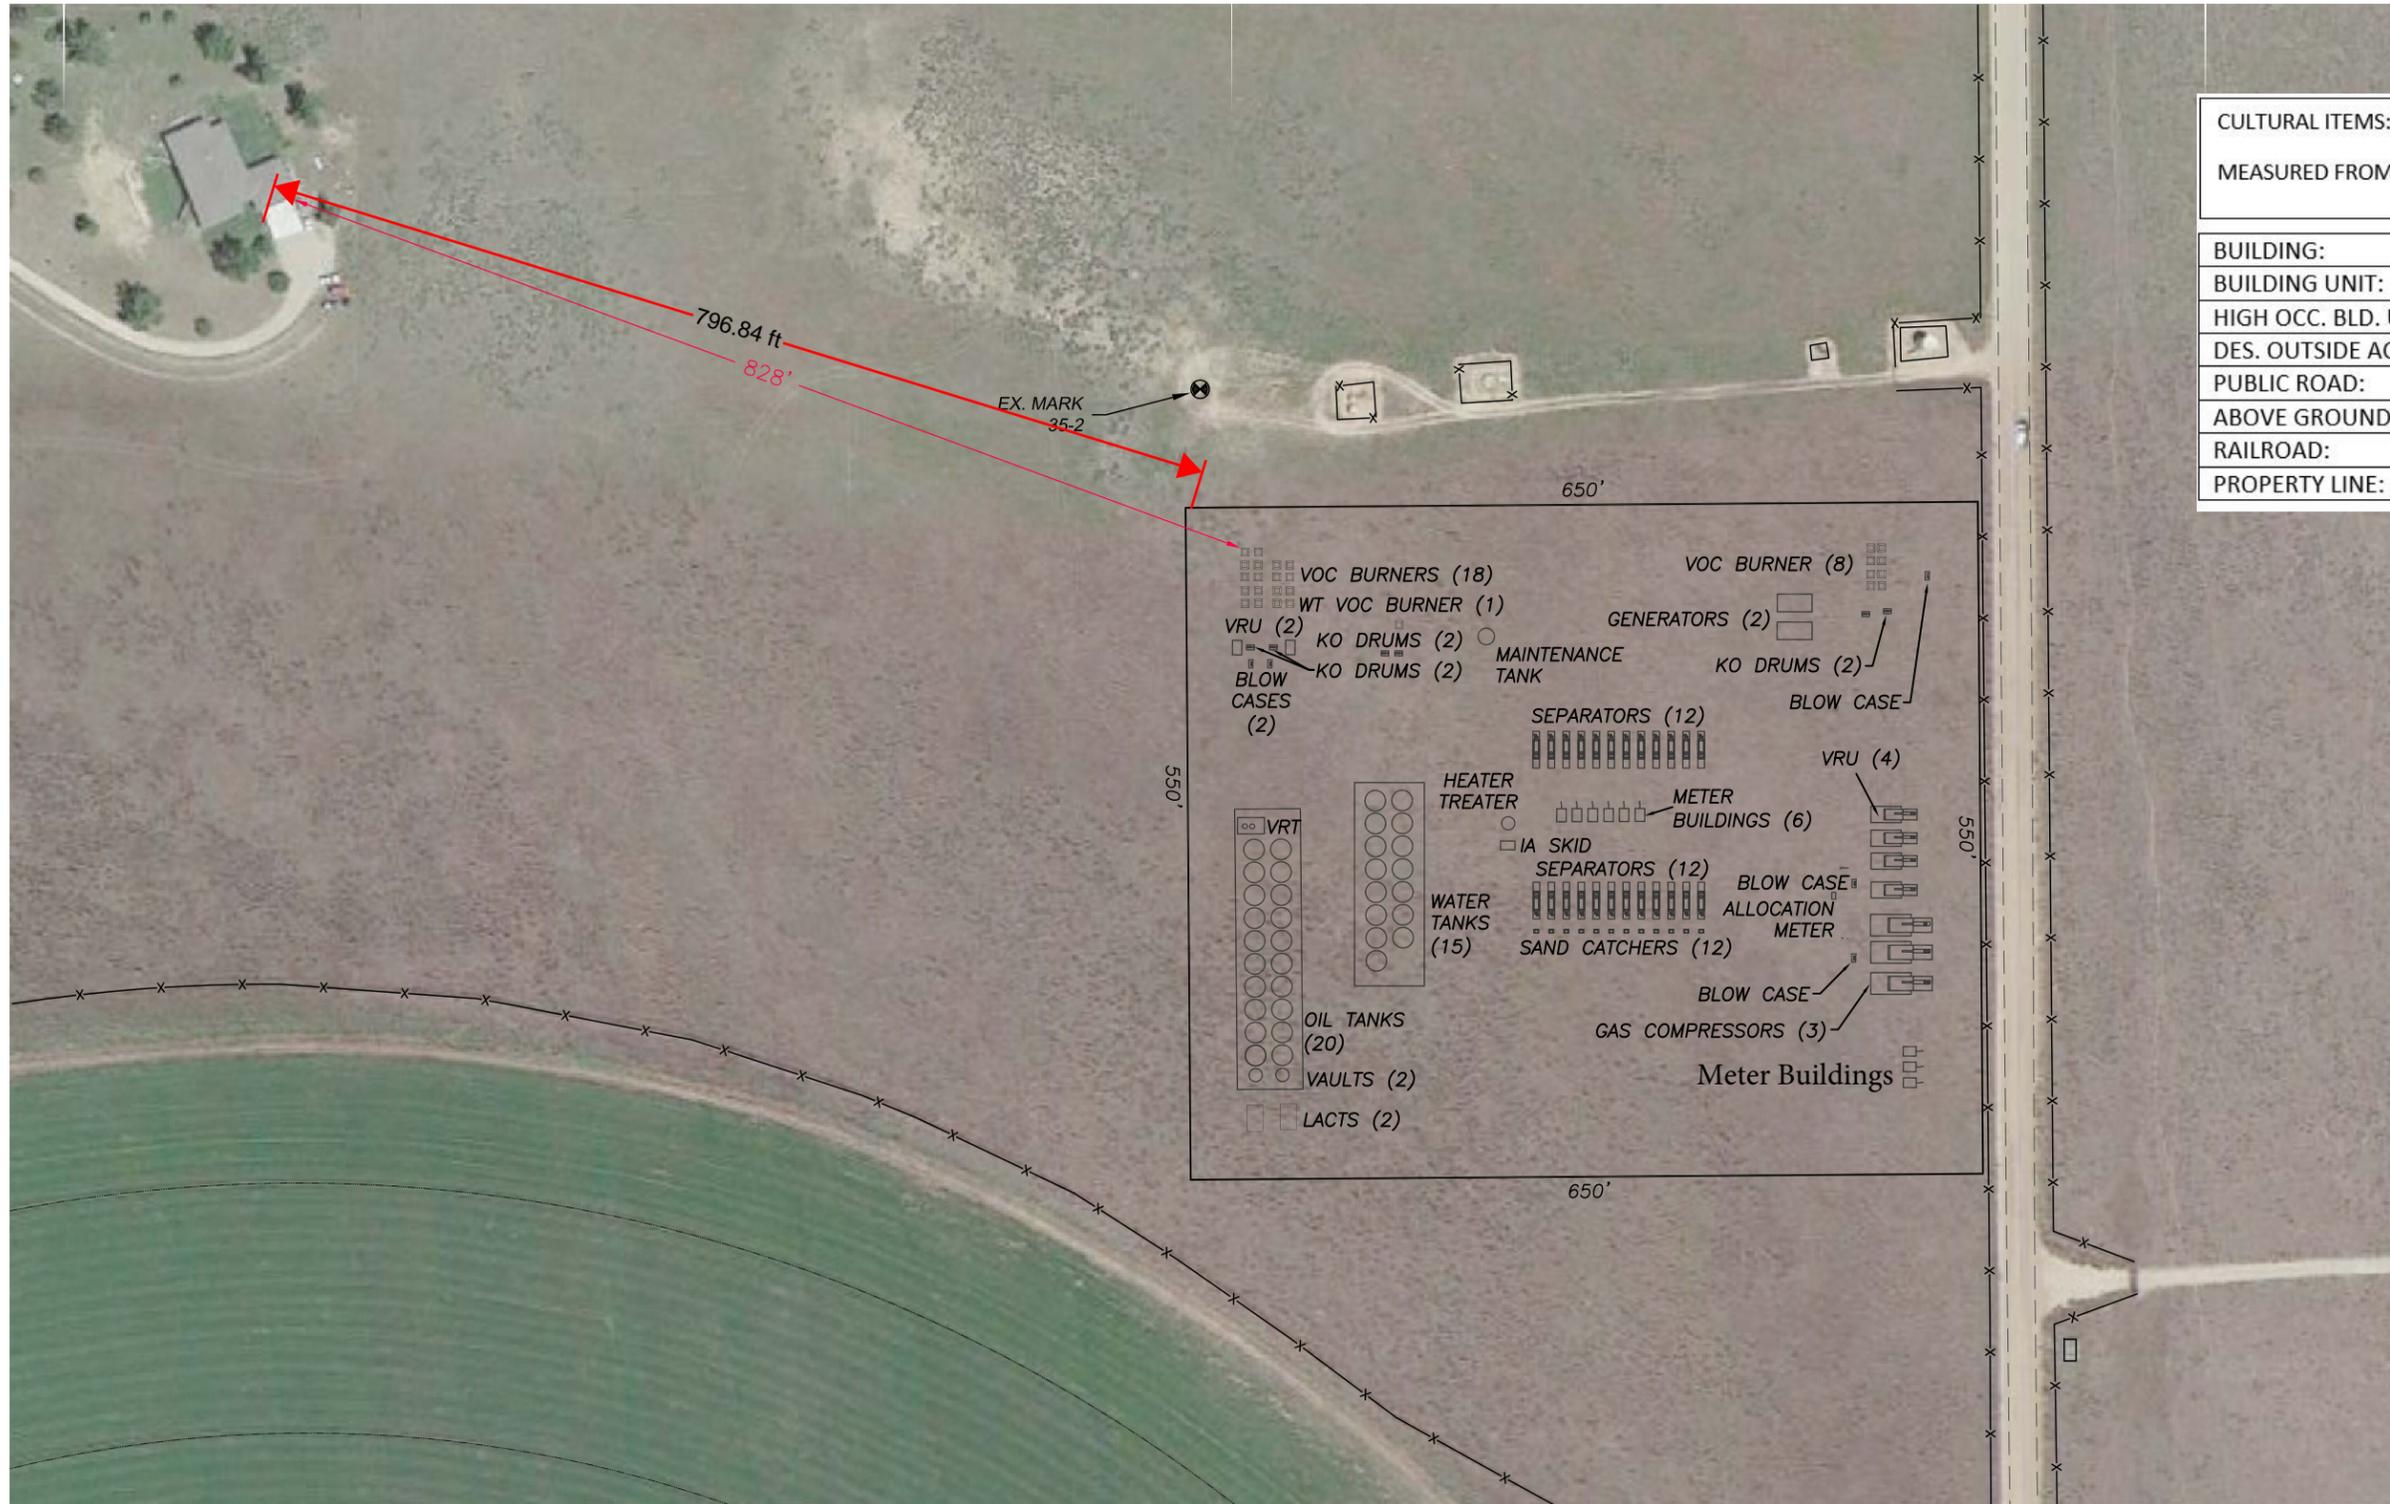

CULTURAL ITEMS:
 MEASURED FROM THE NEAREST PRODUCTION EQUIPMENT

BUILDING:	828' ± NW
BUILDING UNIT:	828' ± NW
HIGH OCC. BLD. UNIT:	5,280' ±
DES. OUTSIDE ACTIVITY AREA:	5,280' ±
PUBLIC ROAD:	69' ± E
ABOVE GROUND UTILITY:	945' ± NW
RAILROAD:	5,280' ±
PROPERTY LINE:	80' ± E

