


WELLBORE DIAGRAM
 EXTRACTION OIL & GAS
 OWL CREEK #26
 NWNW SEC 13 T7N R67W
 WELD COUNTY
 05-123-12065

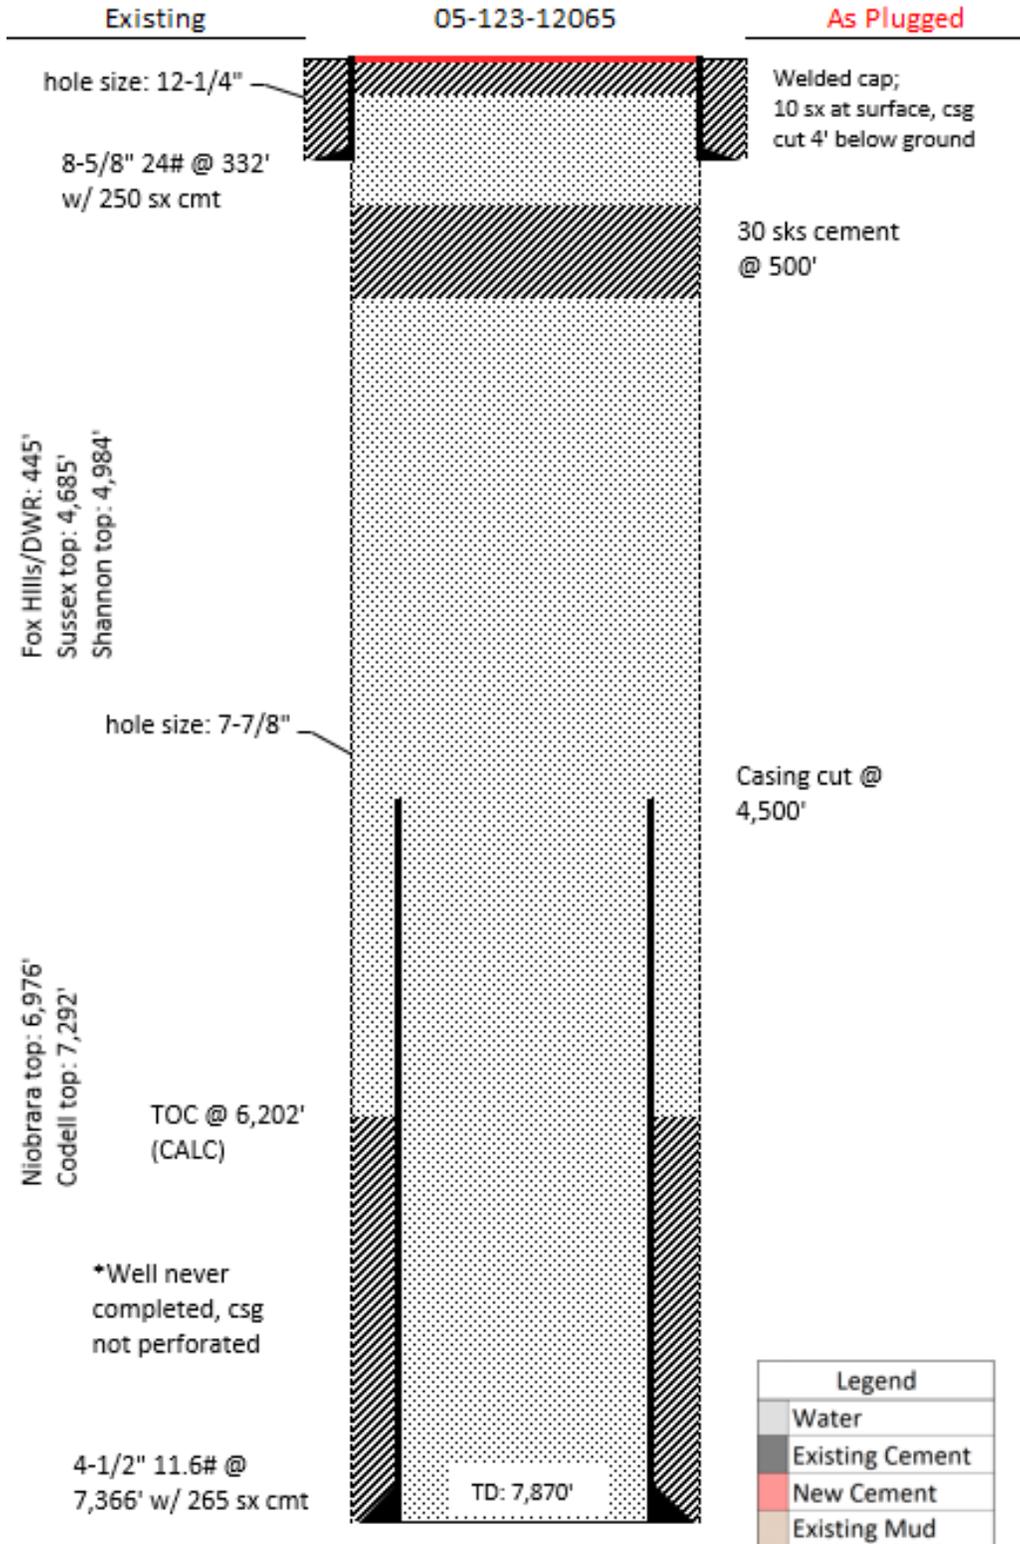

Existing

As Plugged

hole size: 12-1/4"

8-5/8" 24# @ 332'
w/ 250 sx cmt

Welded cap;
10 sx at surface, csg
cut 4' below ground

30 sks cement
@ 500'

Fox Hills/DWR: 445'
Sussex top: 4,685'
Shannon top: 4,984'

hole size: 7-7/8"

Casing cut @
4,500'

Niobrara top: 6,976'
Codell top: 7,292'

TOC @ 6,202'
(CALC)

*Well never
completed, csg
not perforated

4-1/2" 11.6# @
7,366' w/ 265 sx cmt

TD: 7,870'

Legend	
Water	(White)
Existing Cement	(Diagonal lines)
New Cement	(Red)
Existing Mud	(Dotted)