



Petroleum Development Corporation  
J & L Farms #24-29  
SESW Sec 29-T6N-R63W  
Weld County, CO

Current Wellbore Schematic - NOT TO SCALE!!!

7/10/2007

API#: 05-123-19435 ✓




7/11/2007

RECEIVED

JUL 17 07

COGCC

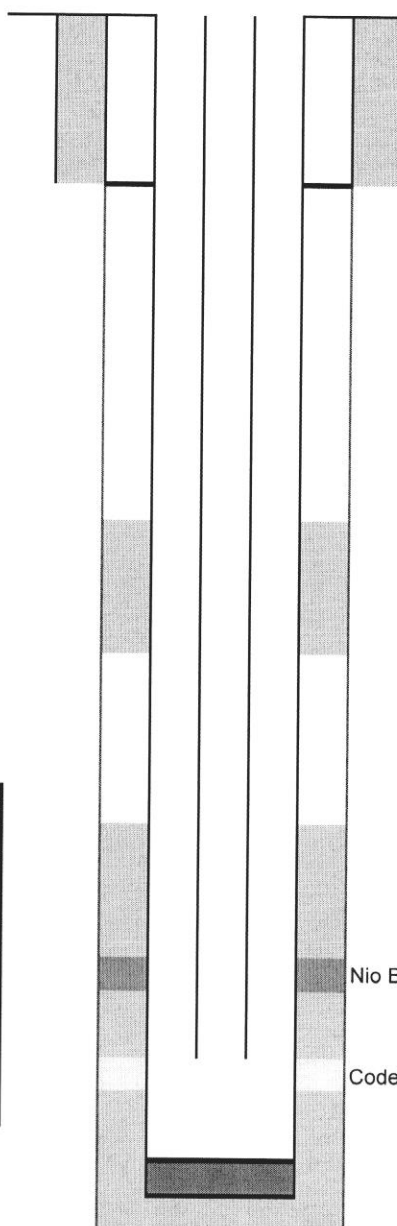

GL Elevation: 4676'

KB Elevation: 4686'

Surface Casing:
8 5/8" @ 318' 222 sx cmt.

Production Casing:
6996'

Longstring Cement:
0
642 sx
0
0

Top of Cement:
0

Perforations:	
Old:	Codell 6763'- 6773' (40 holes)
	0
	0
	0
New:	Codell 6763'- 6773' (30 holes)
	0
	0
	0

Current Tubing In Hole:
2 3/8 "
6731'
0

Nio B

Codell

PBTD:	6975'
Casing TD:	7005'

#### NOTES

Re-Perf Codell: 6763' - 6773', 30 holes, Re-Frac Codell: 2585 bbls Vistar 24# fluid system, 217,880 lbs. 20/40 White Sand, and 8000 lbs of Super LC 20/40 resin coated proppant, ATP 6304 psi, AIR: 14.1 bpm.pm.