


| | | | | |
|------------|---------------|---------------|-----------|---------------|
| API: | 05-123-18828 | KB ELEVATION: | 4836 | QTR-QTR: SENW |
| WELL NAME: | SEKICH A 6-17 | GROUND LEVEL: | 4826 | SECTION: 17 |
| COUNTY: | WELD | MD: | 7282 | TOWNSHIP: 3N |
| LATITUDE: | 40.227126 | PBMD: | 7240 | RANGE: 67W |
| LONGITUDE: | -104.9163036 | CREATED BY: | D. HASZ | |
| | | DATE: | 5/10/2017 | |

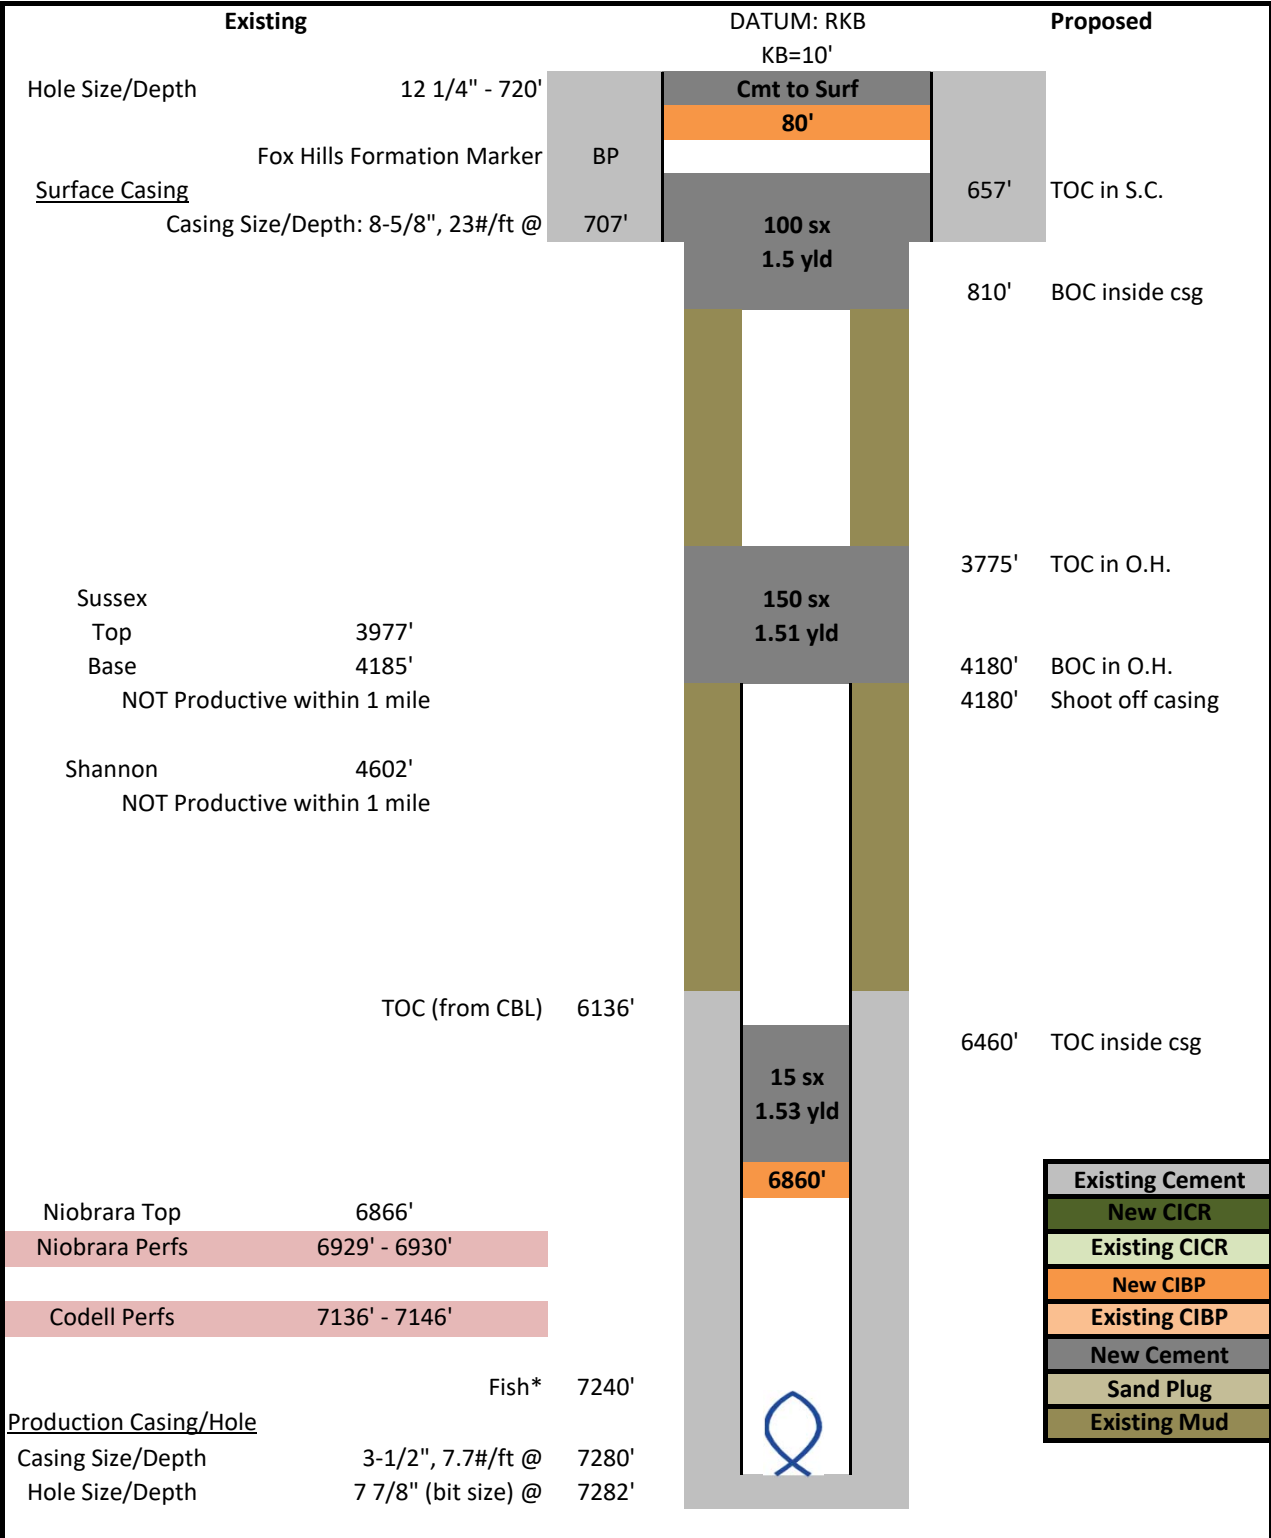

*Notched Collar, Seating Nipple, Tubing Stub, 4' jars at +/-7240' June 2008.