WELLBORE SCHEMATIC

CURRENT

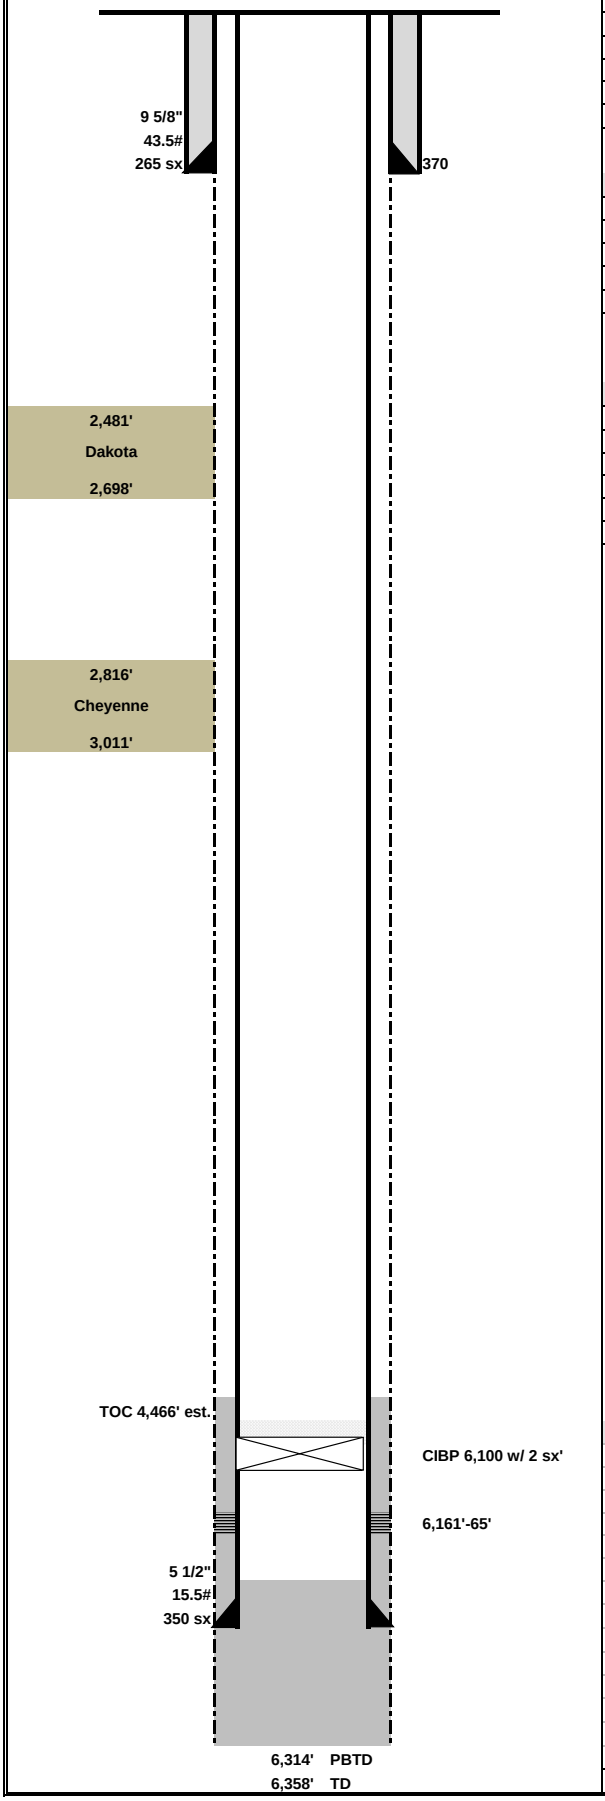

Citation Oil & Gas Corp.

Lease:	**Grays State**			Well No.	**#7 22-36**
API No.	05-01706918			Status	SI
Location:	SENW SEC 36 T12S R51W				
County:	Cheyenne	State:	CO	Field:	Bledsoe Ranch Unit
TD	6,358'	GL	4,770'	Spud Date:	10/12/88
PBTD	6,314'	KB	4,780'	Comp Date:	10/21/88
Current Perfs/OH:	6,161'-6,165'			Current Zone:	Morrow

Surface Equipment

Unit Make:		Unit Size:	
Unit S/N:		Unit Rotation:	
SPM:	Stroke Length:	Unit Sheave:	
Prime Mover:		Motor Sheave:	
Motor S/N:		Motor RPM:	

Casing Breakdown

	Size	Grade / Wt	Depth	Cement
Surface	9 5/8"	43.5#	370'	265 sx
Production	5 1/2"	15.5#	6358'	350 sx
Liner				
Liner				
Liner				

Current Completion Assembly

Qty	Description	Footage
	TOTAL	**0.00'**

Rod Detail

Qty	Description	Footage
	TOTAL	**0.00'**

Comments

PREPARED BY:	LL	UPDATED:	5/10/2017