


**Well Name: SHARKEY 14-26**

VERTICAL - ORIGINAL HOLE, 5/10/2017 4:19:16 PM

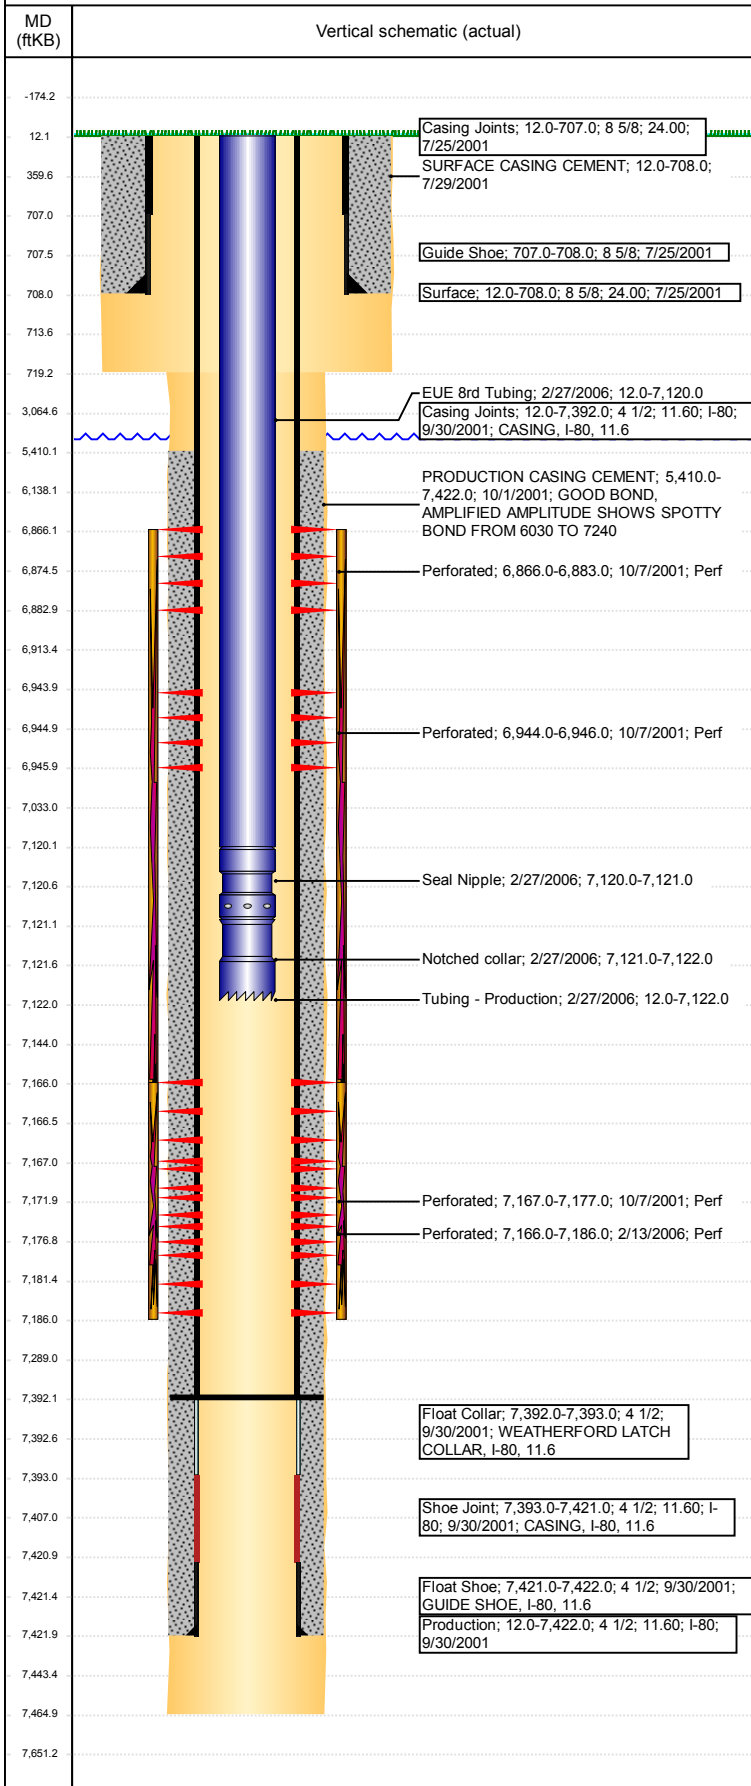

Well Header						
API 05-123-20426	Business Unit DJ BASIN		District 15		Well Config VERTICAL	
Original KB Elevation (ft) 4,759	KB - GL / MSL (ftKB) 12.00		Spud Date 7/26/2001		P & A Date	
Comment						
Directions To Well						
Congressional Location						
Quarter 3 SE	Quarter 4 SW	Section 26	Township 4	Twnshp N/S Dir N	Range 67	Range E/W Dir W
Bottom Hole Location						
North-South Distance (ft)		From N or S Line		East-West Distance (ft)		From E or W Line
Plug Back Total Depths						
Date	Depth (ftKB)	Method		Com		
9/30/2001	7,392.0	CASING TALLY		TOP OF FLOAT COLLAR		
10/5/2001	7,400.0	CASED HOLE LOG		CBL DEPTH LOGGER		
3/2/2006	7,392.0	TAG		LAST C/O TO PBTD		
Wellbore Sections						
Section Des		Size (in)		Act Top, MD (ftKB)		Act Btm, MD (ftKB)
SURFACE		12 1/4		12		719
PRODUCTION		6 1/2		719		7,465
Zone Statuses						
Zone Name	Status Date	Status	Fluid Type	Job	Prod Method	
NIOBRARA	10/24/2001	PR		DRILLING/CO...		
CODELL	10/24/2001	PR		DRILLING/CO...		
CODELL	2/22/2006	PR		RE-FRAC, 2/10...		
Casing Strings						
Surface, 708.0ftKB						
Casing Description Surface	Run Date 7/25/2001	OD (in) 8 5/8	Wt/Len (l... 24.00	Grade	Top, MD (ft... 12.0	MD (ftKB) 708.0
Production, 7,422.0ftKB						
Casing Description Production	Run Date 9/30/2001	OD (in) 4 1/2	Wt/Len (l... 11.60	Grade I-80	Top, MD (ft... 12.0	MD (ftKB) 7,422.0
Cement						
Description SURFACE CASING CEMENT				Top Depth (ftKB) 12.0		Bottom Depth (ftKB) 708.0
Description PRODUCTION CASING CEMENT				Top Depth (ftKB) 5,410.0		Bottom Depth (ftKB) 7,422.0
Tubing Strings						
Tubing Description Tubing - Production	Run Date 2/27/2006	String ... 2 3/8	ID (in) 2.00	Wt (lb/ft) 4.70	Grade J-55	Len (ft) 7,110.00
Set De...						
Tubing Components						
Item Des	OD (in)	Wt (lb/ft)	Grade	Jts	Len (ft)	Btm (ftKB)
EUE 8rd Tubing	2 3/8	4.70	J-55	226	7,108.00	7,120.0
Seal Nipple	2 3/8			1	1.00	7,121.0
Notched collar	2 3/8			1	1.00	7,122.0
Other In Hole						
Run Date	Des			OD (in)	Top (ftKB)	Btm (ftKB)
Logs						
Date	Type				Top, MD (ftKB)	Btm, MD (ftKB)
9/28/2001	COMPENSATED DENSITY				725.0	4,200.0
9/28/2001	INDUCTION				725.0	7,451.0
10/5/2001	CBL/CCL/GR				5,100.0	7,394.0
Perforation Data						
Linked Zone	Bnch/St g	Sum of Entered Shot Total	Top (ftKB)		Btm (ftKB)	Date
NIOBRARA, ORIGINAL HOLE	A	6	6,866.00		6,883.00	10/7/2001
NIOBRARA, ORIGINAL HOLE	B	3	6,944.00		6,946.00	10/7/2001
CODELL, ORIGINAL HOLE		60	7,166.00		7,186.00	2/13/2006
CODELL, ORIGINAL HOLE		10	7,167.00		7,177.00	10/7/2001
Total (Sum)		79				

**Well Name: SHARKEY 14-26**

VERTICAL - ORIGINAL HOLE, 5/10/2017 4:19:17 PM

## Stimulation Intervals

Start Date 10/11/2001	Primary Job Type DRILLING/COMPLETION - ORIGINAL	
Technical Result	Tech Result Details	Tech Result Note
Comment		
Start Date 2/21/2006	Primary Job Type RE-FRAC	
Technical Result	Tech Result Details	Tech Result Note
Comment		

