


**Well Name: BEEBE 17-3**


VERTICAL - ORIGINAL HOLE, 5/15/2017 3:11:44 PM

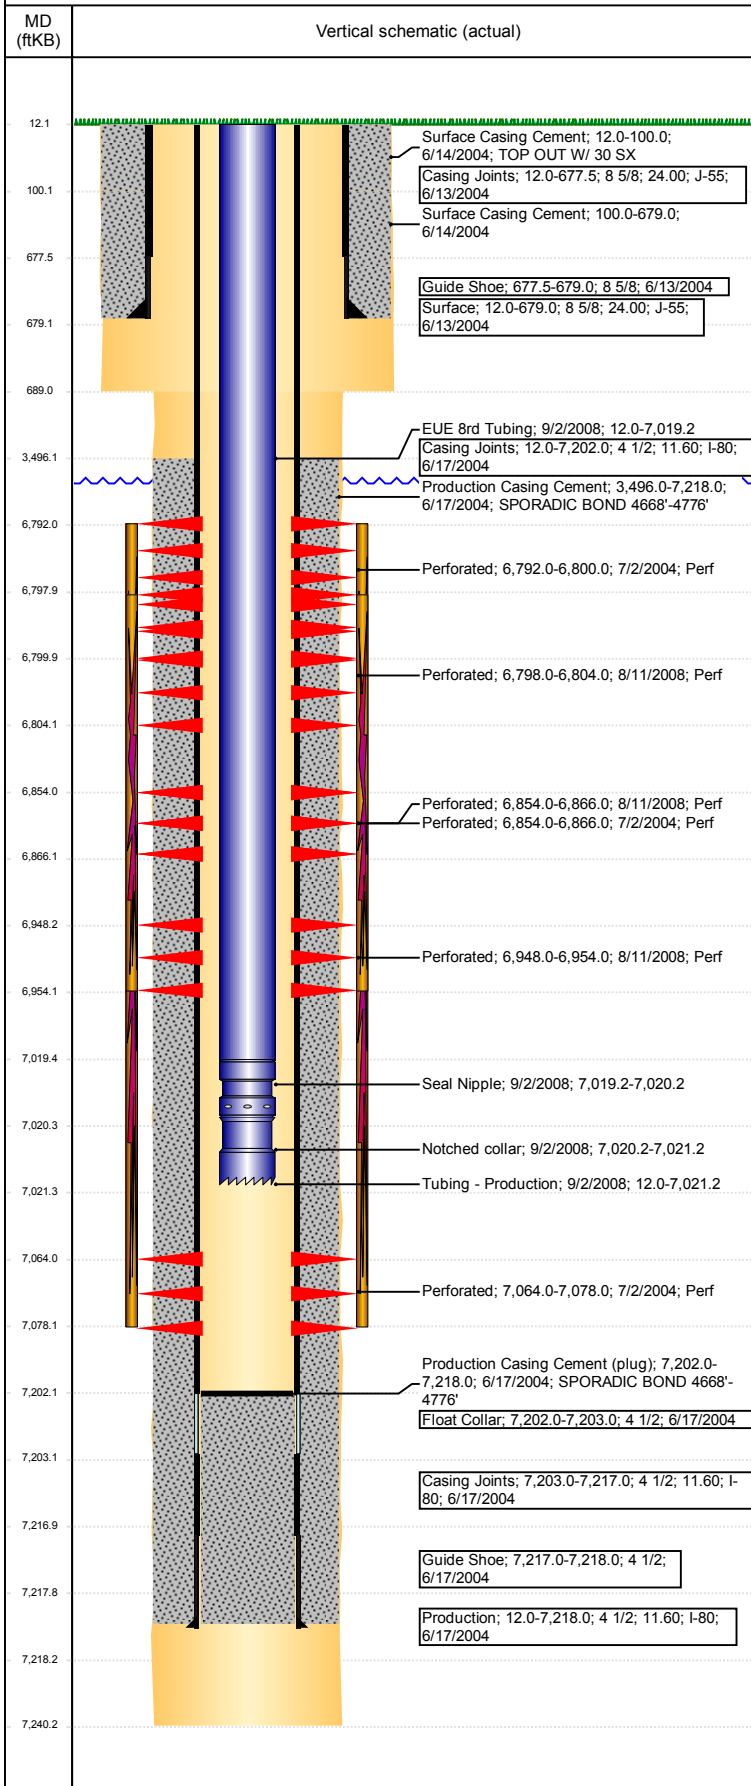

Well Header						
API 05-123-22192	Business Unit DJ BASIN	District 15	Well Config VERTICAL			
Original KB Elevation (ft) 4,772	KB - GL / MSL (ftKB) 12.00	Spud Date 6/13/2004	P & A Date			
Comment						
Directions To Well RD 43 & RD 40, E 1/2, S INTO						
Congressional Location						
Quarter 3 SE	Quarter 4 NE	Section 3	Township 3	Twnshp N/S Dir N	Range 65	Range E/W Dir W
Bottom Hole Location						
North-South Distance (ft)		From N or S Line		East-West Distance (ft)		From E or W Line
Plug Back Total Depths						
Date	Depth (ftKB)	Method		Com		
6/17/2004	7,202.0	CASING TALLY		TOP OF FLOAT COLLAR		
7/2/2004	7,168.0	CASED HOLE LOG		DEPTH LOGGER ON CBL		
7/13/2004	7,202.0	TAG		CLEAN OUT		
Wellbore Sections						
Section Des		Size (in)		Act Top, MD (ftKB)		Act Btm, MD (ftKB)
SURFACE		12 1/4		12		689
PRODUCTION		7 7/8		689		7,240
Zone Statuses						
Zone Name	Status Date	Status	Fluid Type	Job	Prod Method	
NIOBRARA	7/21/2004	PR	Water	DRILLING/CO...	Flowing	
NIOBRARA	8/19/2008	PR		RE-FRAC, 7/27...		
NIOBRARA	9/8/2008	PR		COMMINGLE...		
NIOBRARA	6/19/2014	PR				
NIOBRARA	2/9/2017	SI				
NIOBRARA	5/2/2017	PR	Water	DRILLING/CO...	Flowing	
CODELL	7/21/2004	PR		RE-FRAC, 7/27...		
CODELL	8/11/2008	SI		COMMINGLE...		
CODELL	9/8/2008	PR				
CODELL	6/19/2014	PR				
NIOBRARA-C...	6/19/2014	PR	Water		Flowing	
Casing Strings						
Surface, 679.0ftKB						
Casing Description Surface	Run Date 6/13/2004	OD (in) 8 5/8	Wt/Len (l...) 24.00	Grade J-55	Top, MD (ft...) 12.0	MD (ftKB) 679.0
Production, 7,218.0ftKB						
Casing Description Production	Run Date 6/17/2004	OD (in) 4 1/2	Wt/Len (l...) 11.60	Grade I-80	Top, MD (ft...) 12.0	MD (ftKB) 7,218.0
Cement						
Description				Top Depth (ftKB)		Bottom Depth (ftKB)
Surface Casing Cement				12.0		100.0
Description				Top Depth (ftKB)		Bottom Depth (ftKB)
Surface Casing Cement				100.0		679.0
Description				Top Depth (ftKB)		Bottom Depth (ftKB)
Production Casing Cement				3,496.0		7,218.0
Tubing Strings						
Tubing Description BRIDGE PLUG	Run Date 8/11/2008	String...	ID (in)	Wt (lb/ft)	Grade	Len (ft)
						1.00
Tubing Description Tubing - Production	Run Date 9/2/2008	String...	ID (in)	Wt (lb/ft)	Grade	Len (ft)
		2 3/8	2.00	4.70	J-55	7,009.21
Tubing Components						
Item Des	OD (in)	Wt (lb/ft)	Grade	Jts	Len (ft)	Btm (ftKB)
EUE 8rd Tubing	2 3/8	4.70	J-55	228	7,007.21	7,019.2
Seal Nipple	2 3/8			1	1.00	7,020.2
Notched collar	2 3/8			1	1.00	7,021.2
Other In Hole						
Run Date	Des			OD (in)	Top (ftKB)	Btm (ftKB)
Logs						
Date	Type				Top, MD (ftKB)	Btm, MD (ftKB)
6/17/2004	COMPENSATED DENSITY				4,200.0	7,207.0

**Well Name: BEEBE 17-3**

VERTICAL - ORIGINAL HOLE, 5/15/2017 3:11:45 PM

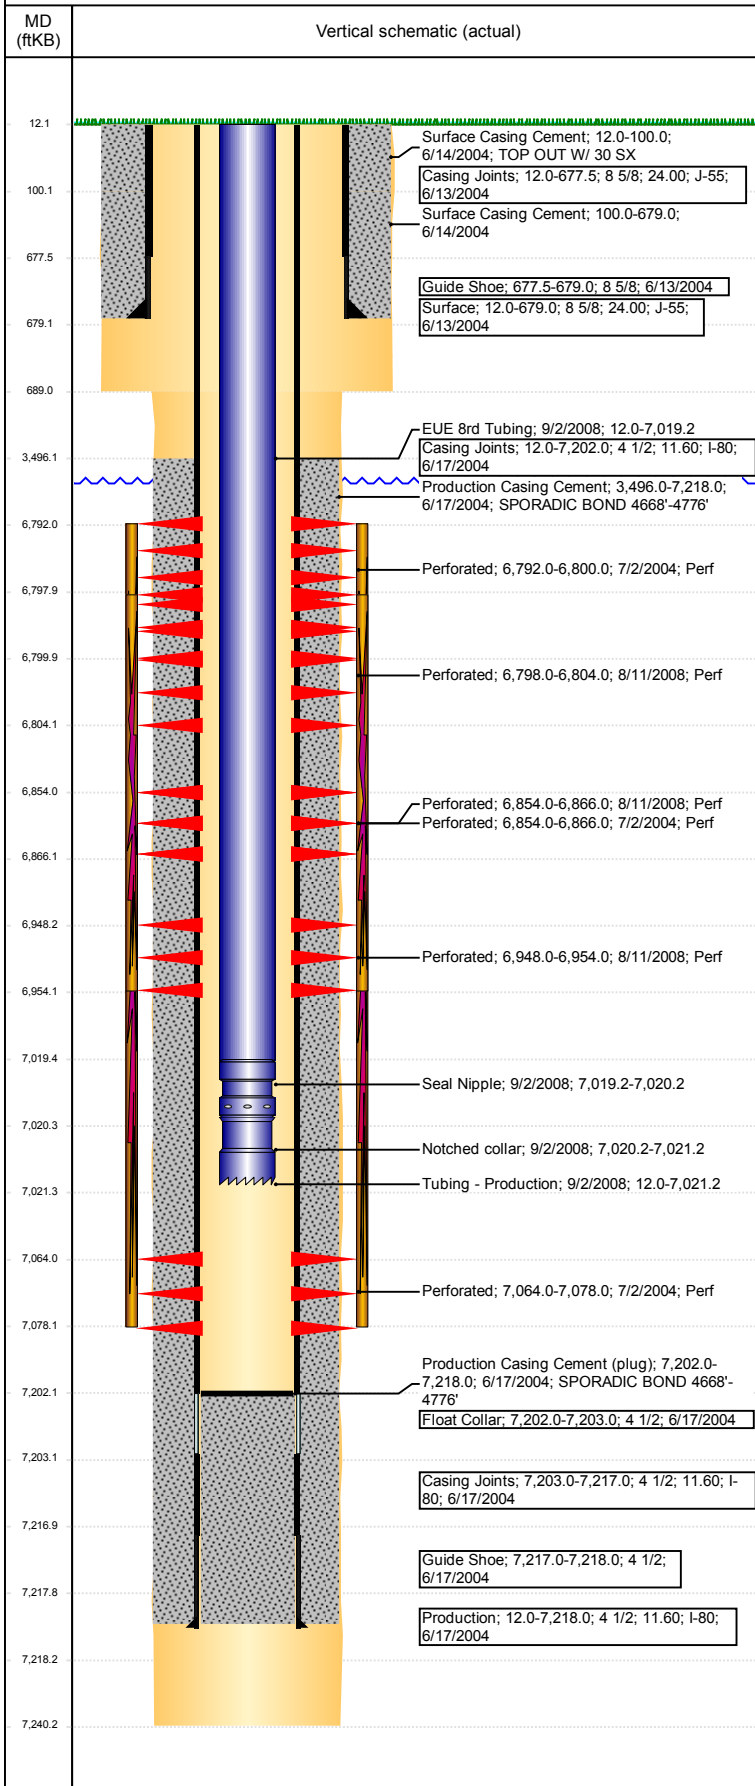

Logs			
Date	Type	Top, MD (ftKB)	Btm, MD (ftKB)
6/17/2004	INDUCTION	679.0	7,227.0
7/2/2004	CEMENT BOND	3,163.0	7,165.0
8/11/2008	PERFORATION	6,660.0	7,080.0

Perforation Data					
Linked Zone	Bnch/St g	Sum of Entered Shot Total	Top (ftKB)	Btm (ftKB)	Date
NIORARA, ORIGINAL HOLE	A	9	6,792.00	6,800.00	7/2/2004
NIORARA, ORIGINAL HOLE	A	18	6,798.00	6,804.00	8/11/2008
NIORARA, ORIGINAL HOLE	B	13	6,854.00	6,866.00	7/2/2004
NIORARA, ORIGINAL HOLE	B	36	6,854.00	6,866.00	8/11/2008
NIORARA, ORIGINAL HOLE	C	18	6,948.00	6,954.00	8/11/2008
CODELL, ORIGINAL HOLE		28	7,064.00	7,078.00	7/2/2004
<b>Total (Sum)</b>		<b>122</b>			

Stimulation Intervals		
Start Date	Primary Job Type	
7/7/2004	DRILLING/COMPLETION - ORIGINAL	
Technical Result	Tech Result Details	Tech Result Note

Comment		
LIMITED ENTRY FRAC		
SCREENED OUT		
Start Date	Primary Job Type	
8/15/2008	RE-FRAC	
Technical Result	Tech Result Details	Tech Result Note
Comment		