


Well Name: FIRESTIEN 30-44

VERTICAL - ORIGINAL HOLE, 4/27/2017 10:18:15 AM

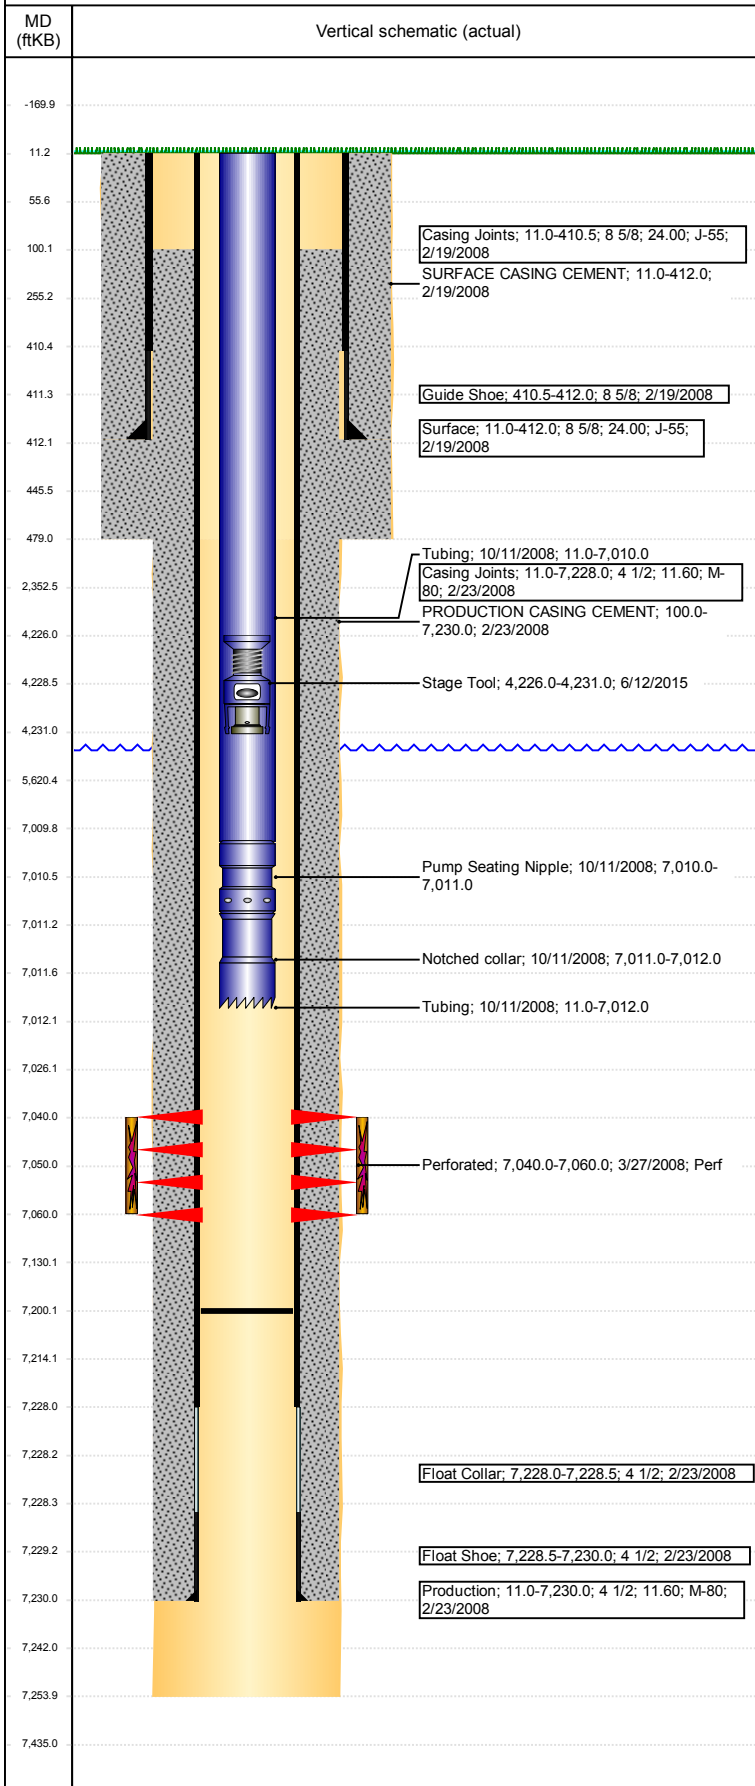

Well Header						
API 05-123-26675		Business Unit DJ BASIN		District 15	Well Config VERTICAL	
Original KB Elevation (ft) 4,735		KB - GL / MSL (ftKB) 11.00		Spud Date 2/18/2008		P & A Date
Comment WELL DATA SPARSE. CBL RUN DATE 2/21/08 BUT DIDN'T TD UNTIL 2/22/08.						
Directions To Well						
Congressional Location						
Quarter 3 SE	Quarter 4 SE	Section 30	Township 6	Twnshp N/S Dir N	Range 66	Range E/W Dir W
Bottom Hole Location						
North-South Distance (ft)		From N or S Line		East-West Distance (ft)		From E or W Line
Plug Back Total Depths						
Date	Depth (ftKB)	Method		Com		
2/21/2008	7,178.0	CASED HOLE LOG		DEPTH LOGGER ON CBL		
2/24/2008	7,215.0	CASING TALLY		FLOAT SHOE WITH BAFFLE		
10/11/2008	7,200.0	TAG		CLEANOUT TO LAND TBG		
Wellbore Sections						
Section Des		Size (in)		Act Top, MD (ftKB)		Act Btm, MD (ftKB)
SURFACE		12 1/4		11		479
PRODUCTION		7 7/8		479		7,254
Zone Statuses						
Zone Name	Status Date	Status	Fluid Type	Job	Prod Method	
CODELL	4/30/2008	PR		DRILLING/CO...		
Casing Strings						
Surface, 412.0ftKB						
Casing Description	Run Date	OD (in)	Wt/Len (l...	Grade	Top, MD (ft...	MD (ftKB)
Surface	2/19/2008	8 5/8	24.00	J-55	11.0	412.0
Production, 7,230.0ftKB						
Casing Description	Run Date	OD (in)	Wt/Len (l...	Grade	Top, MD (ft...	MD (ftKB)
Production	2/23/2008	4 1/2	11.60	M-80	11.0	7,230.0
Cement						
Description				Top Depth (ftKB)		Bottom Depth (ftKB)
SURFACE CASING CEMENT				11.0		412.0
Description				Top Depth (ftKB)		Bottom Depth (ftKB)
PRODUCTION CASING CEMENT				100.0		7,230.0
Tubing Strings						
Tubing Description	Run Date	String...	ID (in)	Wt (lb/ft)	Grade	Len (ft)
Tubing	10/11/2008	2 3/8				7,001.00
Tubing Components						
Item Des	OD (in)	Wt (lb/ft)	Grade	Jts	Len (ft)	Btm (ftKB)
Tubing	2 3/8			227	6,999.00	7,010.0
Pump Seating	2 3/8	1.10		1	1.00	7,011.0
Nipple						
Notched collar	2 3/8			1	1.00	7,012.0
Other In Hole						
Run Date	Des			OD (in)	Top (ftKB)	Btm (ftKB)
6/12/2015	Stage Tool			2	4,226.0	4,231.0
Logs						
Date	Type				Top, MD (ftKB)	Btm, MD (ftKB)
2/21/2008	CEMENT BOND				50.0	7,176.0
2/23/2008	COMPENSATED DENSITY				3,450.0	7,226.0
2/23/2008	INDUCTION				412.0	7,246.0
Perforation Data						
Linked Zone		Bnch/St g	Sum of Entered Shot Total	Top (ftKB)	Btm (ftKB)	Date
CODELL, ORIGINAL HOLE			80	7,040.00	7,060.00	3/27/2008
Total (Sum)			80			

Well Name: FIRESTIEN 30-44

VERTICAL - ORIGINAL HOLE, 4/27/2017 10:18:16 AM

Stimulation Intervals

Start Date 3/28/2008	Primary Job Type DRILLING/COMPLETION - ORIGINAL	
Technical Result	Tech Result Details	Tech Result Note
Comment		

