



# Kerr-McGee Oil & Gas Onshore LP

A subsidiary of Anadarko Petroleum Corporation

1099 18<sup>th</sup> Street  
Denver, CO 80202  
720-929-6000

May 12, 2017

Matt Lepore  
Director, Colorado Oil and Gas Conservation Commission  
Department of Natural Resources  
The Chancery Building  
1120 Lincoln Street, Suite 801  
Denver, CO 80203

Re: **30 Day Certification Letter - 318A.e**  
Yellowhammer 30N-8HZ (Doc # 401130415)  
Township 1 North, Range 68 West  
Section 8: NWSW  
Unit Acreage: 480  
Unit Spacing: 1N-68W Sec 5: SWSW  
1N-68W Sec 6: SESE  
1N-68W Sec 7: E2E2  
1N-68W Sec 8: W2W2  
1N-68W Sec 17: NWNW  
1N-68W 18: NENE

Weld County, Colorado

Dear Director Lepore:

Kerr-McGee Oil and Gas Onshore LP ("KMG") hereby certifies that a thirty (30) day notice has been given by certified mail to all mineral owners in the proposed wellbore spacing unit. We received an objection from Crestone on 10/17/16 regarding mineral ownership in the proposed spacing unit. After further negotiations, Crestone lifted their objection on 5/11/17. KMG hereby respectfully requests approval of this well and spacing unit.

If you have any questions or issues regarding this permit, please contact me at (720) 929-6907.


Sincerely,

**KERR-McGEE OIL AND GAS ONSHORE LP**

A handwritten signature in black ink that reads 'Shayelyn Marshall'.

Shayelyn Marshall  
Regulatory Analyst II

## PROPOSED SPACING UNIT

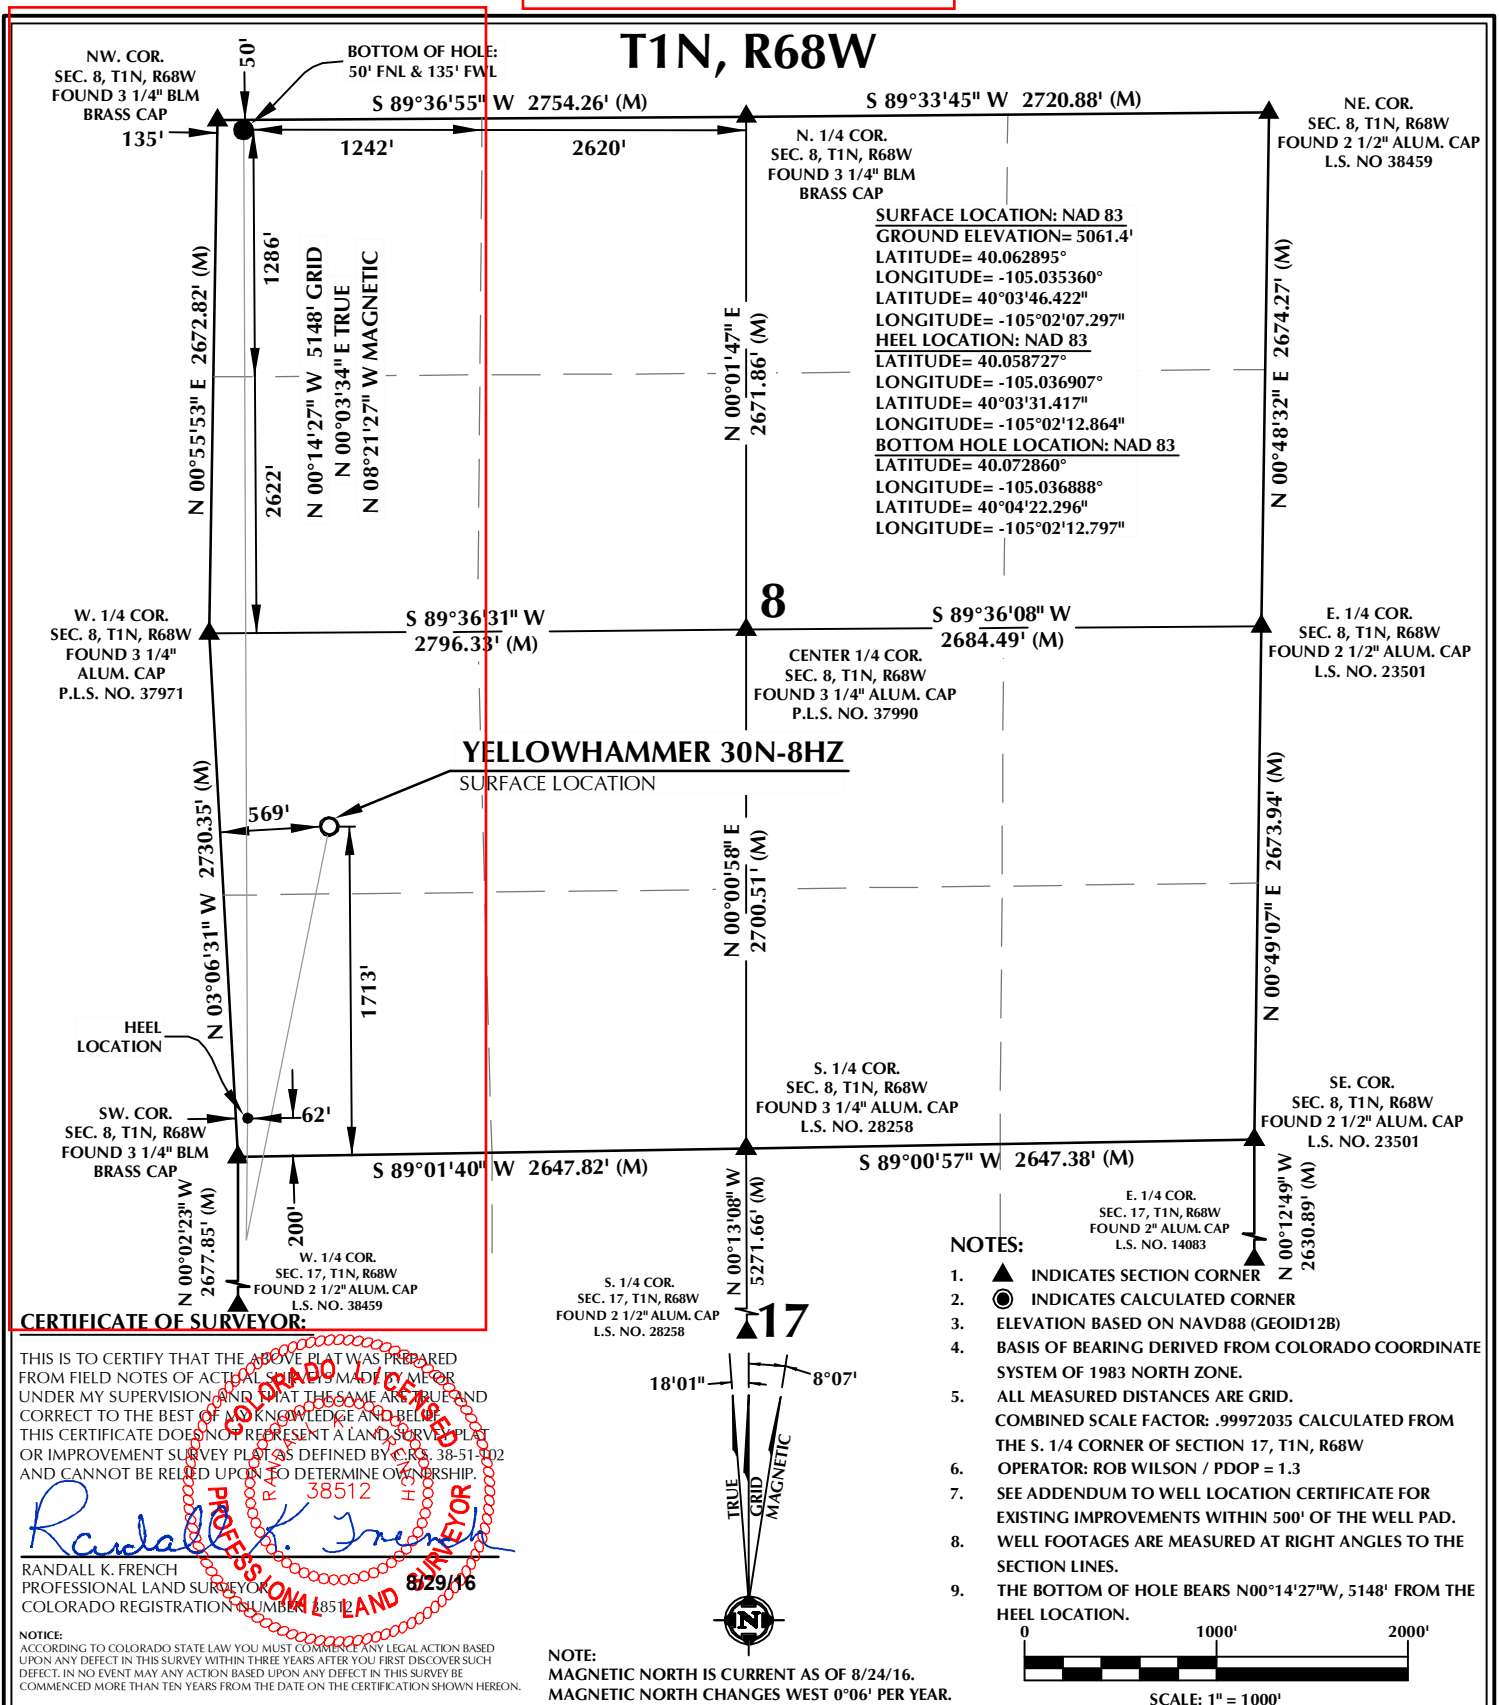

**WELL PAD - YELLOWHAMMER 30N2-8HZ**

YELLOWHAMMER 30N-8HZ  
WELL LOCATION CERTIFICATE  
1713' FSL & 569' FWL NWSW (SURFACE)  
200' FSL & 62' FWL SWSW (HEEL)  
50' FNL & 135' FWL NWNW (BOTTOM)  
LOCATED IN SECTION 8  
T1N, R68W, 6TH P.M.  
WELD COUNTY, COLORADO

**Kerr-McGee Oil &  
Gas Onshore L.P.**  
1099 18th Street  
Denver, Colorado 80202



CONSULTING, LLC

**SHERIDAN OFFICE**  
1095 Saberton Avenue  
Sheridan, Wyoming 82801  
Phone 307-674-0609

**LOVELAND OFFICE**  
1635 Foxtrail Drive, Suite 204  
Loveland, Colorado 80538  
Phone 970-776-4331

DRAFTED BY:	LMO	CHECKED BY:	RKF
DATE DRAFTED:	8/29/16	DATE SURVEYED:	6/30/16
REVISED:		FILE NAME:	16-04