


SEKILCH 31-19
FIDW LINE'S EDGE 410FT

ACTIVE

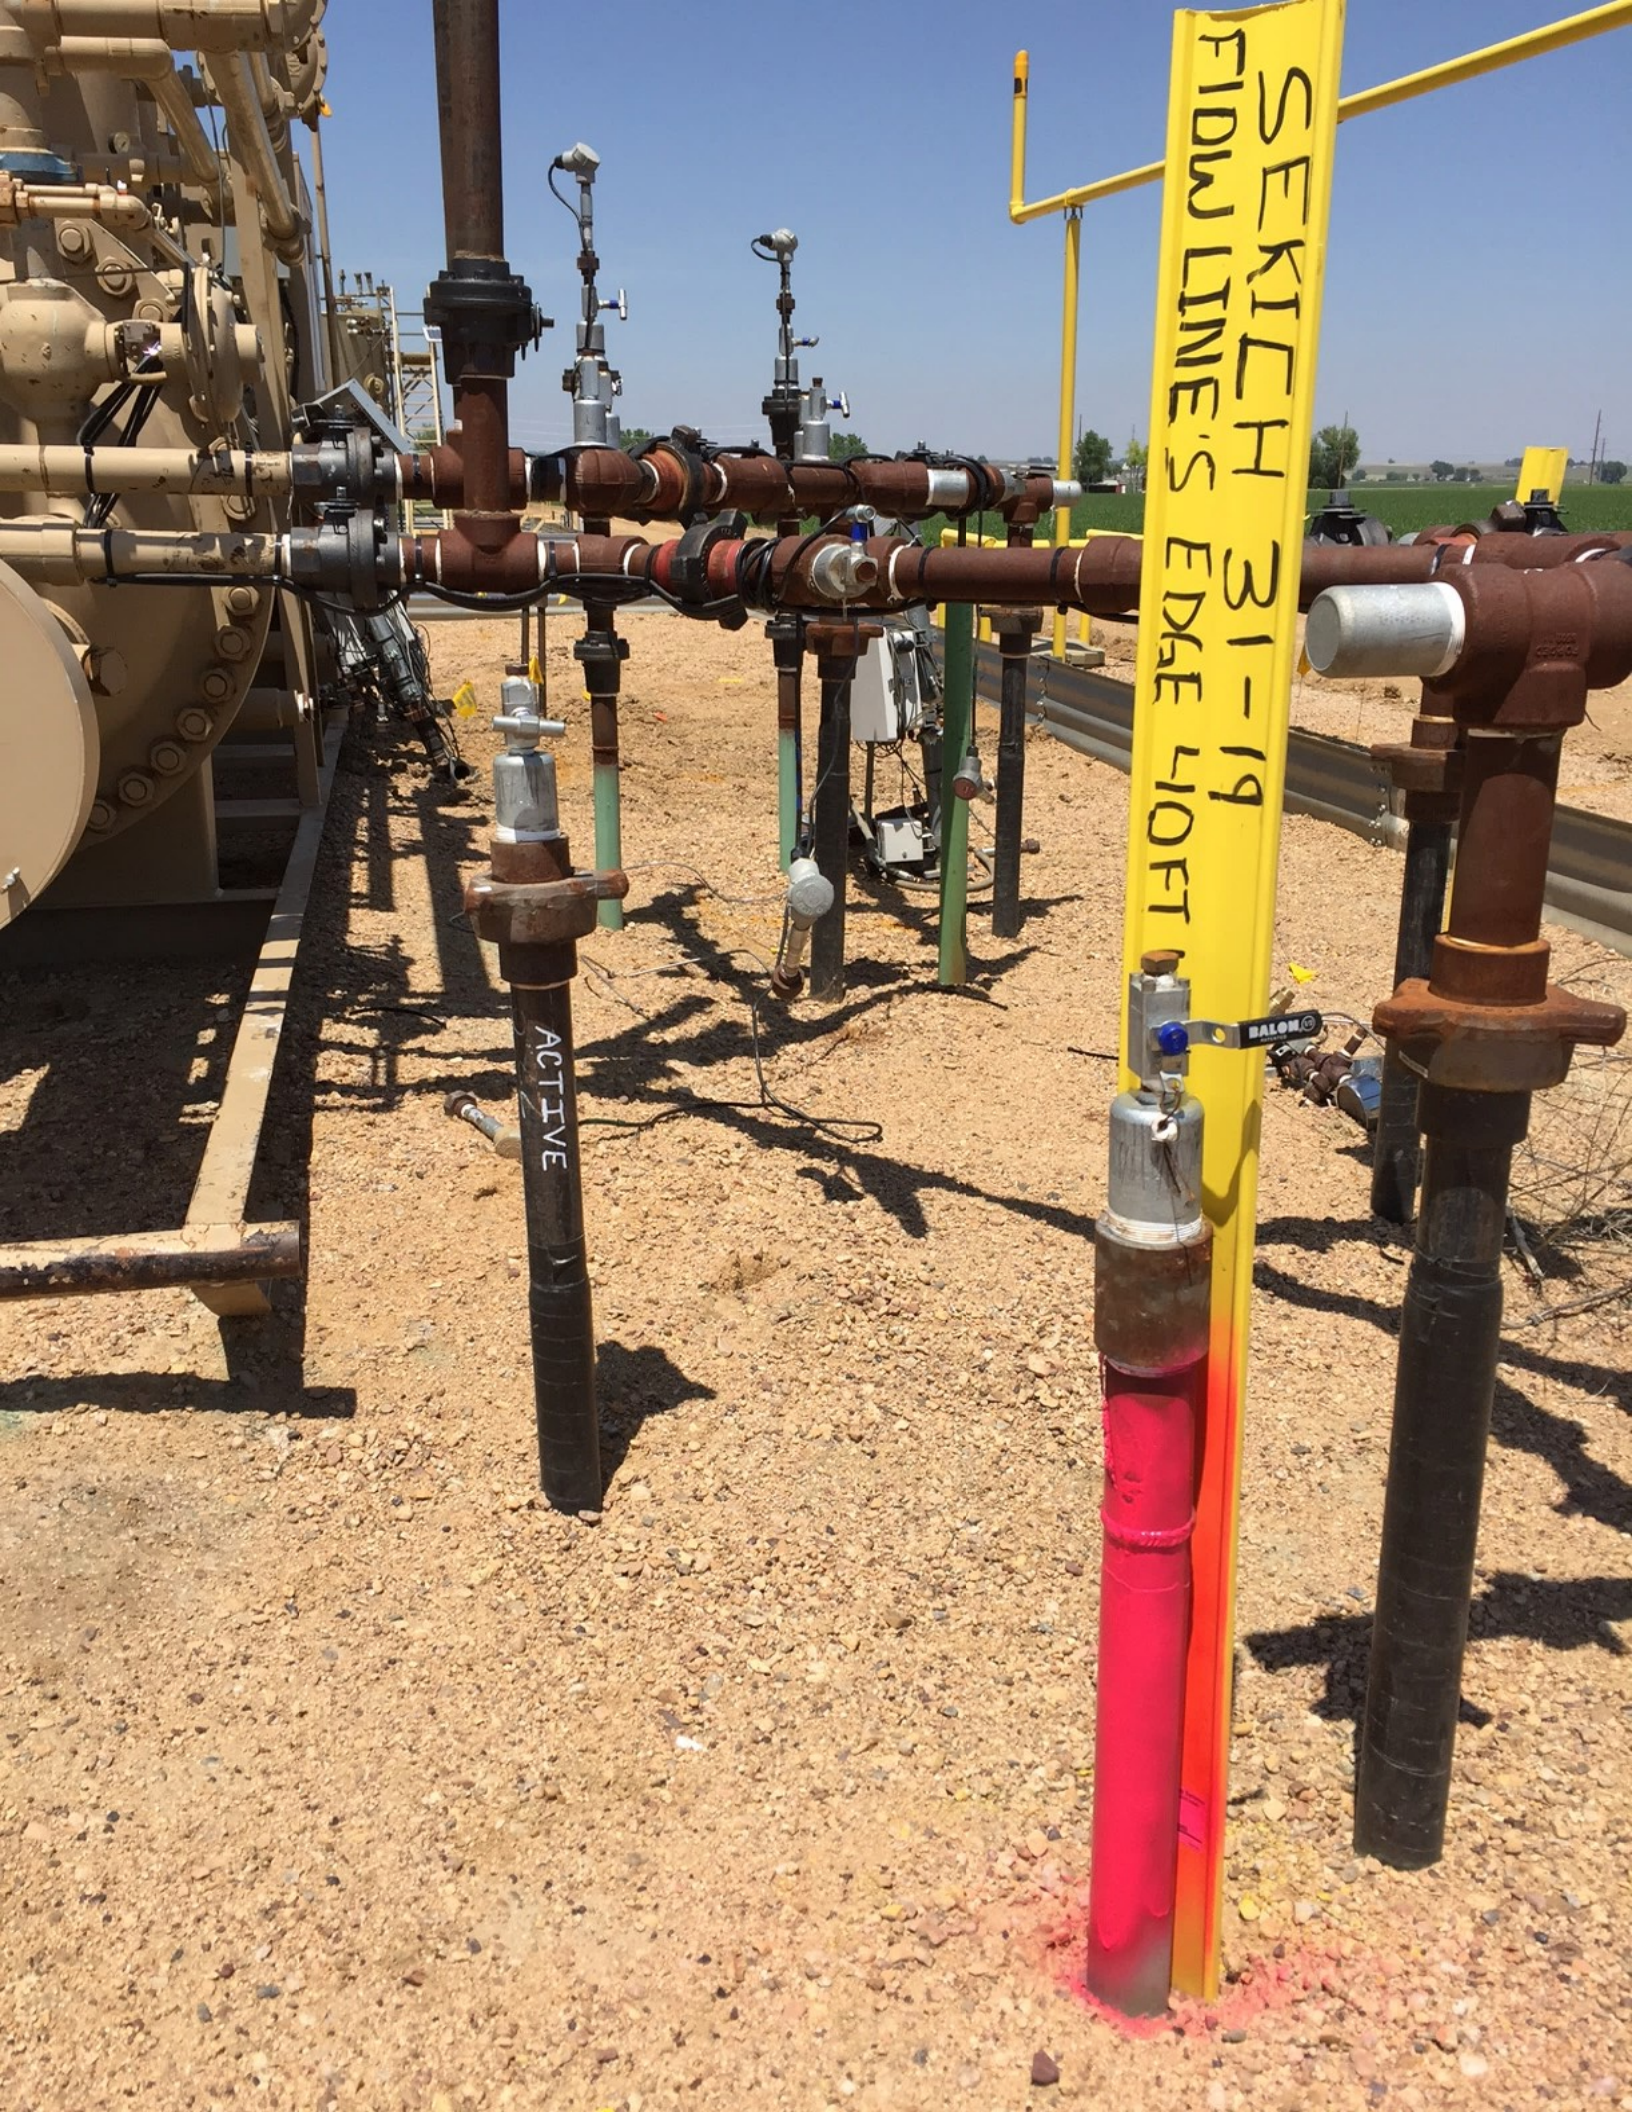

Flow line left
H5R-Sekich 6-19

ACTIVE

SEKICH 6-19





SEKICH
5-19

ACTIVE

DANGER
HOT

ACTIVE

DO NOT
REMOVE
THIS TAG
UNLESS
YOU ARE
THE
PERSON
WHOSE
NAME
IS ON
IT