

Wellbore Diagram



<u>Lease &amp; Well No.</u>	<u>McBride State #1</u>
<u>Field Name</u>	<u>Wattenberg</u>
<u>Location</u>	<u>1,140' FSL &amp; 600' FWL; T3N R62W Sec 8</u>

<u>Operator</u>	<u>McBride Inc.</u>
<u>County &amp; State</u>	<u>Weld County, Colorado</u>
<u>API No.</u>	<u>05-123-07360</u>

<u>K.B. Elevation</u>	<u></u>
<u>D.F. Elevation</u>	<u></u>
<u>Ground Level</u>	<u>4,662'</u>

Surface Casing					
<u>Hole Size</u>	<u>12 1/4"</u>	<u>Csg Wt</u>	<u>24.0#</u>	<u>Depth</u>	<u>260'</u>
<u>Csg Size</u>	<u>8 5/8"</u>	<u>Sx. Cmt.</u>	<u>250 sx</u>	<u>TOC @</u>	<u>Surface</u>
Visual					
Intermediate Casing					
<u>Size (OD)</u>	<u>n/a</u>	<u>Weight</u>	<u></u>	<u>Depth</u>	<u></u>
<u>Grade</u>	<u></u>	<u>Sx. Cmt.</u>	<u></u>	<u>TOC @</u>	<u></u>
Production Casing					
<u>Hole Size</u>	<u>7 7/8"</u>	<u>Weight</u>	<u>11.6#</u>	<u>Depth</u>	<u>7,008'</u>
<u>Csg Size</u>	<u>4 1/2"</u>	<u>Stg 1 Sx. Cmt.</u>	<u>200 sx</u>	<u>TOC @</u>	<u>6,012'</u>
<u>DV Tool</u>	<u></u>	<u>Stg 2 Sx. Cmt.</u>	<u></u>	<u>TOC @</u>	<u></u>
Calc					

Well History  
09/14/71 - Spud well  
09/22/71 - Complete well

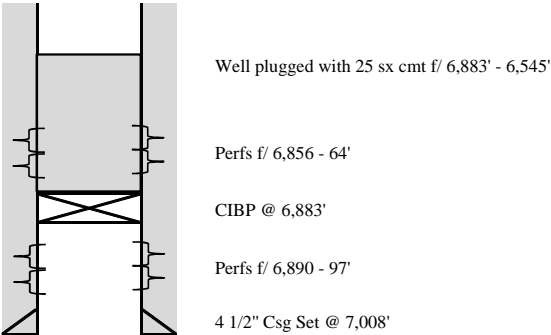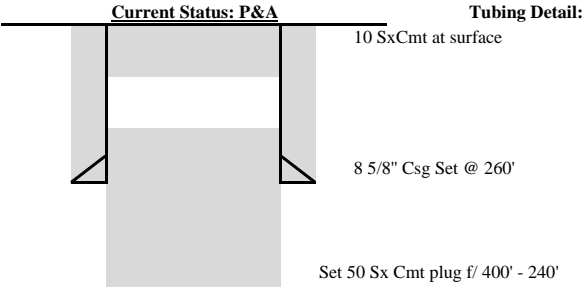

<u>Formation Record</u>	<u>Depth</u>
B/ Fox Hills	440'
Sussex	
Niobrara	6,110'
Niobrara 'B'	
Niobrara 'C'	
Ft Hays	
Codell	
J-Sand	

<u>Plug Back Depth</u>	<u></u>
<u>Total Depth</u>	<u>7,010'</u>